PREPARED FOR:
JOSEPH MADDEN
60 BOARDWALK PL
PARK RIDGE, IL 60068


PLAT OF SURVEY

-OF-

PATHFINDER SURVEYING, INC.
W2888 KRUEGER ROAD UNIT "D"
LAKE GENEVA, WI 53147
(262) 248-8303

LOTS 114, 115, AND 116 OF LAKE GENEVA BEACH, A SUBDIVISION LOCATED IN GOVERNMENT LOT 4 IN THE SOUTHWEST 1/4 OF SECTION 11, TOWN 1 NORTH, RANGE 17 EAST, WALWORTH COUNTY, WISCONSIN

RECEIVED
JUN 10 2010
By

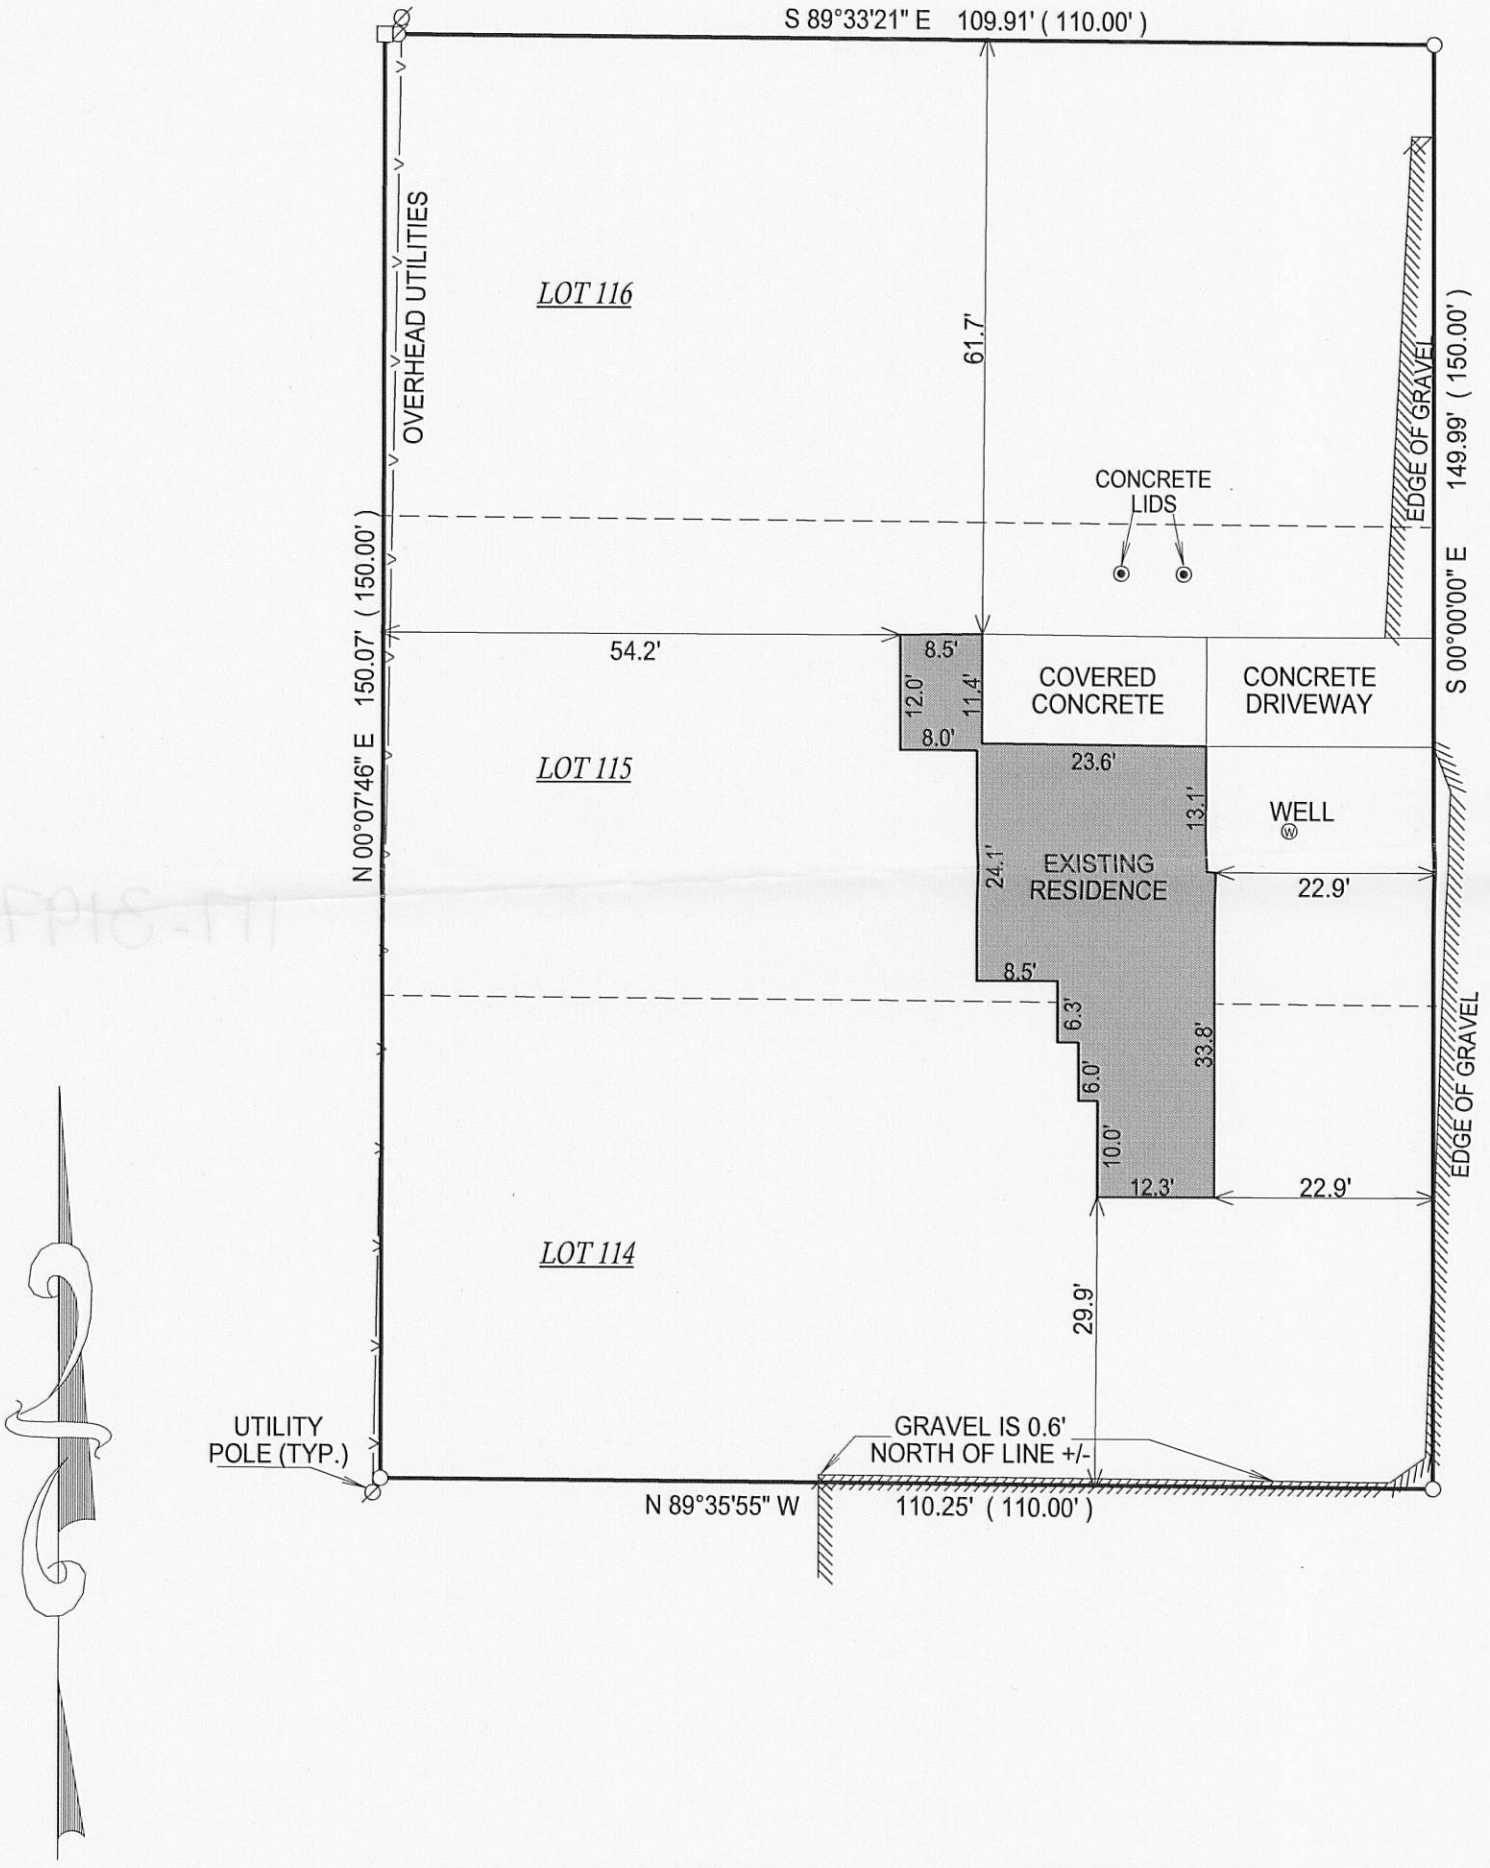

20 0 20 40 60

NOTE: BASIS OF BEARING IS EAST BEACH DRIVE ASSUMED TO RUN NORTH-SOUTH.

( ) = RECORDED AS
□ = FOUND IRON BAR
○ = FOUND IRON PIPE
■ = SET IRON BAR
● = SET IRON PIPE
SCALE: 1" = 20'
JOB #: 09-051
TAX ID #: ILGB 00104

COMPARE LEGAL DESCRIPTION ABOVE AND DRAWING WITH DEED. FOR BUILDING RESTRICTIONS AND EASEMENTS NOT SHOWN,REFER TO DEED, ABSTRACT SOURCES AND LOCAL MUNICIPAL CODES. NOTIFY THE SURVEYOR IMMEDIATELY OF ANY DISCREPANCY.

"I hereby certify that the above described property was surveyed under my supervision and that the above map, to the best of my knowledge and belief, is a true representation thereof and shows the size and location of all visible structures, apparent easements and encroachments if any."
This survey is made for the present owners of the property, and those who purchase, mortgage, or guarentee the title thereto, within one year from the date hereof.

WISCONSIN JEFFREY L. KIMPS 2436 LAKE GENEVA. WIS. LAND SURVEYOR

JEFFREY L. KIMPS S - 2436
Wisconsin Registered Land Surveyor
(original if signed in red)
DATED THE 6th, DAY OF JULY, 2009.