
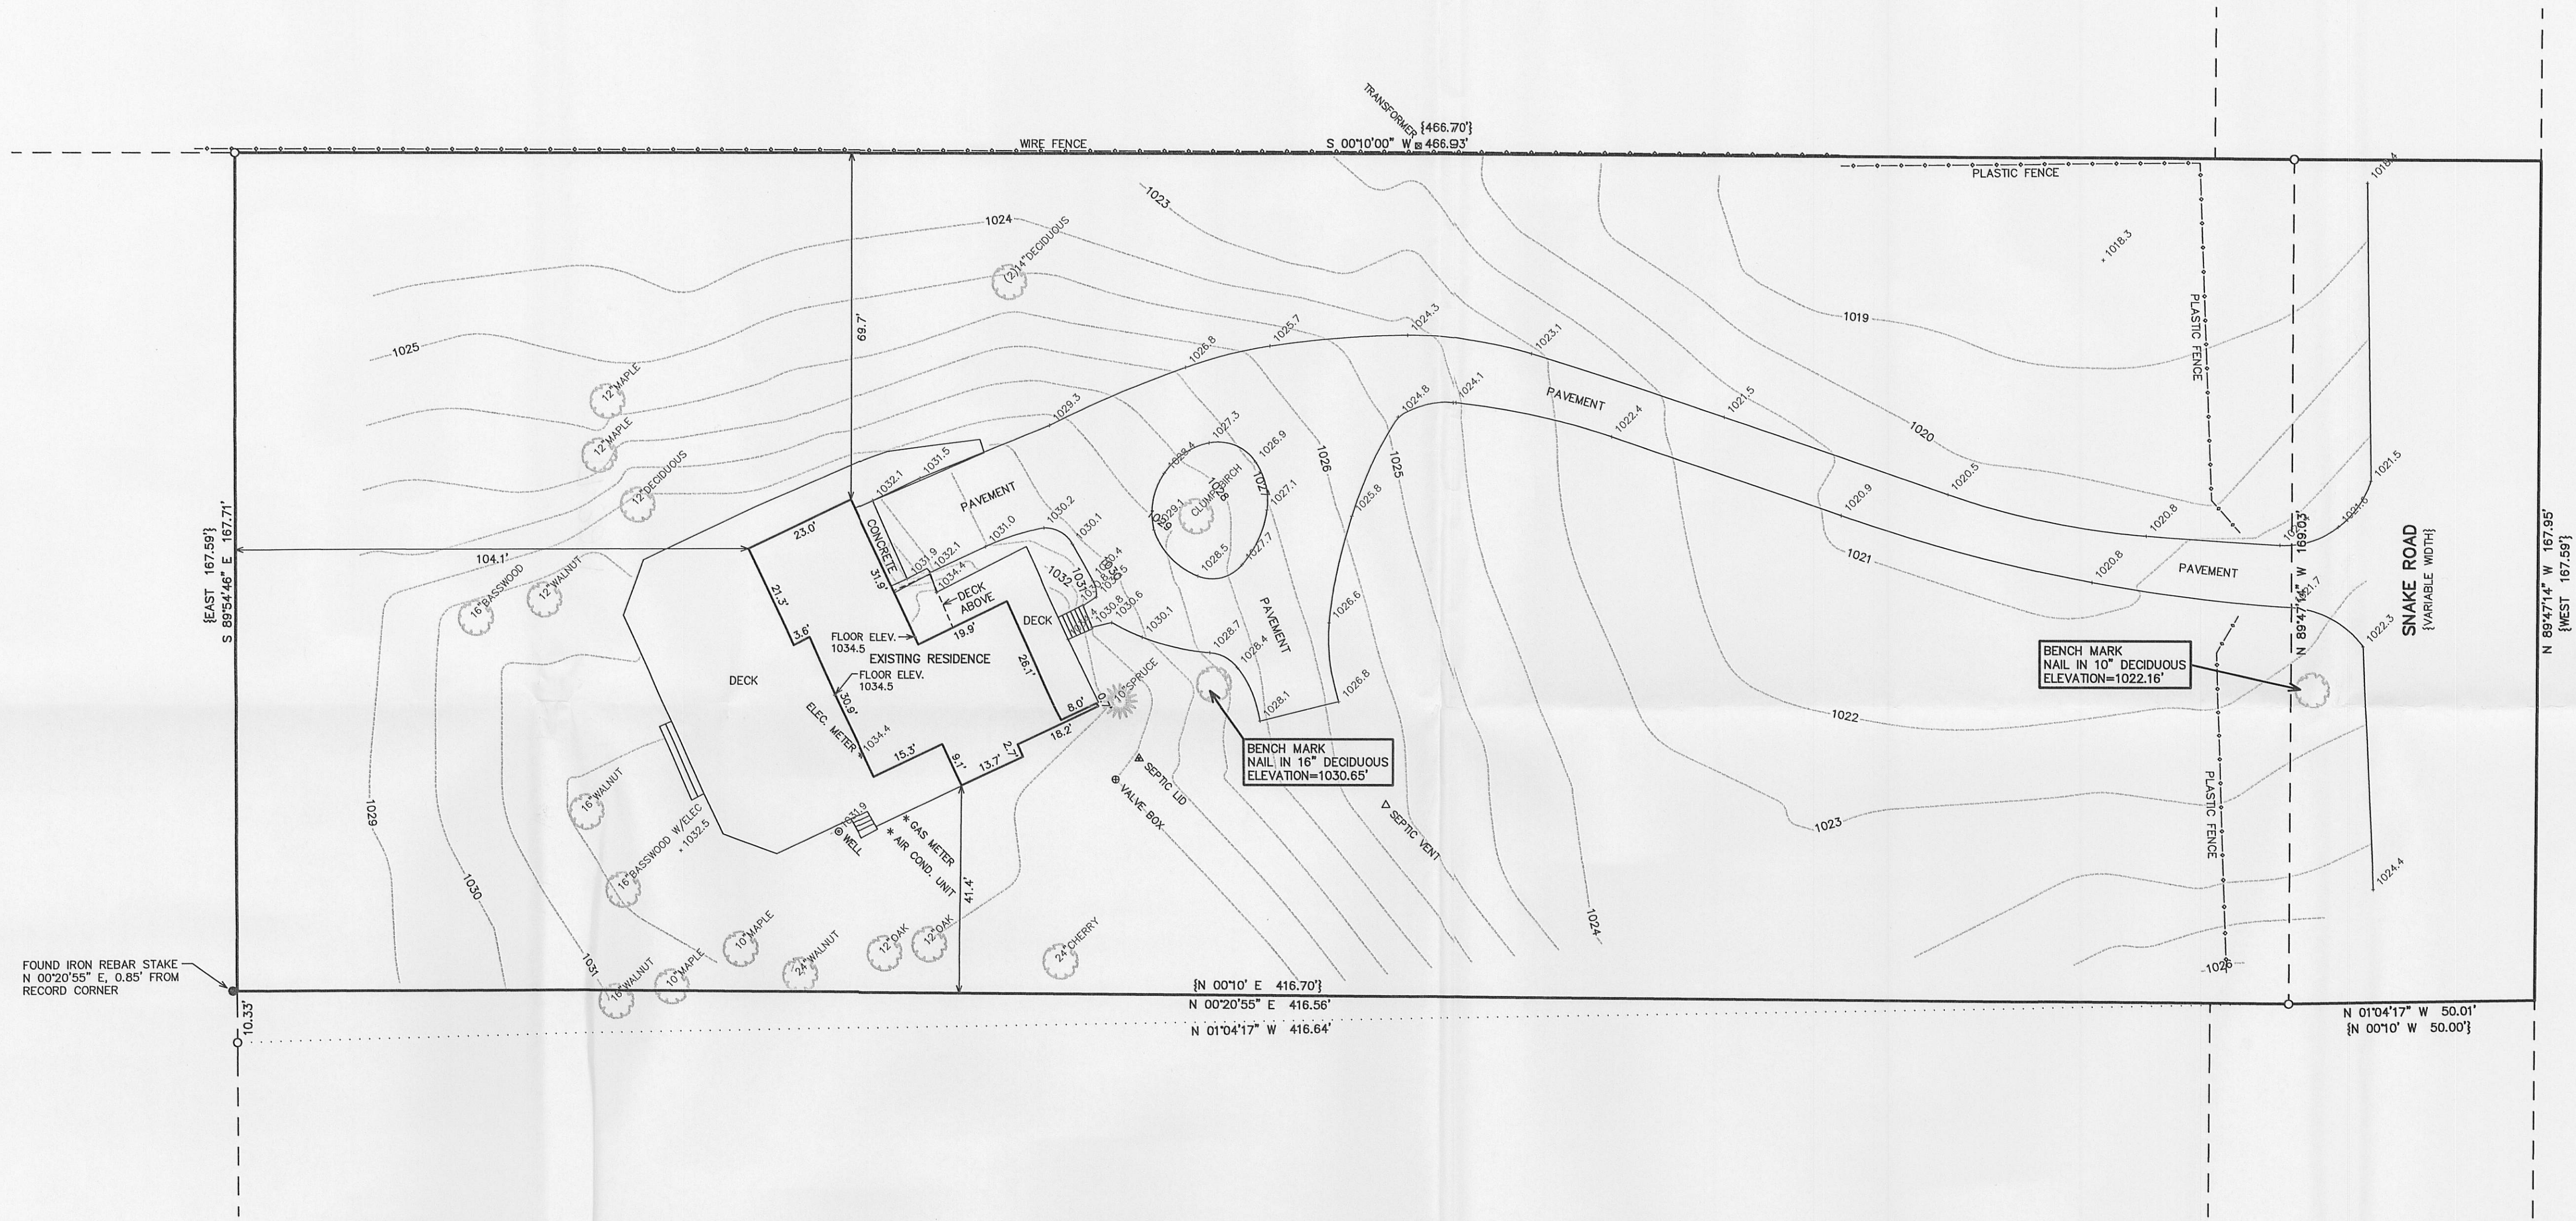


PLAT OF SURVEY & TOPOGRAPHIC MAPPING

LOT 2 OF CERTIFIED SURVEY MAP NO. 194

LOCATED IN PART OF THE NW 1/4 OF THE NW 1/4 OF SECTION 3,
TOWN 1 NORTH, RANGE 17 EAST, WALWORTH COUNTY, WISCONSIN



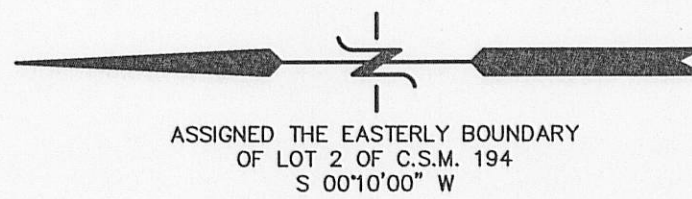


FOUND IRON REBAR STAKE
N 00°20'55\"/>

BENCH MARK
NAIL IN 16\"/>

BENCH MARK
NAIL IN 10\"/>

LEGEND
○ = FOUND IRON PIPE STAKE
● = FOUND IRON REBAR STAKE
{XXX} = RECORDED AS
AREA = 78,590 S.F. 1.80 ACRES
70,167 S.F. 1.61 AC. EXCLUSIVE OF ROAD ROW

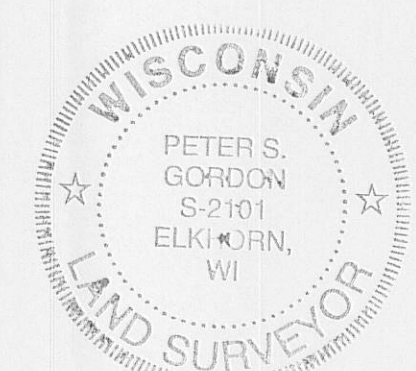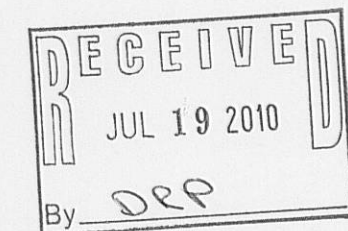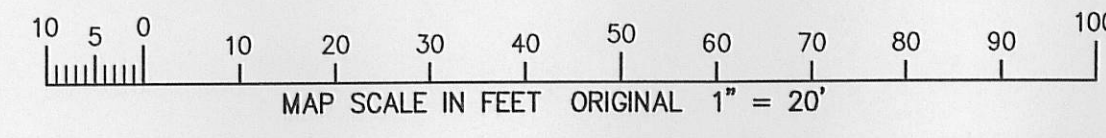


NOTE: COPIES OF THIS MAP TO WHICH THE FOLLOWING CERTIFICATE WILL APPLY SHOW THE SURVEYOR'S ORIGINAL SEAL AND SIGNATURE IN RED INK. COPIES BY ANY OTHER MEANS MAY HAVE ALTERATIONS WHICH DO NOT REPRESENT THE SURVEYOR'S WORK PRODUCT.

I HEREBY CERTIFY THAT THE ABOVE DESCRIBED PROPERTY HAS BEEN SURVEYED UNDER MY DIRECTION AND THAT THE ABOVE MAP IS A TRUE REPRESENTATION THEREOF AND SHOWS THE SIZE AND LOCATION OF THE PROPERTY AND ITS EXTERIOR BOUNDARIES. THIS SURVEY IS MADE FOR THE USE OF THE PRESENT OWNERS OF THE PROPERTY, AND ALSO THOSE WHO PURCHASE, MORTGAGE, OR GUARANTEE THE TITLE THERETO WITHIN ONE YEAR FROM THE DATE HEREOF.

DATED: 7/6/2010

PETER S. GORDON R.L.S. 2101

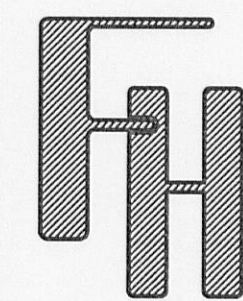

PLAT OF SURVEY &
TOPOGRAPHIC MAPPING
TOWN OF LINN, WALWORTH COUNTY, WISCONSIN

WORK ORDERED BY -
LOWELL MANAGEMENT
P.O. BOX 926
LAKE GENEVA, WI 53147

FARRIS, HANSEN & ASSOCIATES, INC.
ENGINEERING - ARCHITECTURE - SURVEYING
7 RIDGWAY COURT P.O. BOX 437
ELKHORN, WISCONSIN 53121
OFFICE: (262) 723-2098 FAX: (262) 723-5886

REVISIONS

PROJECT NO.
8188
DATE
07/06/2010
SHEET NO.
1 OF 1

7/7/2010 X:\Projects\8188\UCAD\SURV\TOPO

IA 194-2

117-3211