
LAND-MARK SURVEYING
Mark L. Miritz
Wisconsin Registered Land Surveyor S-2582

N9330 Knuteson Drive
Whitewater, WI 53190
Phone:(262)495-3284
FAX : (262) 495-8421
LAND-MARKSURVEYING.COM

PLAT OF SURVEY

LOT 6 AND THE SOUTH 20 FEET OF LOT 7, BLOCK "B", CISCO BEACH SUBDIVIION, LOCATED IN SECTION 5, TOWN 1 NORTH, RANGE 17 EAST, LINN TOWNSHIP, WALWORTH COUNTY, WISCONSIN.

OWNER: MARY J. DOLAN TRUST
MARY J. DOLAN, TRUSTEE
36 CUMBERLAND DRIVE
LINCOLNSHIRE, IL 60069

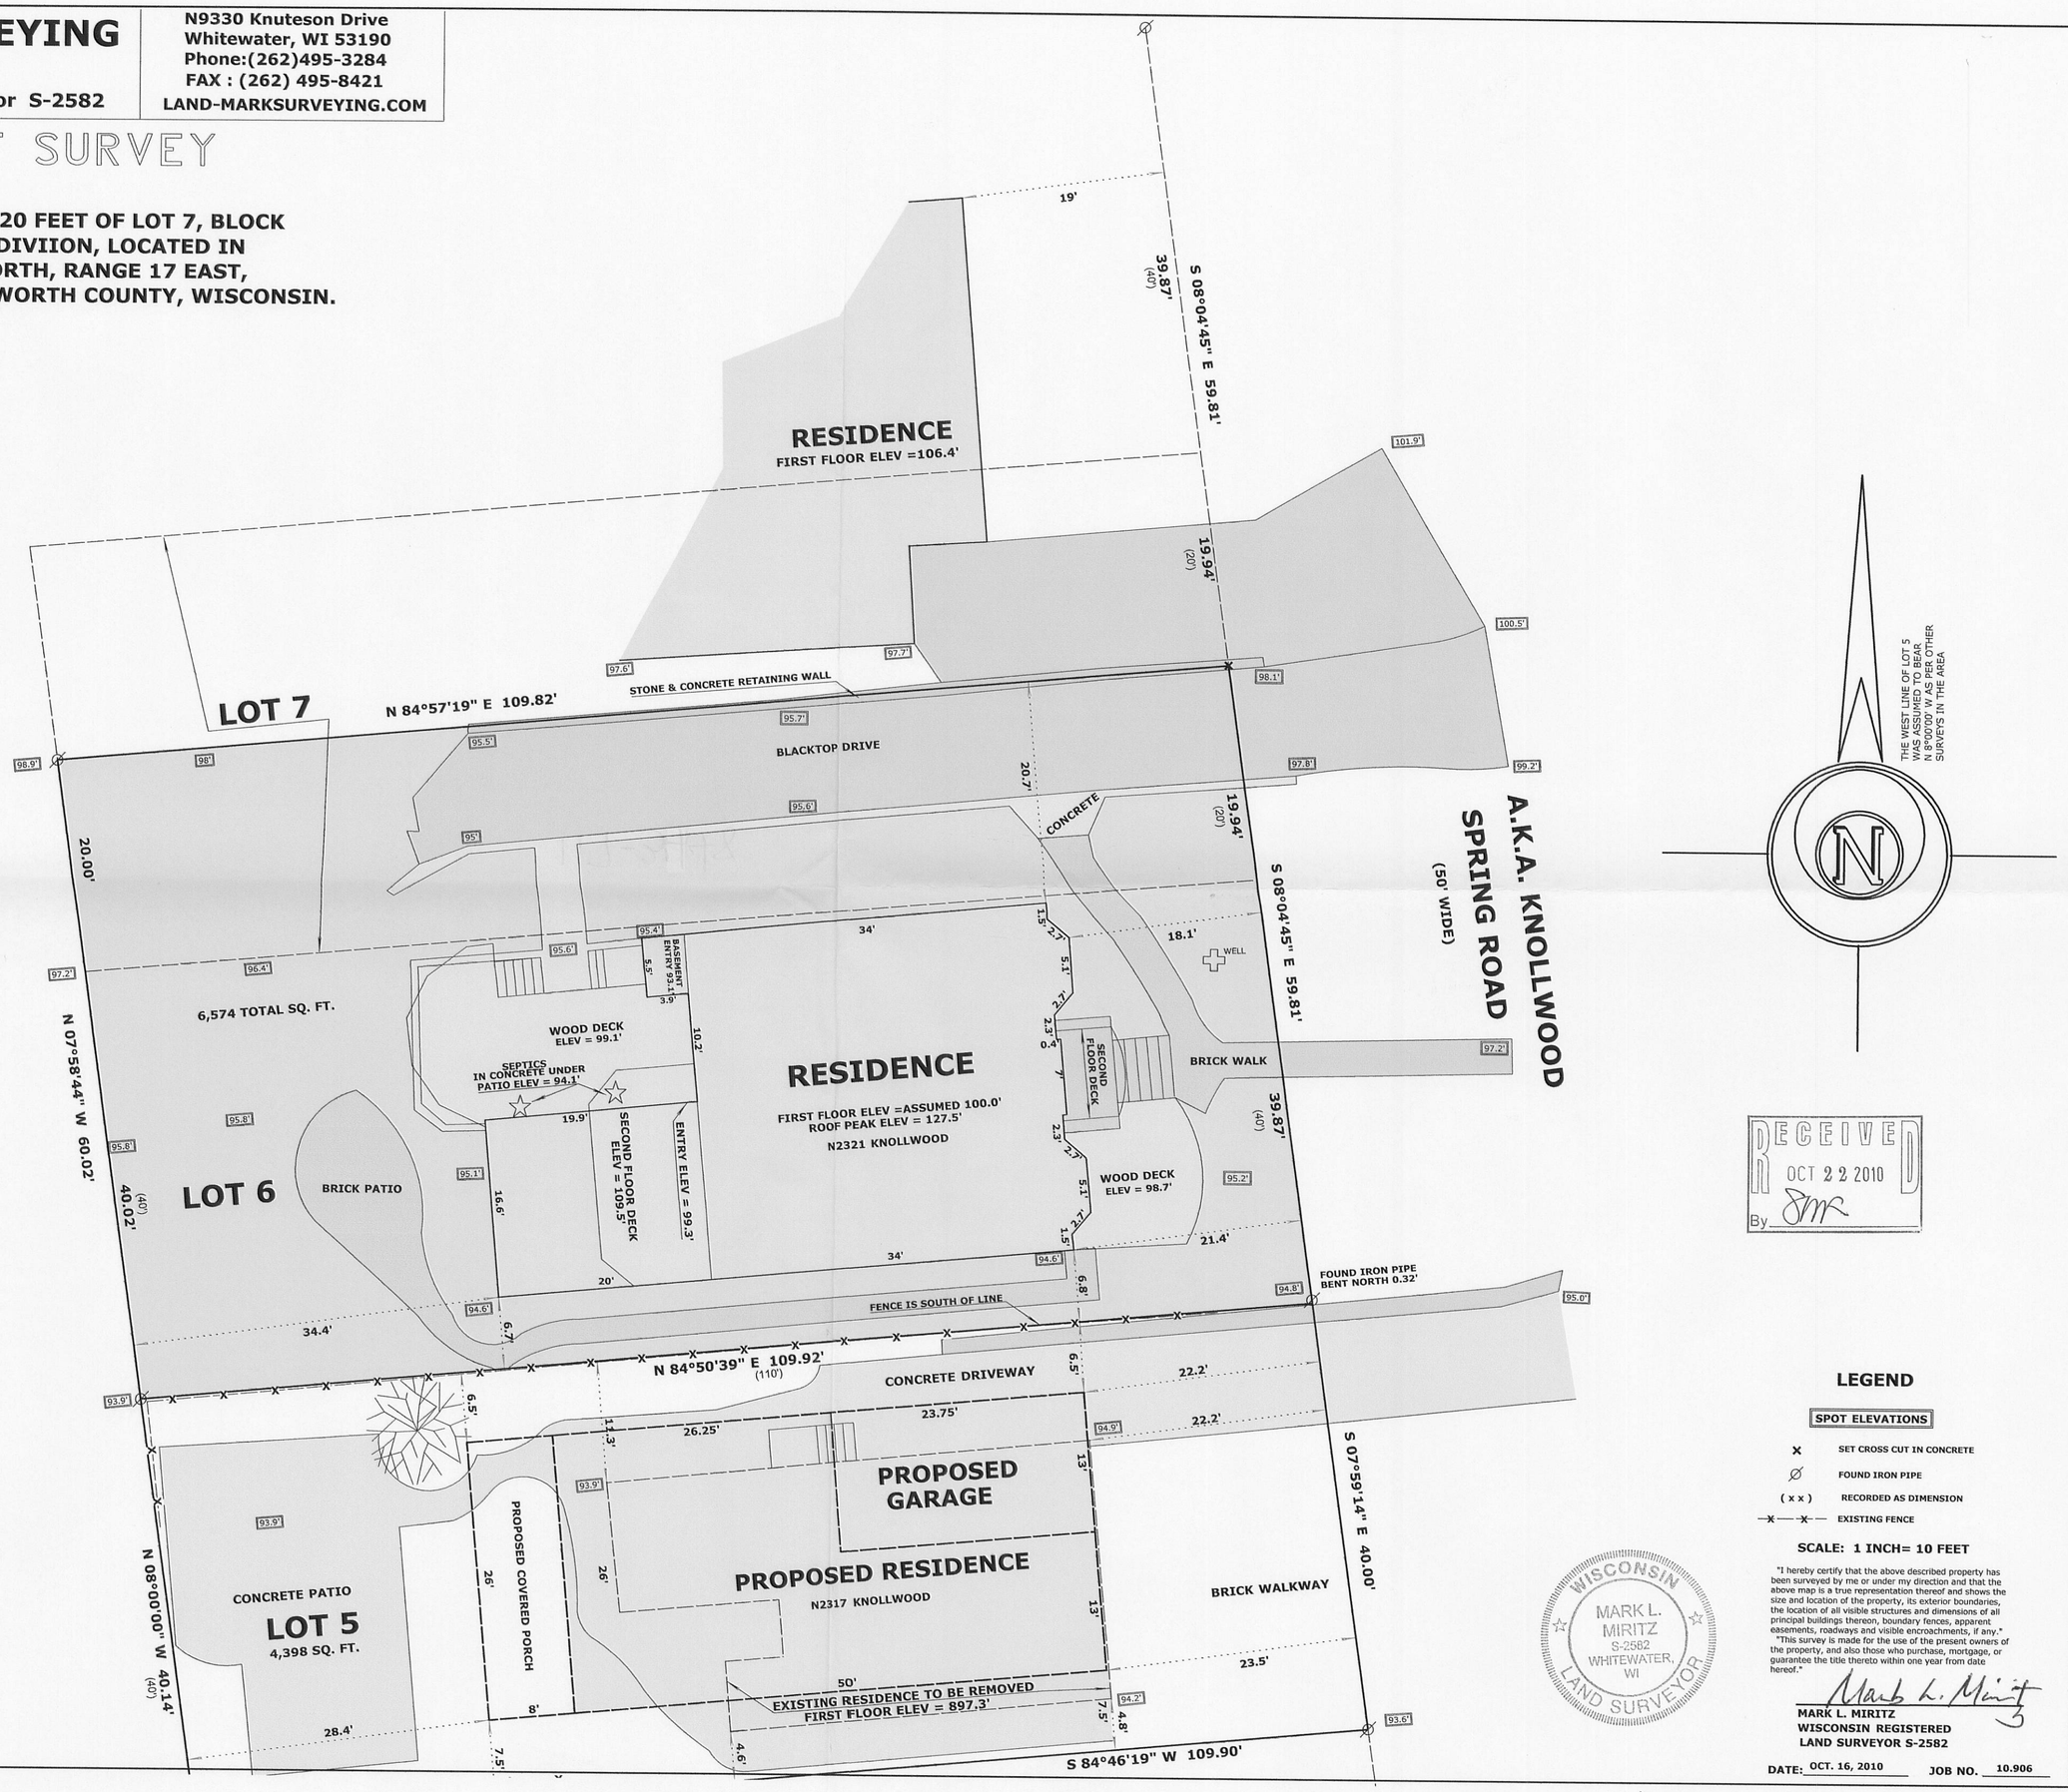

THE WEST LINE OF LOT 5 WAS ASSUMED TO BEAR N 8°00'00" W AS PER OTHER SURVEYS IN THE AREA

RECEIVED
OCT 22 2010
By

LEGEND

SPOT ELEVATIONS

- × SET CROSS CUT IN CONCRETE
- ⌀ FOUND IRON PIPE
- (x x) RECORDED AS DIMENSION
- —x—x— EXISTING FENCE

SCALE: 1 INCH= 10 FEET

"I hereby certify that the above described property has been surveyed by me or under my direction and that the above map is a true representation thereof and shows the size and location of the property, its exterior boundaries, the location of all visible structures and dimensions of all principal buildings thereon, boundary fences, apparent easements, roadways and visible encroachments, if any."
"This survey is made for the use of the present owners of the property, and also those who purchase, mortgage, or guarantee the title thereto within one year from date hereof."

WISCONSIN MARK L. MIRITZ S-2582 WHITEWATER, WI LAND SURVEYOR

MARK L. MIRITZ
WISCONSIN REGISTERED
LAND SURVEYOR S-2582

DATE: OCT. 16, 2010 JOB NO. 10.906