PREPARED FOR
LYNDA TRESTER
COLDWELL BANKER PRIMUS
226 BROAD ST.
LAKE GENEVA WI. 53147


# PLAT OF SURVEY

-OF-

LOT 18 IN SHORE HAVEN SUBDIVISION, SITUATED WITHIN A PARCEL OF LAND KNOWN AS LOT NO. 2, IN SECTION 18, TOWN 1 NORTH, RANGE 17 EAST, ACCORDING TO THE PLAT THEREOF RECORDED IN THE OFFICE OF THE REGISTER OF DEEDS FOR WALWORTH COUNTY, WISCONSIN.

KROTT SURVEYING INC.
N3705 WILLOW BEND LANE
LAKE GENEVA WI. 53147
PHONE # (262)248-3697
FAX # (262)249-0639

SHORE HAVEN DRIVE
(40' WIDE PLATTED AS HAVEN PARKWAY)

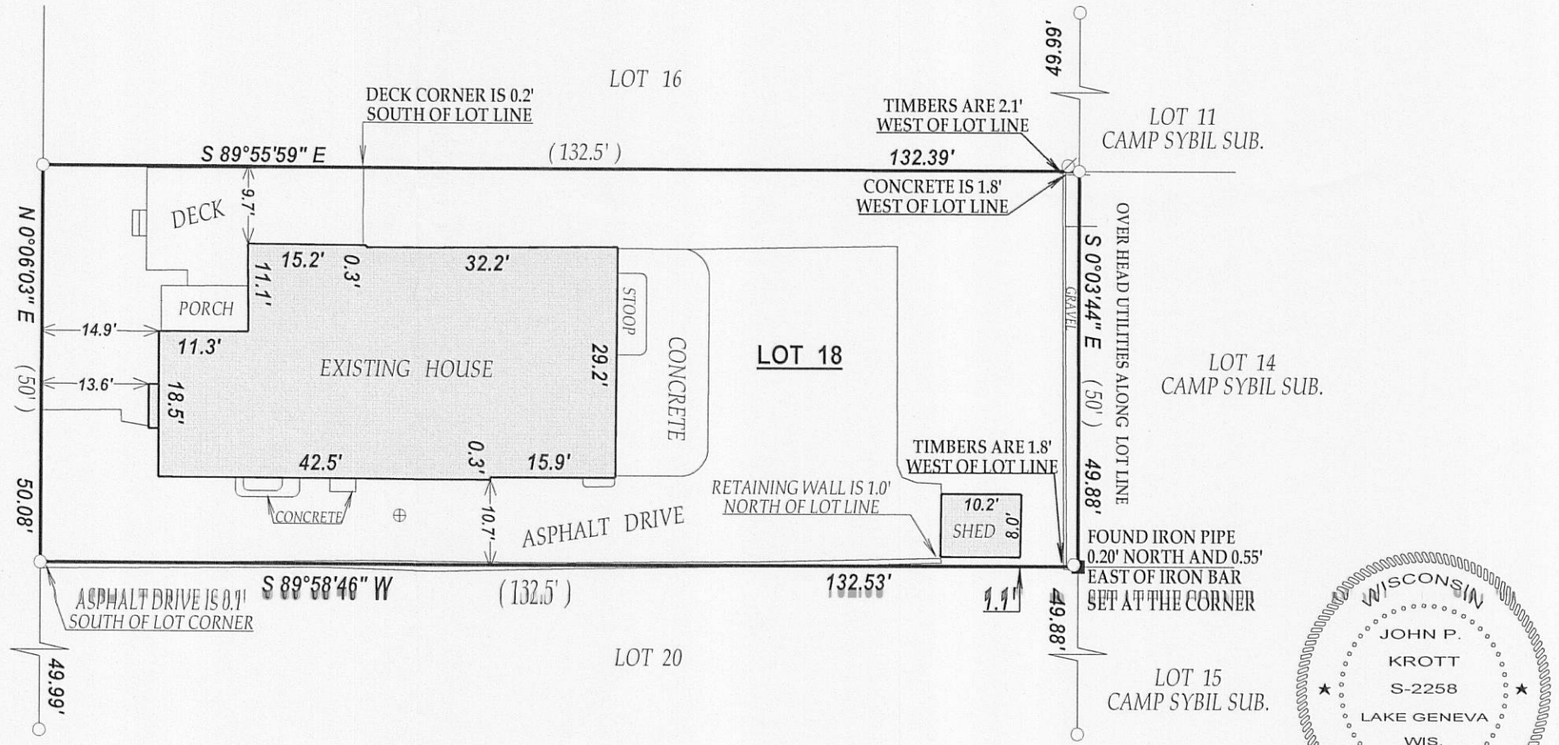


WISCONSIN
JOHN P. KROTT
S-2258
LAKE GENEVA WIS.
LAND SURVEYOR

LEGEND

- ○ FOUND IRON PIPE
- ■ SET IRON BAR
- ⊕ CONCRETE LID
- ⌀ UTILITY POLE
- (XX) RECORDED AS

TAX ID # ISA00017

JOB # 11-096

RECEIVED
JUL - 6 2011
By SMF

I have surveyed the above-described property and the above map is a true representation thereof and shows the size and location of the property, its exterior boundaries, the location and dimensions of all structures thereon, fences apparent easements and roadways and visible encroachments. if any.

This survey is made for the exclusive use of the present owners of the property, and also those who puchase, mortgage,or insure the title therto within one (1) year from date hereof; and as to them I warrant the accuracy of said survey map.

NOTE : BEARINGS ARE REFRENCED TO PREVIOUS SURVEYS OF RECORD

N W E S

SCALE 1"=20'

0 20 40 60 80

DATED THIS 27th DAY OF JUNE 2011.

JOHN KROTT S - 2258
Wisconsin Registered Land Surveyor
( original if signed in red )

ISA-17

117-3305