
PREPARED FOR
AMBER BOUCHEZ
W3664 GLENMORE AVE.
LAKE GENEVA, WI 53147

KROTT SURVEYING INC.
N3705 WILLOW BEND LANE
LAKE GENEVA WI. 53147
PHONE # (262)248-3697
FAX # (262)249-0639

PLAT OF SURVEY

-OF-

LOTS FOUR (4) AND FIVE (5) IN BLOCK THREE (3) IN LAWRENCE'S ADDITION TO GENEVISTA, BEING A SUBDIVISION OF THE SOUTH 572 FEET OF THE SOUTH WEST 0NE-QUATER (1/4) OF THE SOUTH WEST ONE-QUARTER (1/4) OF SECTION TEN (10) IN TOWNSHIP ONE (1) NORTH, RANGE SEVENTEEN (17) EAST , IN THE TOWN OF LINN, WALWORTH COUNTY , WISCONSIN.

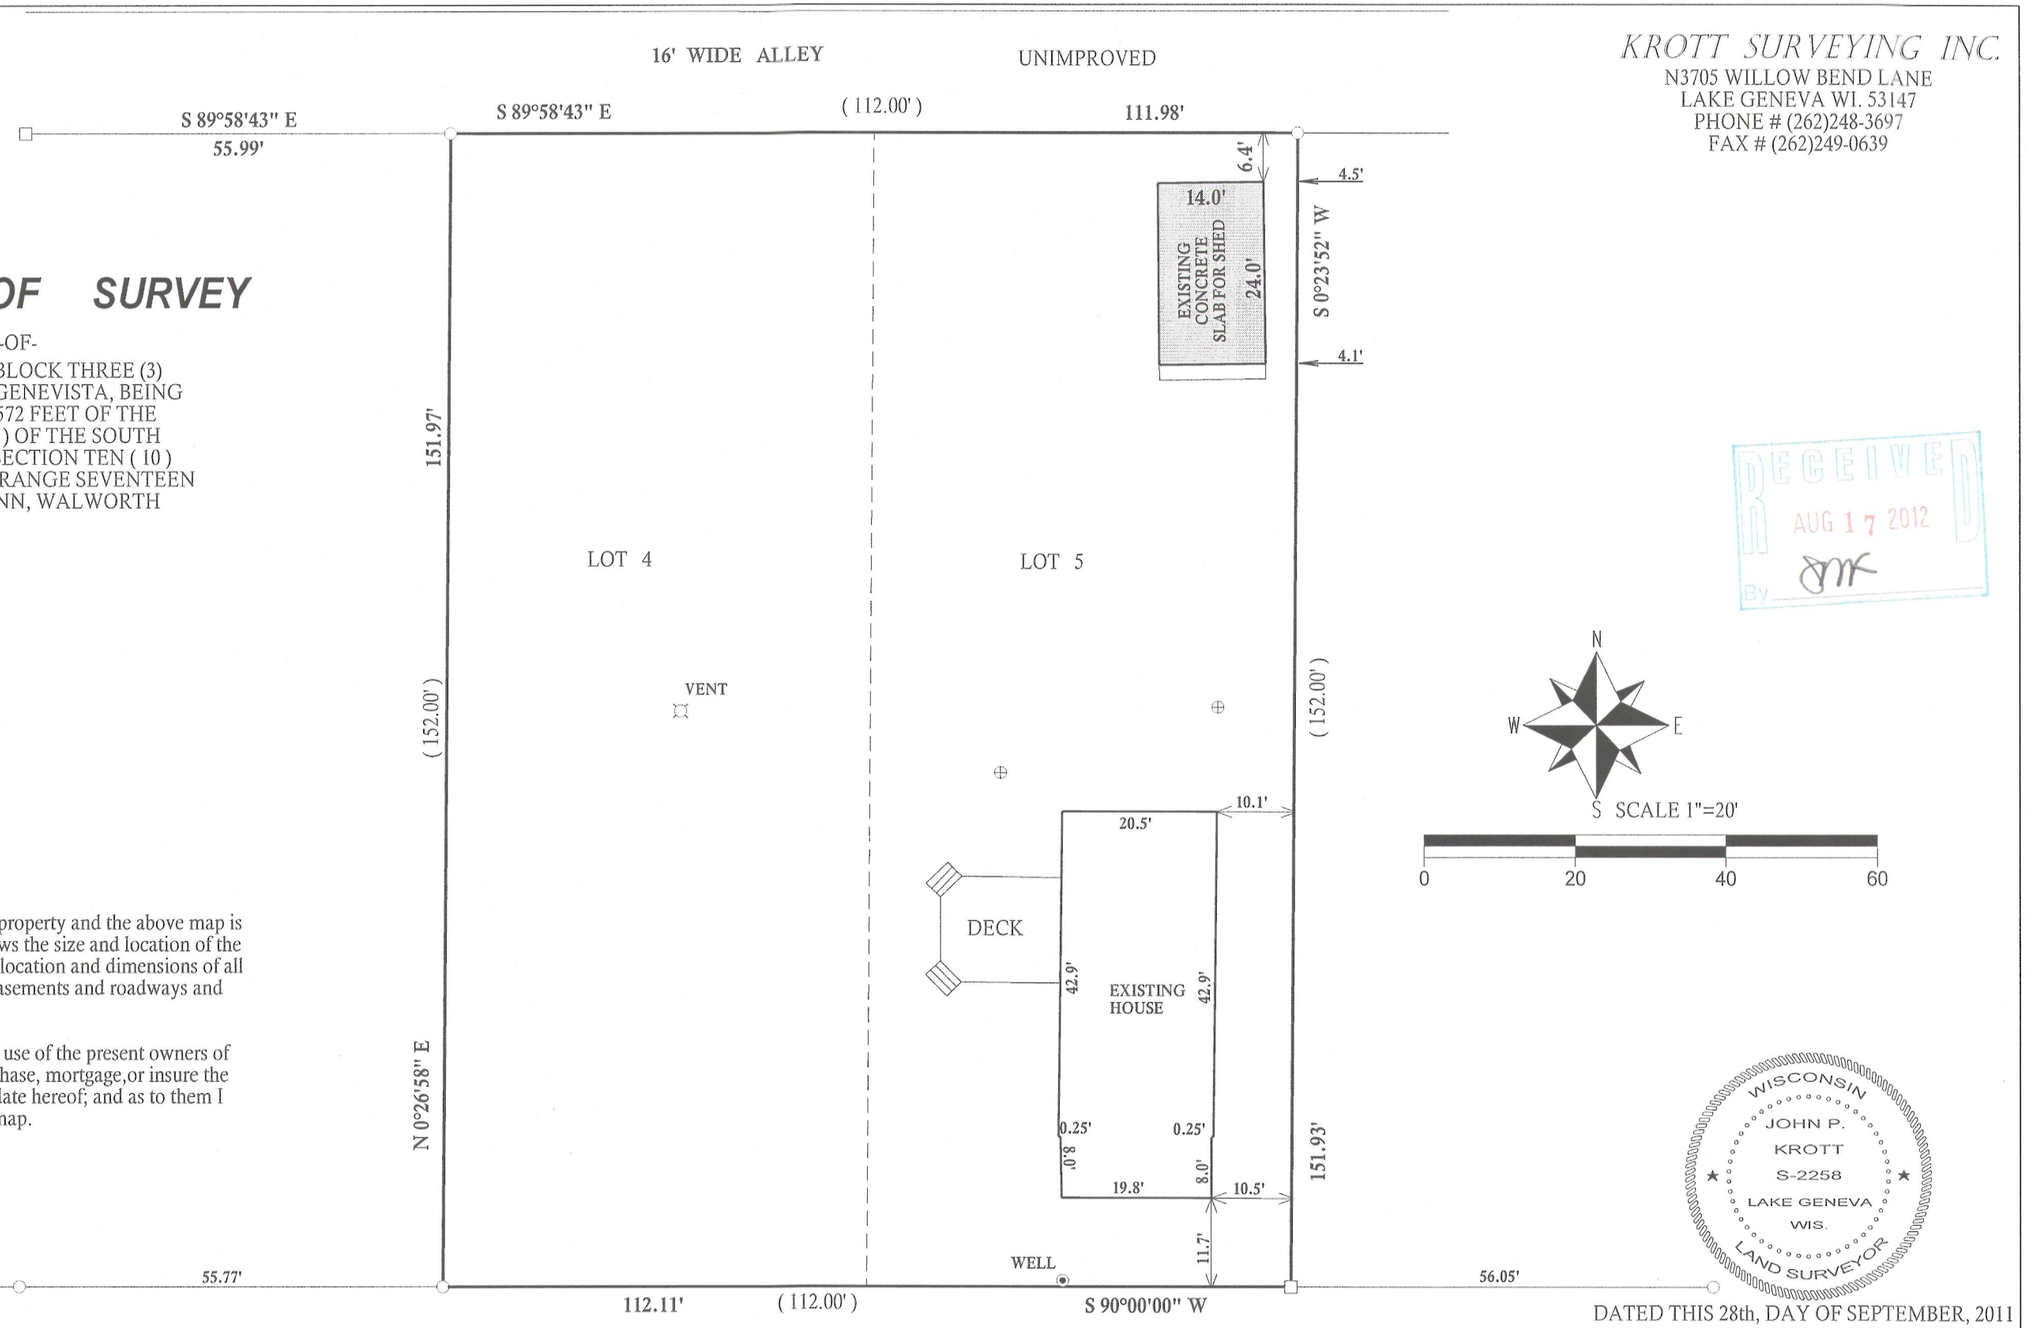

RECEIVED
AUG 17 2012
By

I have surveyed the above-described property and the above map is a true representation thereof and shows the size and location of the property, its exterior boundaries, the location and dimensions of all structures thereon, fences apparent easements and roadways and visible encroachments. if any.

This survey is made for the exclusive use of the present owners of the property, and also those who puchase, mortgage,or insure the title therto within one (1) year from date hereof; and as to them I warrant the accuracy of said survey map.

LEGEND

- ○ FOUND IRON PIPE
- □ FOUND IRON BAR
- ■ SET IRON BAR
- (XX) RECORDED AS
- ⊕ CONCRETE ACCESS COVER

WISCONSIN
JOHN P.
KROTT
S-2258
LAKE GENEVA
WIS.
LAND SURVEYOR

DATED THIS 28th, DAY OF SEPTEMBER, 2011
REVISED 05 / 23 / 2012

JOHN KROTT S - 2258
Wisconsin Registered Land Surveyor
(original if signed in red)

JOB #11-140
TAX ID # IGVL00008A

C.L. GLENMORE AVENUE
(50' WIDE)

117-3414