
Plat of Survey

of

Lots 18 and 19 of Lake Geneva Highlands,


a subdivision located in Government Lot 1 in the Southeast 1/4 of Section 8, Town 1 North, Range 17 East, Town of Linn, Walworth County, Wisconsin.

Surveyed for: **Michael Brenner**
696 Sumac Road
Highland Park, Illinois. 60035

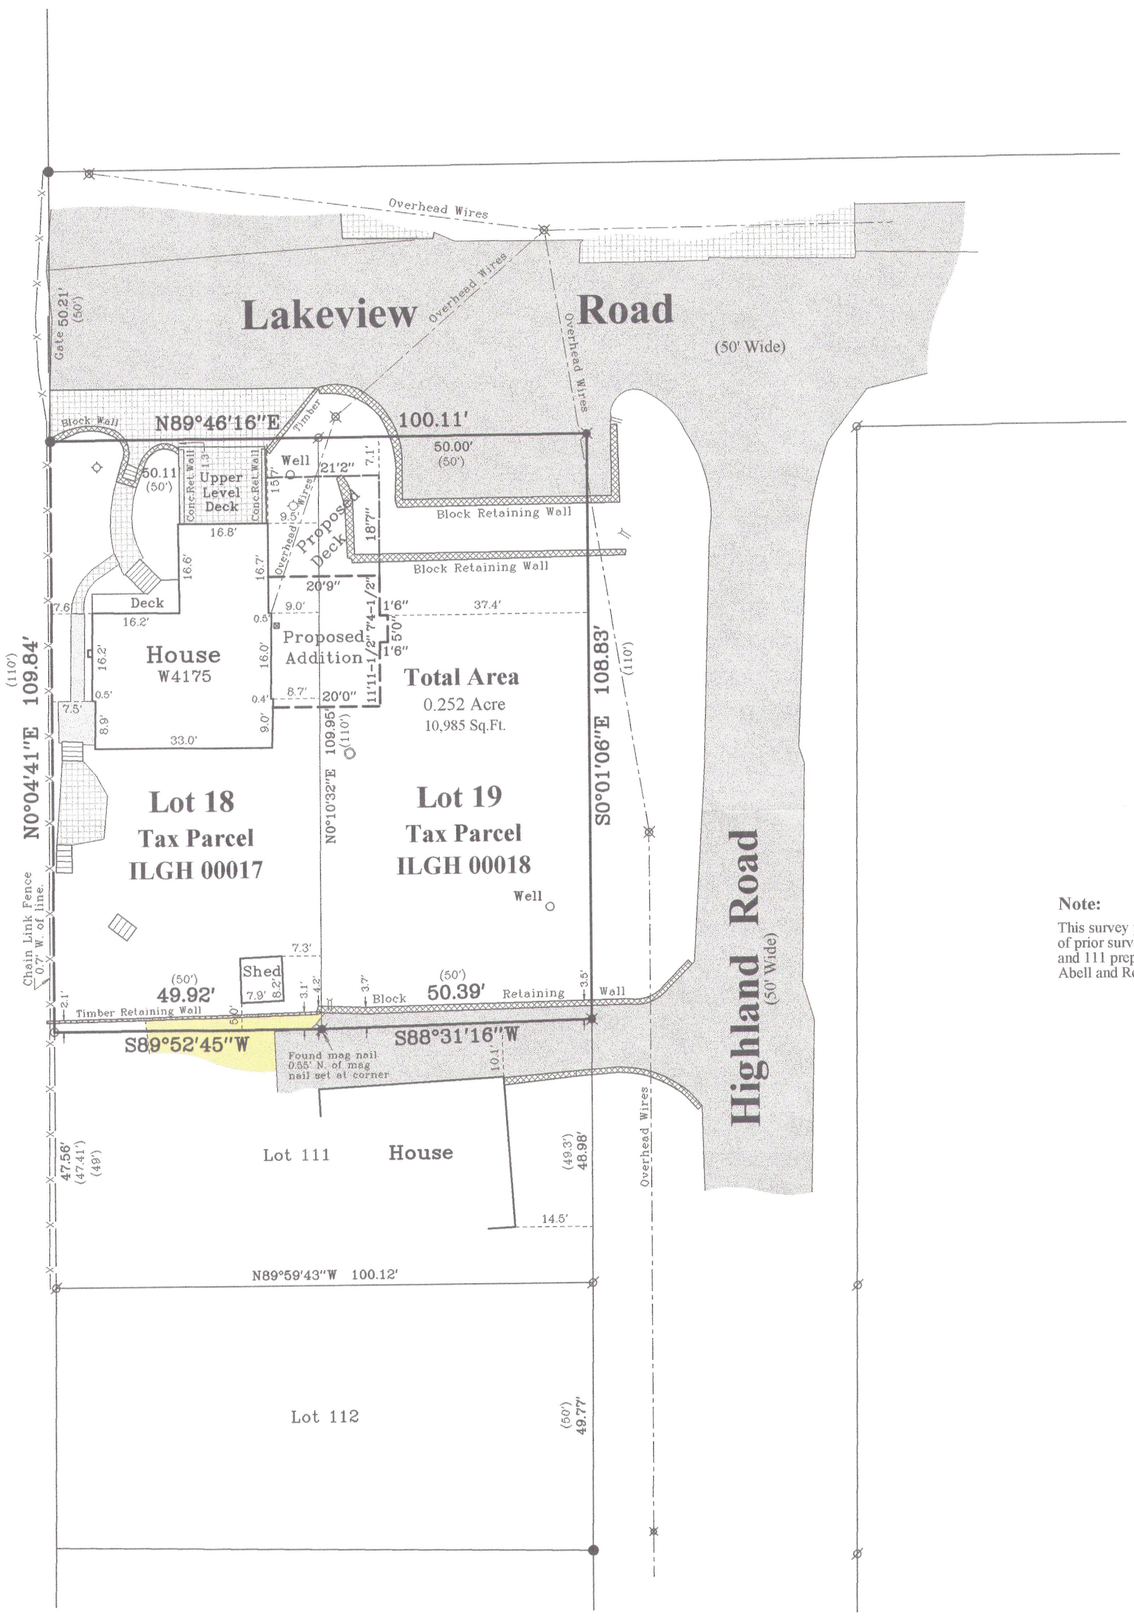

Unit 2
Sills Condominium

Note:
This survey plat is a retracement of prior surveys of Lots 18, 19 and 111 prepared by David F. Abell and Robert M. Barenwald.

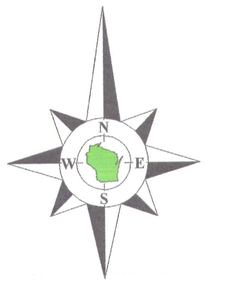

Bearings referenced to previous surveys of record.



Not Certified Unless Stamped in Red.

Notes:

1) This survey plat is not certified unless signed and sealed in red ink.
2) This survey is subject to Wisconsin lien laws. This Plat of Survey is the notice of intent to file lien. Lien waiver required.

Copyright 2012 by Jensen & Olson Land Surveying, LLC.

All rights reserved. No part of this survey plat may be reproduced or transmitted in any form by any means - graphic, electronic, or mechanical, including photocopying, tracing, or information storage and retrieval systems - without permission in writing from Douglas G. Olson, Jensen & Olson Land Surveying, LLC.

I, Douglas G. Olson, Wisconsin Registered Land Surveyor, do hereby certify that this survey was performed by me, or under my direction in full compliance with the owner's/agent's instructions and Chapter A-E 7 of the Wisconsin Administrative Code "Minimum Standards for Property Surveys"; and that this map is an accurate representation thereof to the best of my knowledge and belief.

Douglas G. Olson
Wisconsin Registered Land Surveyor - 2093

RECEIVED
OCT - 1 2012
By SMK

Survey Date: March 14, 2012.
Revisions: No. 1 – Proposed Addition & Deck

Scale in Feet
1" = 20'
0' 10' 20' 40'

Jensen & Olson Land Surveying, LLC
45 South Wisconsin Street * P.O. Box 322 * Elkhorn, Wisconsin. 53121
Telephone: (262) 723-3434 * Facsimile: (262) 723-8044
Email: jensen.olson@elknet.net

Legend
Found Iron Pipe ● Found Iron Rod
Set Iron Pipe, 1" dia. ■ Set Mag Nail
(Record Information)
Utility Pole ○ Concrete Cover
Gas Meter ◇ Septic Vent
Spigot ◇ Pipe Outlet
Asphalt Surface ▨ Brick or Stone
Concrete Surface ▨ Gravel
Retaining Wall

Sheet 1 of 1 Sheets
Drawing Name: I:\ter17e-2012\2014-2012\2014Plat.dwg
Job Reference Number 2012.014
2012.014

IlGH-17 IlGH-18

117 3438