

Plat of Survey



of

Lot 3 of The Lindens,

a subdivision located in the Southeast 1/4 of Section 8, Town 1 North,
Range 17 East, Town of Linn, Walworth County, Wisconsin.


Lot 2
C.S.M. 1617

Surveyed for: **Rick Gulliver**
9046 Willow Ridge Drive
Willow Springs, Illinois. 60480

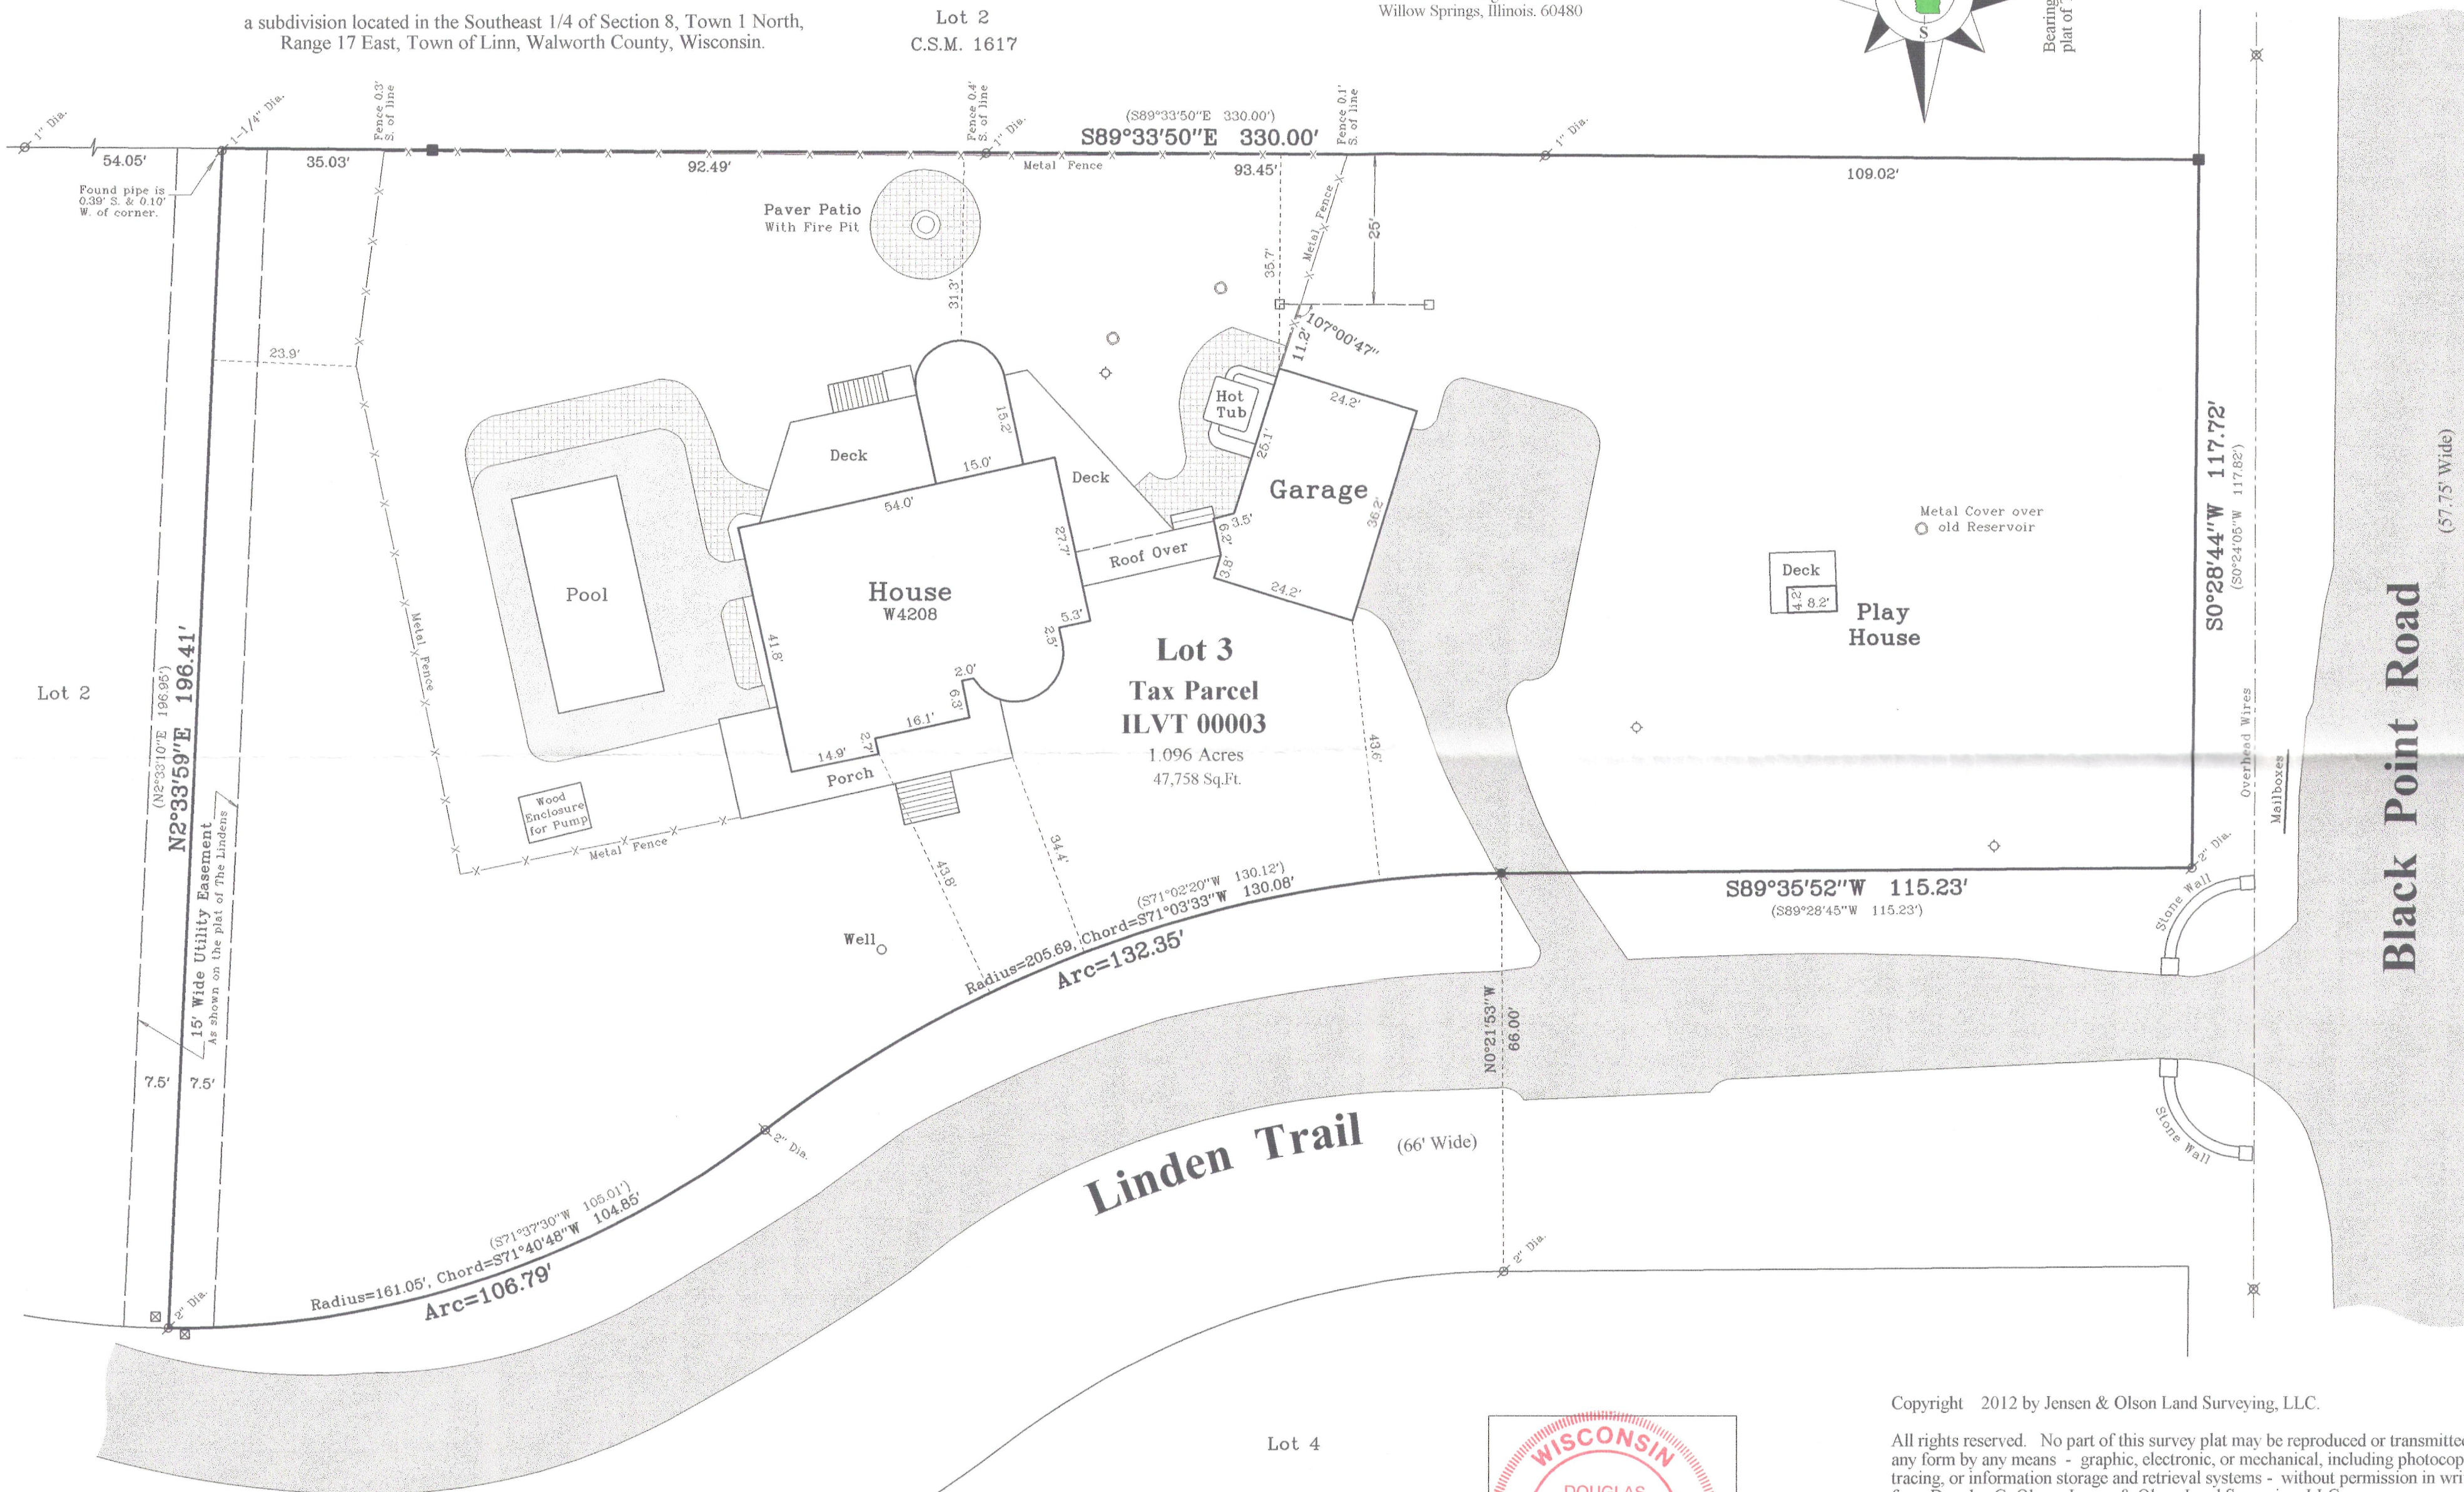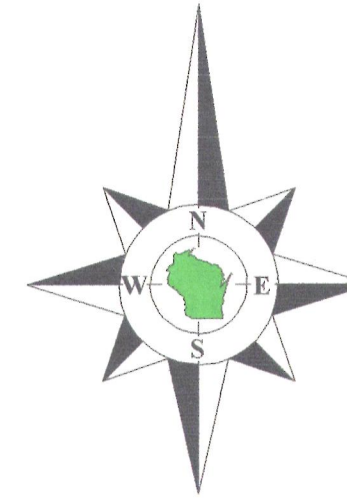

Notes:

- 1) This survey plat is not certified unless signed and sealed in red ink.
- 2) This survey is subject to Wisconsin lien laws. This Plat of Survey is the notice of intent to file lien. Lien waiver required.

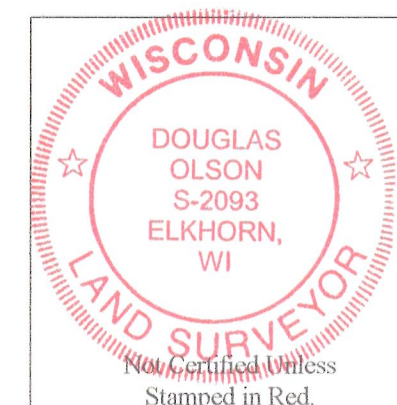

Copyright 2012 by Jensen & Olson Land Surveying, LLC.

All rights reserved. No part of this survey plat may be reproduced or transmitted in any form by any means - graphic, electronic, or mechanical, including photocopying, tracing, or information storage and retrieval systems - without permission in writing from Douglas G. Olson, Jensen & Olson Land Surveying, LLC.

I, Douglas G. Olson, Wisconsin Registered Land Surveyor, do hereby certify that this survey was performed by me, or under my direction in full compliance with the owner's/agent's instructions and Chapter A-E 7 of the Wisconsin Administrative Code "Minimum Standards for Property Surveys"; and that this map is an accurate representation thereof to the best of my knowledge and belief.

Douglas G. Olson
Wisconsin Registered Land Surveyor - 2093

Survey Date: Sept. 8, 2012.
Revisions:

Scale in Feet
1" = 20'

Jensen & Olson Land Surveying, LLC
45 South Wisconsin Street * P.O. Box 322 * Elkhorn, Wisconsin. 53121
Telephone: (262) 723-3434 * Facsimile: (262) 723-8044
Email: jensen.olson@elknet.net

Legend
Found Concrete Monument
Found Iron Pipe
Set Mag. Nail
Set Lath
Set Mag. Information
Utility Pole
Septic Cover
Asphalt Surface
Concrete

Sheet 1 of 1 Sheets
Drawing Name: 117-3449-2012098Plat.sj
Job Reference Number
2012.098

2012.098

ILVT-3

117-3449