LAND-MARK SURVEYING
Mark L. Miritz
Wisconsin Registered Land Surveyor S-2582

N9330 Knuteson Drive
Whitewater, WI 53190
Phone:(262)495-3284
FAX : (262) 495-8421
LAND-MARKSURVEYING.COM

PLAT OF SURVEY

LOTS 10, 11, AND 12, BLOCK 2 OF SUNSET HILLS SUBDIVISION, LOCATED IN SECTION 4, TOWN 1 NORTH, RANGE 17 EAST, LINN TOWNSHIP, WALWORTH COUNTY, WISCONSIN

ORDERED BY: MIKE PFAMMATTER
KEEFE REAL ESTATE
P.O. BOX 460
LAKE GENEVA, WI 53147

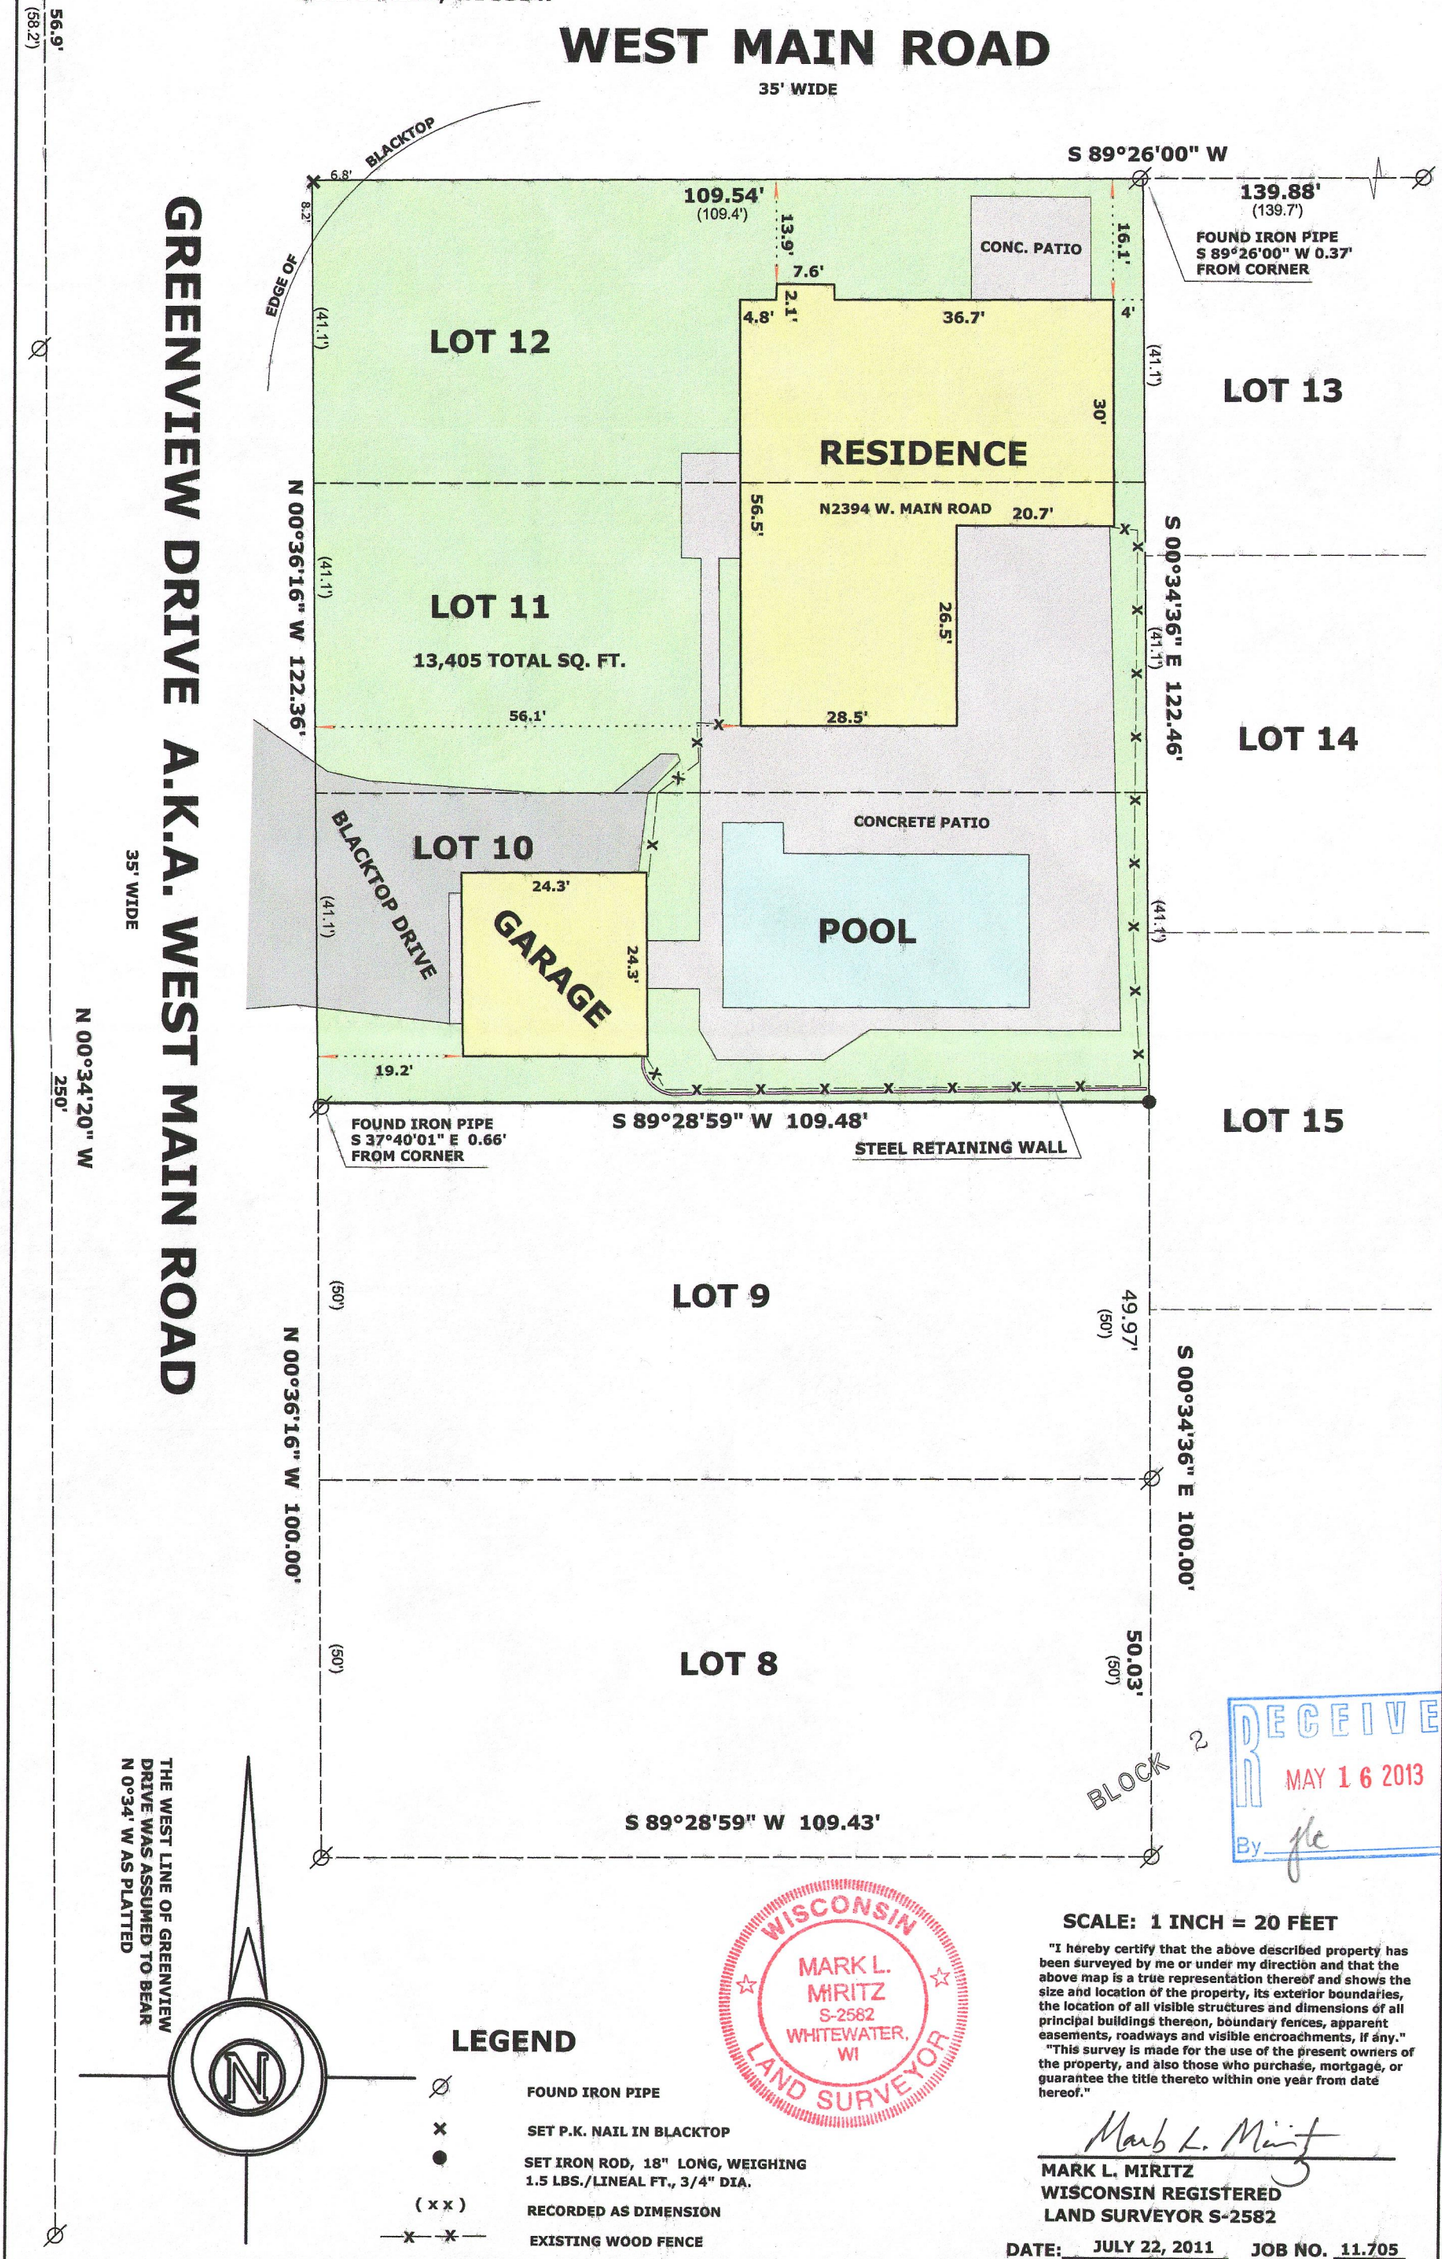

RECEIVED
MAY 16 2013
By fle

WISCONSIN MARK L. MIRITZ S-2582 WHITEWATER, WI LAND SURVEYOR

SCALE: 1 INCH = 20 FEET

"I hereby certify that the above described property has been surveyed by me or under my direction and that the above map is a true representation thereof and shows the size and location of the property, its exterior boundaries, the location of all visible structures and dimensions of all principal buildings thereon, boundary fences, apparent easements, roadways and visible encroachments, if any."
"This survey is made for the use of the present owners of the property, and also those who purchase, mortgage, or guarantee the title thereto within one year from date hereof."

Mark L. Miritz
MARK L. MIRITZ
WISCONSIN REGISTERED
LAND SURVEYOR S-2582

DATE: JULY 22, 2011 JOB NO. 11.705

LEGEND

⌀	FOUND IRON PIPE
×	SET P.K. NAIL IN BLACKTOP
●	SET IRON ROD, 18" LONG, WEIGHING 1.5 LBS./LINEAL FT., 3/4" DIA.
(xx)	RECORDED AS DIMENSION
—x—x—	EXISTING WOOD FENCE

ISH 00020A 117-3527