
PREPARED FOR
TRICIA FORBECK
KEEFE REAL ESTATE\
751 GENEVA PARKWAY
LAKE GENEVA WI. 53147

PLAT OF SURVEY

-OF-

LOTS 8 AND 9 LINNWOOD SUBDIVISION, LOCATED IN SECTION 15, TOWN 1 NORTH, RANGE 17 EAST, WALWORTH COUNTY, WISCONSIN.

KROTT SURVEYING INC.
N3705 WILLOW BEND LANE
LAKE GENEVA WI. 53147
PHONE # (262)248-3697
FAX # (262)249-0639

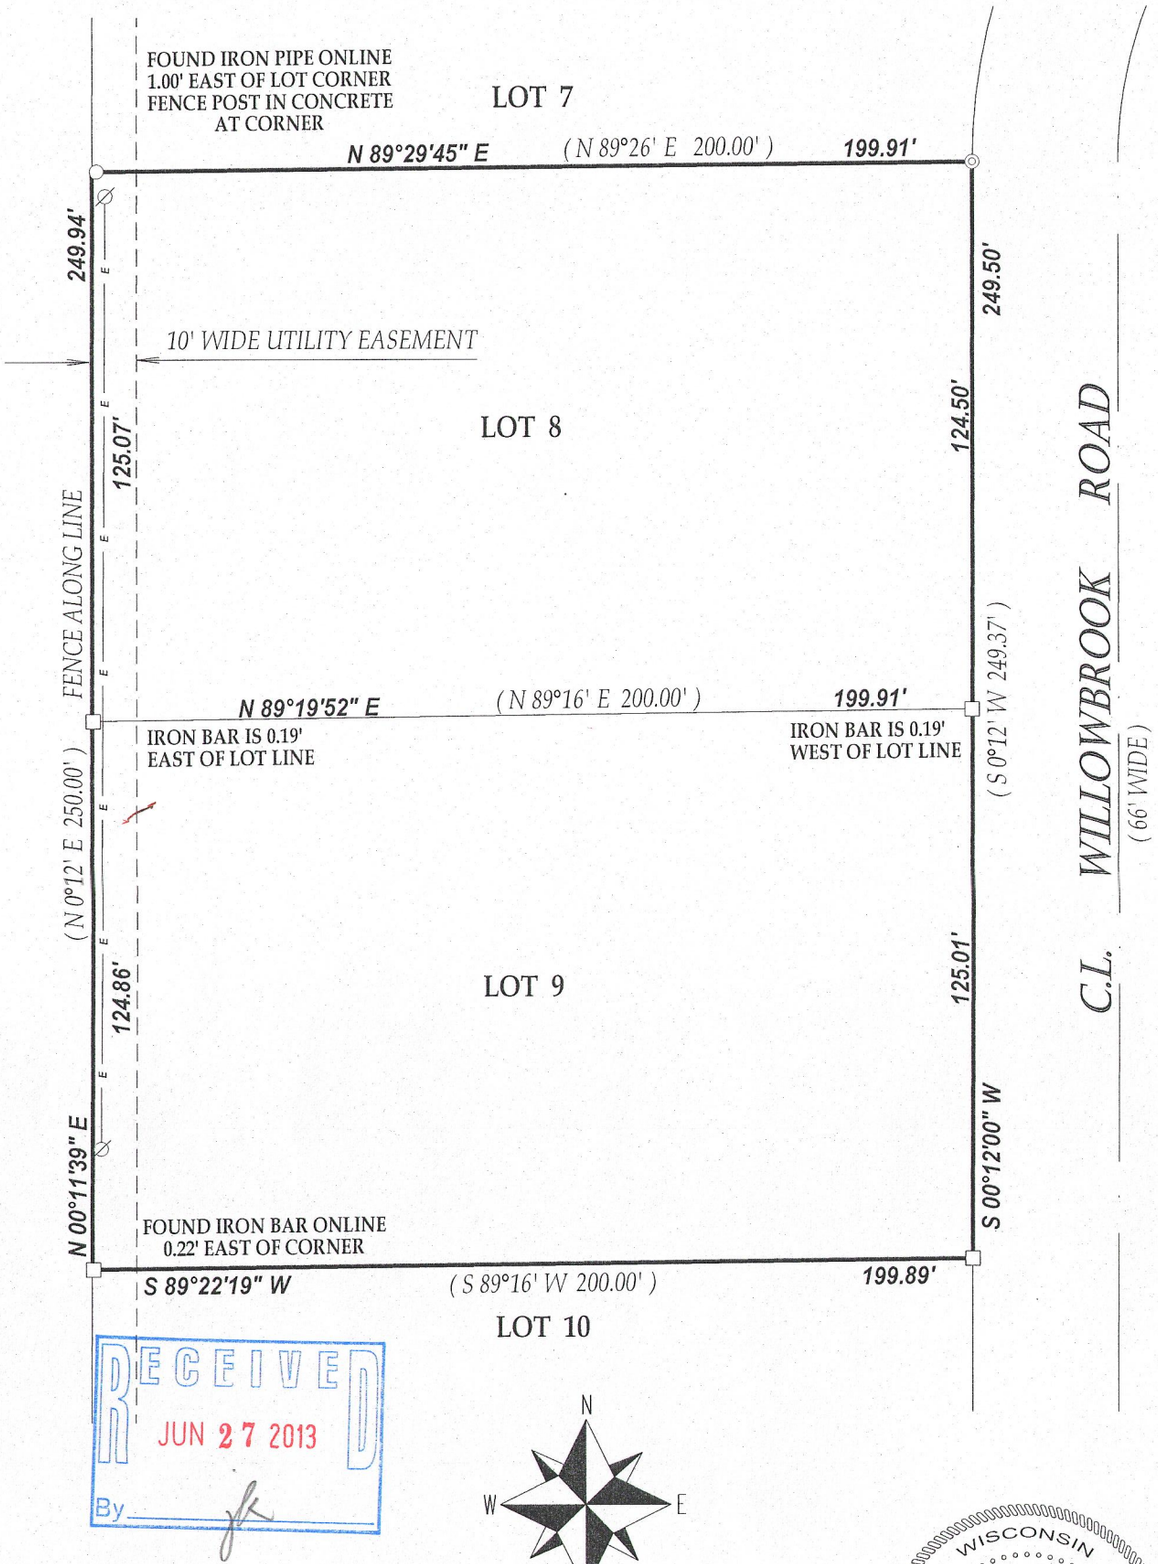

RECEIVED
JUN 27 2013
By

N
W E
S

SCALE 1" = 40'

0 40 80 120

LEGEND

- ○ FOUND 1" DIA. IRON PIPE
- ◎ FOUND 2" DIA. IRON PIPE
- □ FOUND IRON BAR
- ∅ UTILITY POLE
- —E— OVERHEAD WIRES
- (XX) RECORDED AS
- TAX ID # ILW00008 & 9
- JOB # 13-074

I have surveyed the above-described property and the above map is a true representation thereof and shows the size and location of the property, its exterior boundaries, the location and dimensions of all structures thereon, fences apparent easements and roadways and visible encroachments. if any.

This survey is made for the exclusive use of the present owners of the property, and also those who puchase, mortgage,or insure the title therto within one (1) year from date hereof; and as to them I warrant the accuracy of said survey map.

WISCONSIN
JOHN P.
KROTT
S-2258
LAKE GENEVA
WIS.
LAND SURVEYOR

DATED THIS 30th DAY OF MAY 2013

JOHN KROTT S - 2258
Wisconsin Registered Land Surveyor
(original if signed in red)

117-3534