
PREPARED FOR
PREMIERE HOMES
PO BOX 100
WILLIAMS BAY WI. 53191

KROTT SURVEYING INC.
N3705 WILLOW BEND LANE
LAKE GENEVA WI. 53147
PHONE # (262)248-3697
FAX # (262)249-0639

PLAT OF SURVEY

-OF-

LOTS 1 AND 43 IN BLOCK "H" IN CISCO BEACH SUBDIVISION LOCATED IN SECTION 5, TOWN 1 NORTH, RANGE 17 EAST, WALWORTH COUNTY, WISCONSIN.

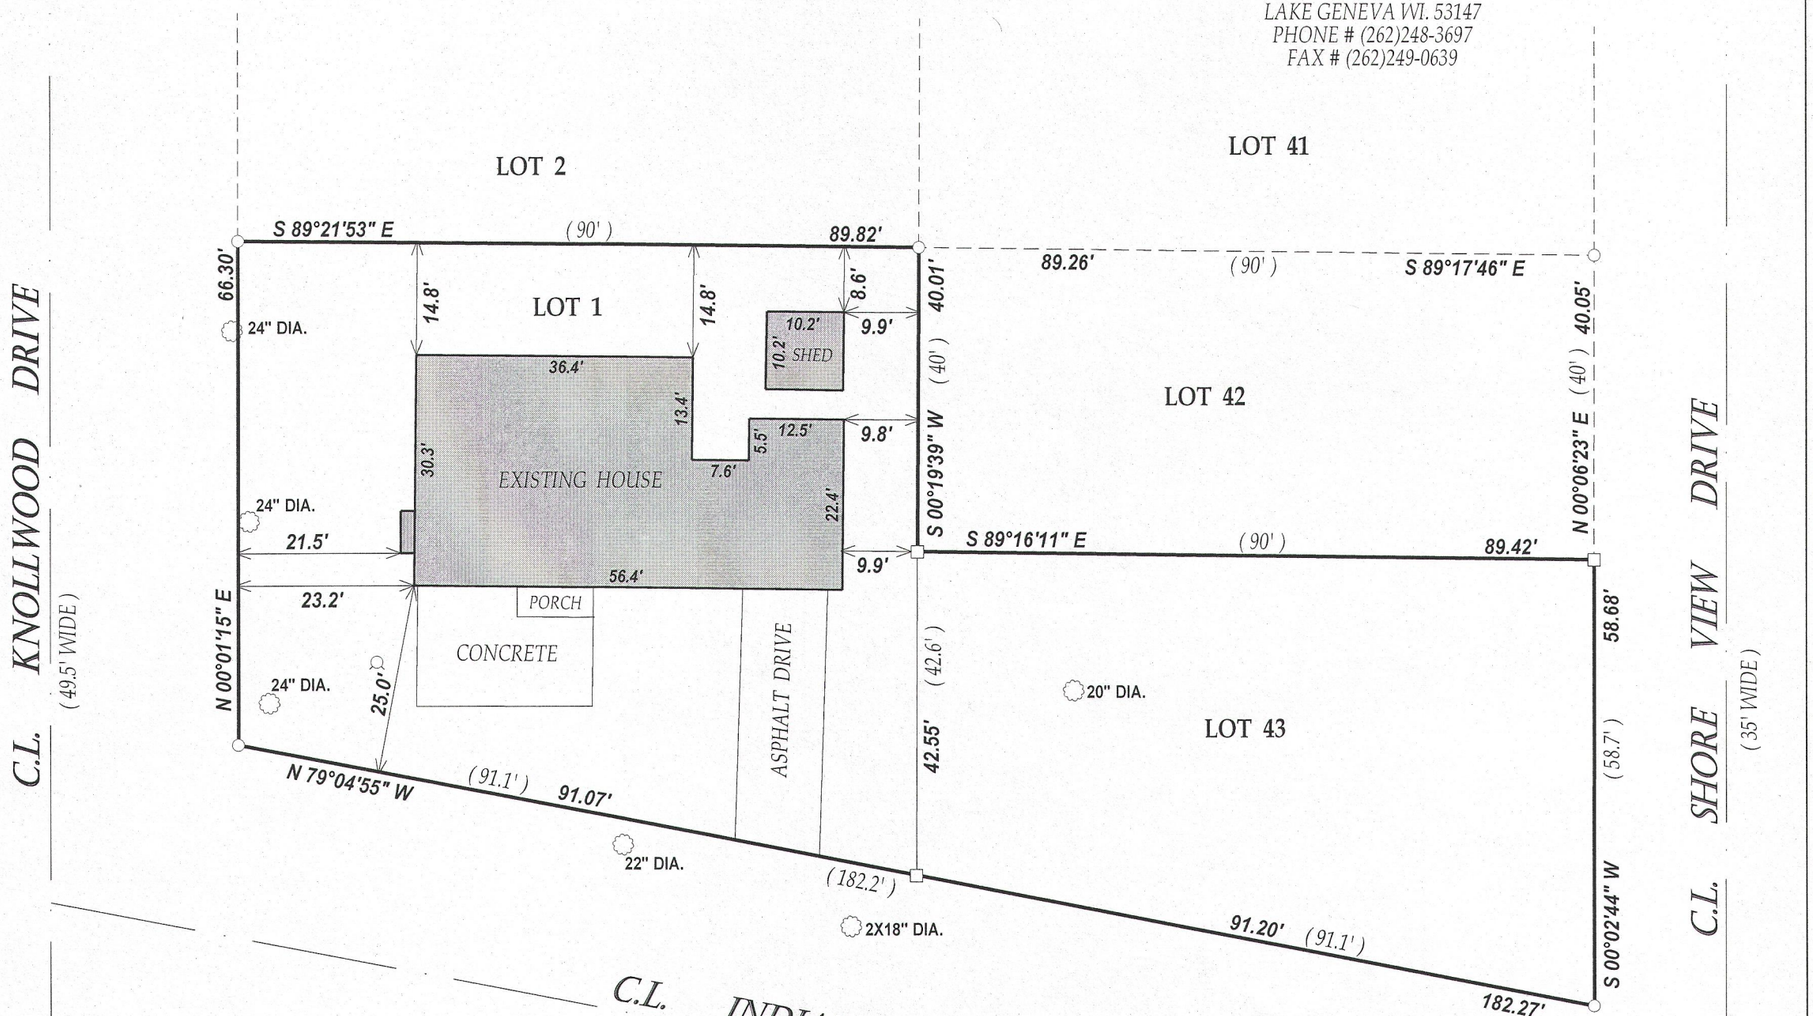

LEGEND

- ○ FOUND IRON PIPE
- □ FOUND IRON BAR
- ♀ WELL
- ◌ DECIDUOUS TREE
- (XX) RECORDED AS

TAX ID # ICI00168 &189

JOB # 13-081

I have surveyed the above-described property and the above map is a true representation thereof and shows the size and location of the property, its exterior boundaries, the location and dimensions of all structures thereon, fences apparent easements and roadways and visible encroachments. if any.

This survey is made for the exclusive use of the present owners of the property, and also those who puchase, mortgage,or insure the title therto within one (1) year from date hereof, and as to them I warrant the accuracy of said survey map.

RECEIVED
JUN 27 2013
By

SCALE 1"=20'

0 20 40 60

NOTE : BEARINGS ARE REFRENCED TO PREVIOUS SURVEY RECORDS

N W E S

WISCONSIN
JOHN P.
KROTT
S-2258
LAKE GENEVA
WIS.
LAND SURVEYOR

DATED THIS 7th DAY OF JUNE 2013

JOHN KROTT S - 2258
Wisconsin Registered Land Surveyor
(original if signed in red)

117-3544