



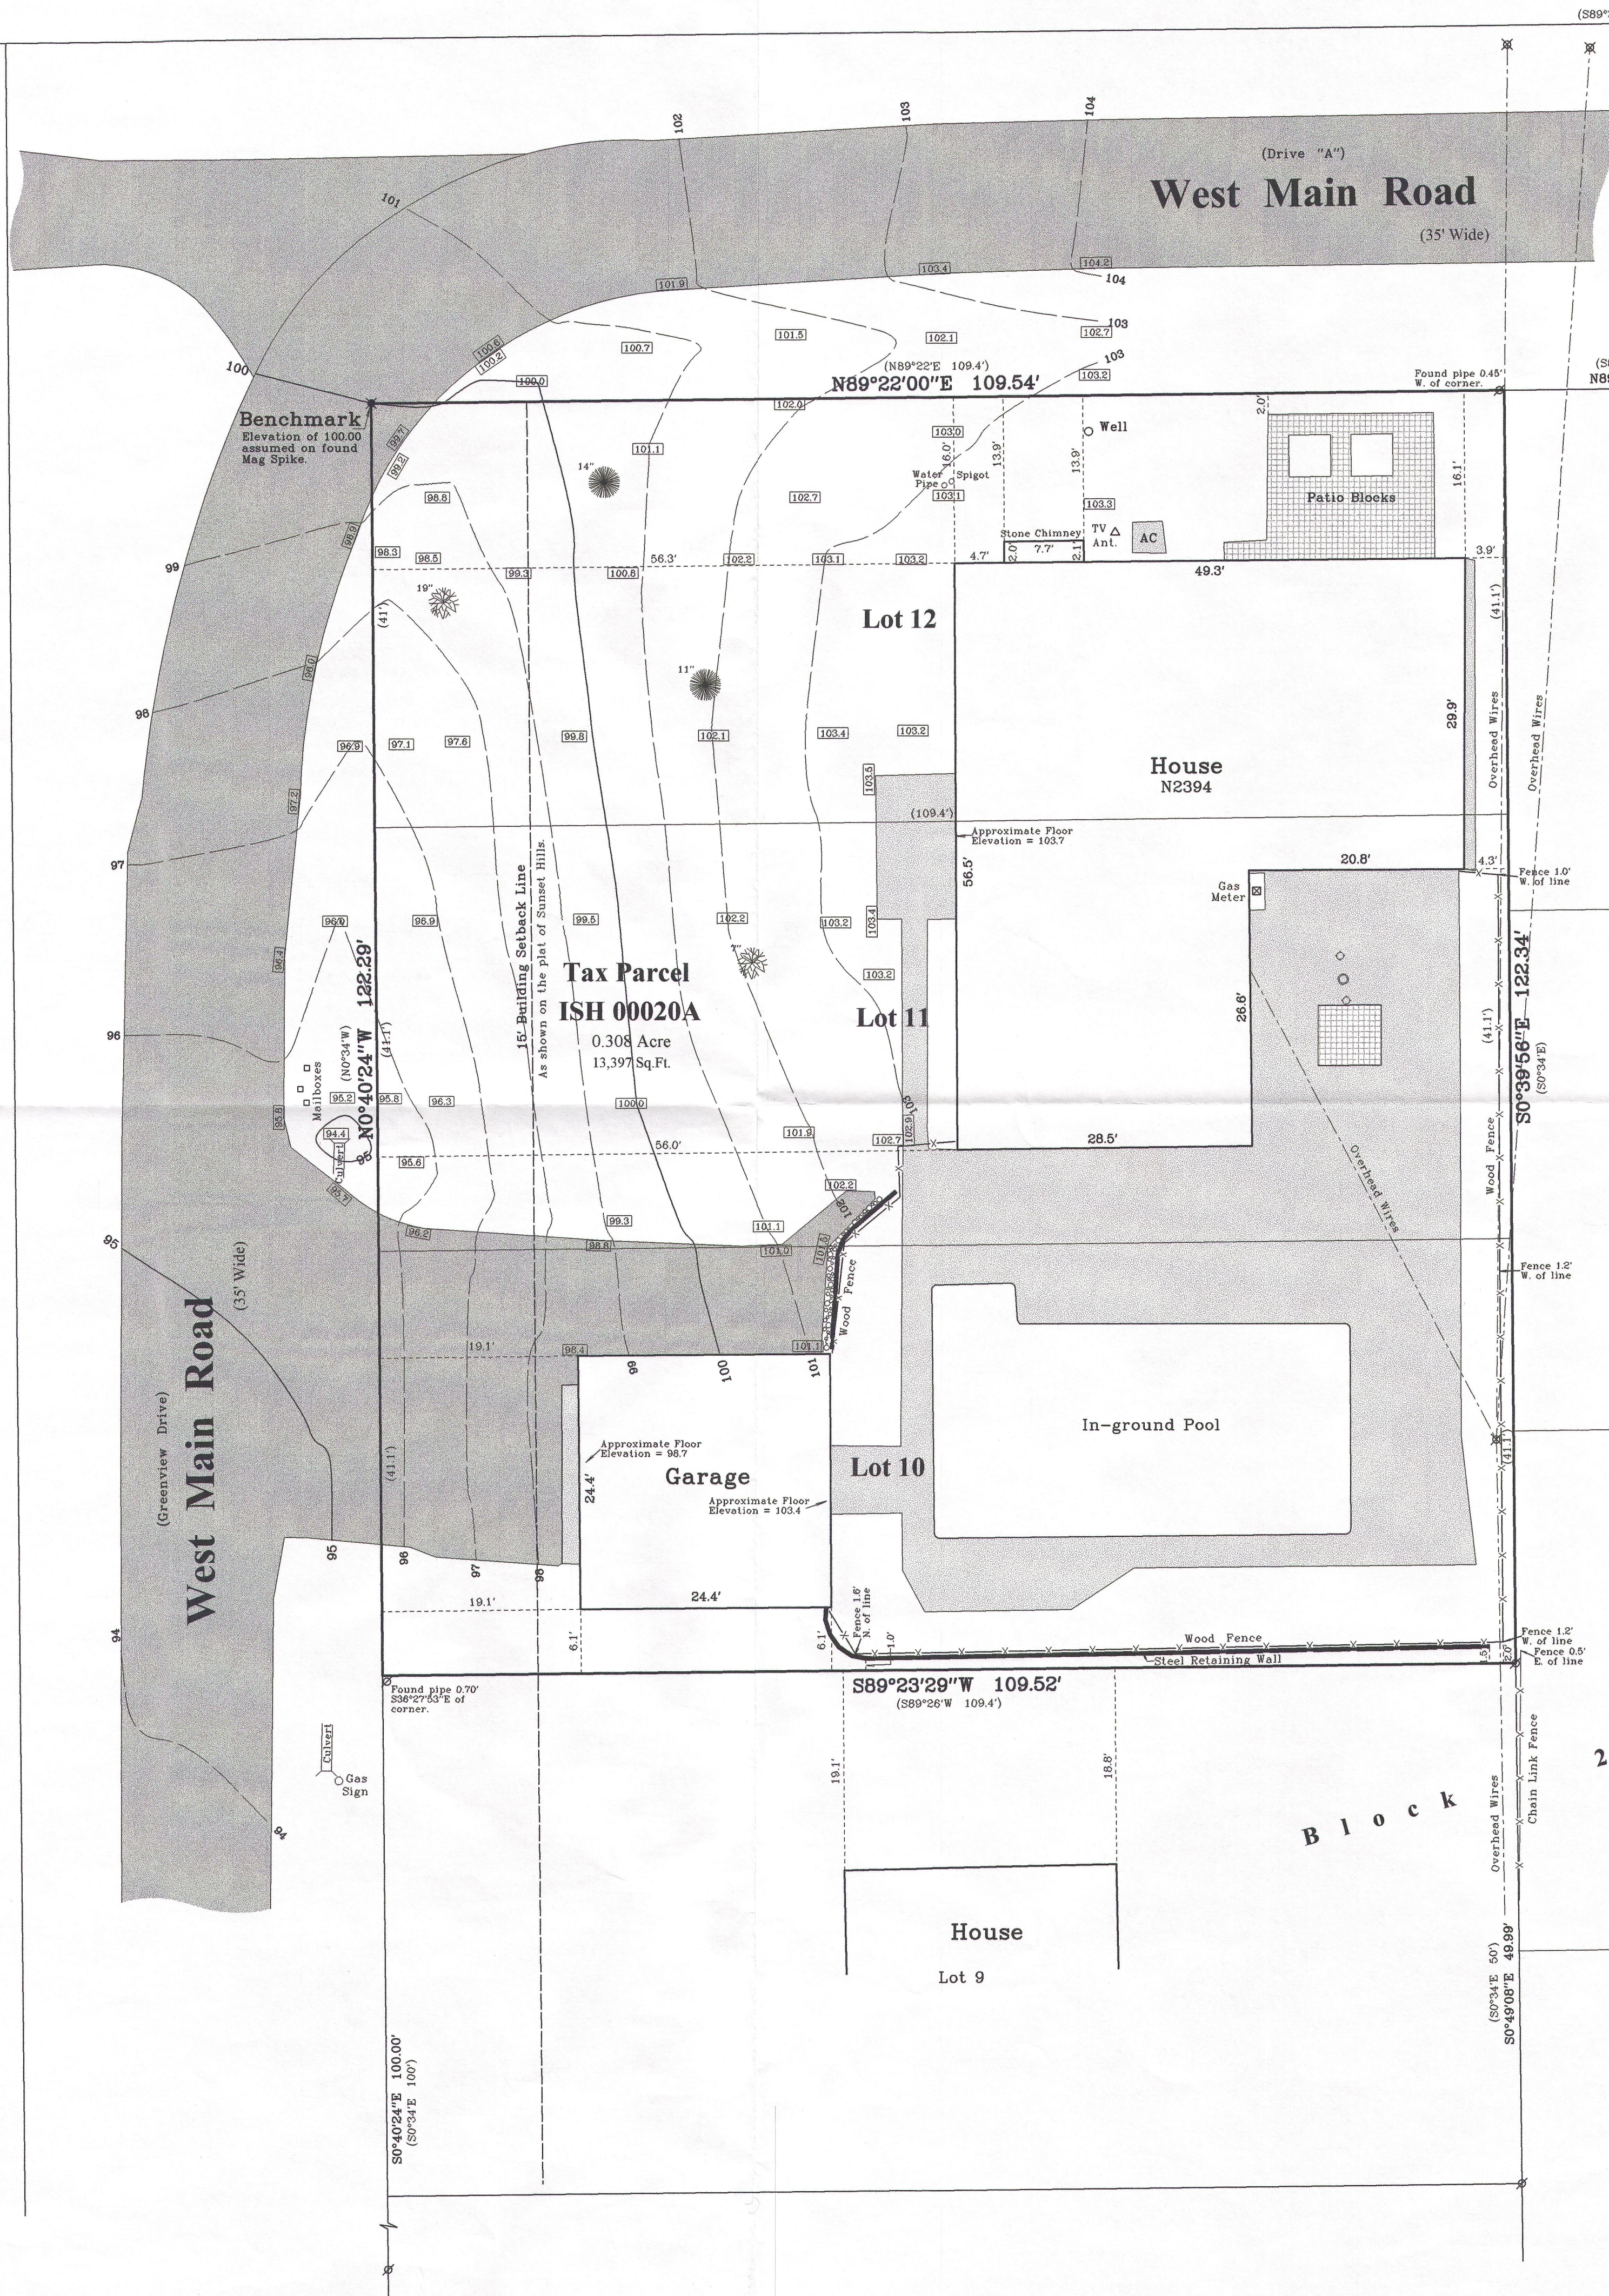


Plat of Survey

of
Lots 10, 11 & 12 in Block 2 of Sunset Hills,
a subdivision located in the Northwest 1/4 of Section 4, Town 1 North,
Range 17 East, Town of Linn, Walworth County, Wisconsin.

Surveyed for: **Philip Weyer**
27 Leslie Lane
Villa Park, Illinois. 60181

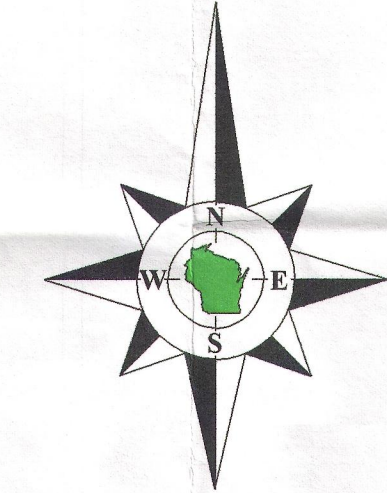

Bearings reference to the North line of
West Main Road, recorded as S 89°22'
W on the plat of Sunset Hills.

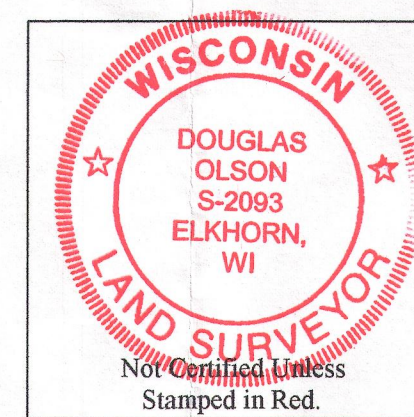

Notes:

- 1) This survey plat is not certified unless signed and sealed in red ink.
- 2) This survey is subject to Wisconsin lien laws. This Plat of Survey is the notice of intent to file lien. Lien waiver required.

Copyright 2013 by Jensen & Olson Land Surveying, LLC.

All rights reserved. No part of this survey plat may be reproduced or transmitted in any form by any means - graphic, electronic, or mechanical, including photocopying, tracing, or information storage and retrieval systems - without permission in writing from Douglas G. Olson, Jensen & Olson Land Surveying, LLC.

I, Douglas G. Olson, Wisconsin Registered Land Surveyor, do hereby certify that this survey was performed by me, or under my direction in full compliance with the owner's/agent's instructions and Chapter A-E 7 of the Wisconsin Administrative Code "Minimum Standards for Property Surveys", and that this map is an accurate representation thereof to the best of my knowledge and belief.

Douglas G. Olson
Wisconsin Registered Land Surveyor - 2093

±8H -20A

117-3559

Survey date: May 1, 2013.
Revisions:

Scale in Feet
1" = 10'

Jensen & Olson Land Surveying, LLC
45 South Wisconsin Street * P.O. Box 322 * Elkhorn, Wisconsin. 53121
Telephone: (262) 723-3434 * Facsimile: (262) 723-8044
Email: jensen.olson@elknet.net

- Legend**
- Found Iron Pipe
 - Found Mag Spike
 - Recorded Information
 - Utility Pole
 - Concrete Cover
 - Asphalt Surface
 - Concrete Surface
 - Brick Pavers
 - Deiduous Tree
 - Coniferous Tree
 - Spot Elevation

Sheet 1 of 1 Sheets

Job Reference Number

2013.028

2013.028