
PREPARED FOR
GLEN AHRENS

PLAT OF SURVEY

- OF -

LOT 13 HIGHFIELD GLEN CONSERVANCY, A SUBDIVISION LOCATED IN THE SW 1/4 AND NW 1/4 OF SECTION 31, TOWN 1 NORTH, RANGE 17 EAST, TOWN OF LINN, WALWORTH COUNTY, WISCONSIN.

PATHFINDER SURVEYING INC.
(formerly)
J.K. SURVEYING INC.
P.O BOX 322
LAKE GENEVA, WI. 53147
WWW.PATHFINDERSURVEYING.NET
262-248-8303

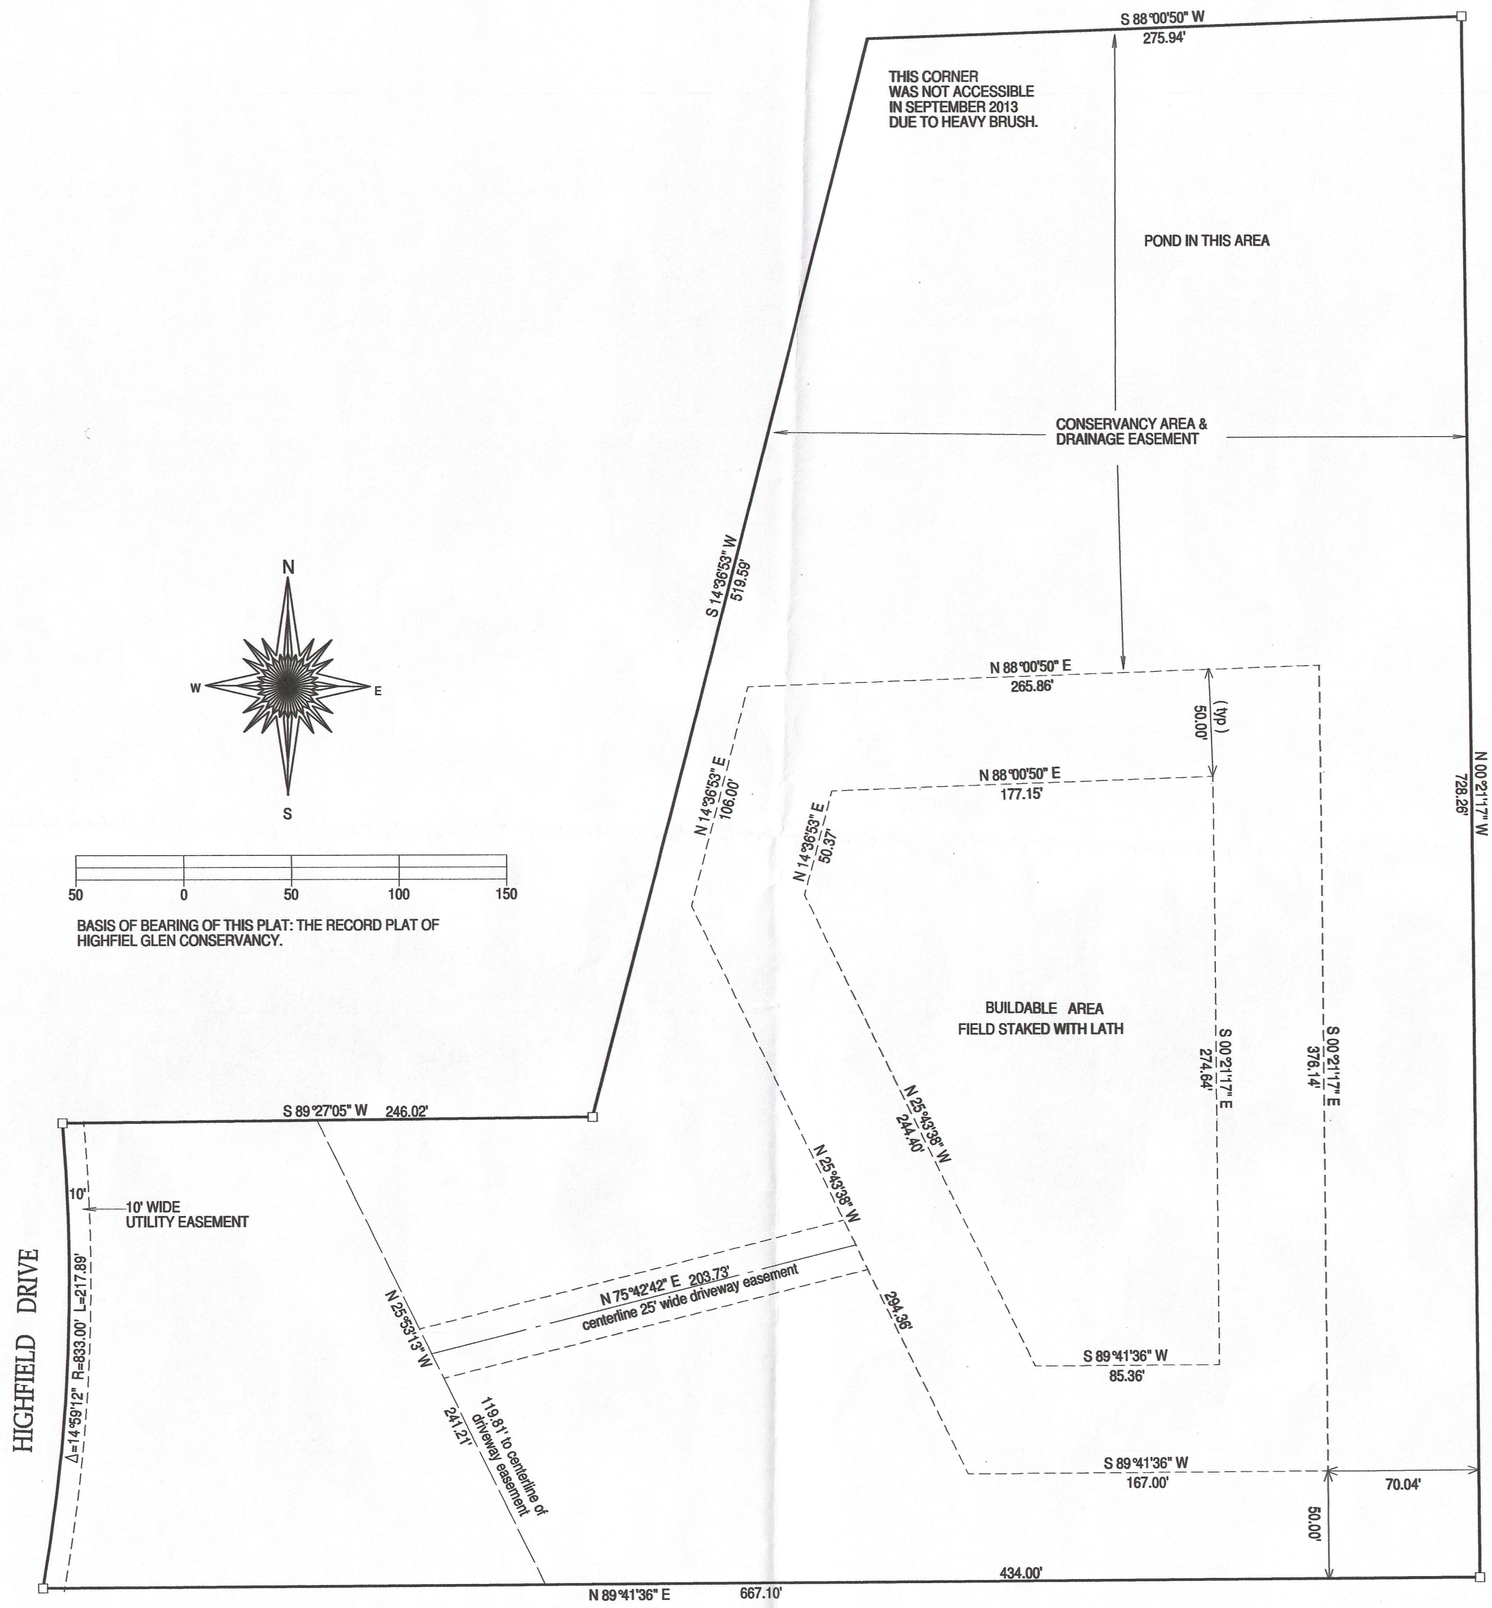

50 0 50 100 150

BASIS OF BEARING OF THIS PLAT: THE RECORD PLAT OF HIGHFIEL GLEN CONSERVANCY.

( )= recorded as
□ = found iron bar
○ = found iron pipe
● = set iron pipe
■ = set iron bar

SCALE 1" = 50'

JOB # 13-173

TAX ID # IHGC00013

"I hereby certify that I have surveyed the above described property and that the above map is a true representation of its exterior boundary and shows the size and location of all visible structures, apparent easements and encroachments if any."

This survey is made for the present owners of the property, and those who purchase, mortgage, or guarantee the title thereto, within one year from the date hereof.

DATED THIS 30TH DAY OF SEPTEMBER, 2013.

RECEIVED
OCT 4 2013
By

WISCONSIN JEFFREY L. KIMPS S-2436 LAKE GENEVA. WIS. LAND SURVEYOR

JEFFREY L KIMPS S - 2436
Wisconsin Registered Land Surveyor
(original if signed in red)

117-3567