
PREPARED FOR
BECKY MERWIN
THE RAULAND AGENCY
PO. BOX 159
WALWORTH WI. 53184

PLAT OF SURVEY OF

LOTS 10, 11 AND 14 IN BLOCK 5 IN LAKE GENEVA TERRACE, ACCORDING TO THE PLAT THEREOF OF RECORD IN THE OFFICE OF THE REGISTER OF DEEDS FOR WALWORTH COUNTY, WISCONSIN.

KROTT SURVEYING INC.
(262) 248-3697
N 3705 WILLOW BEND LANE
LAKE GENEVA WI. 53147

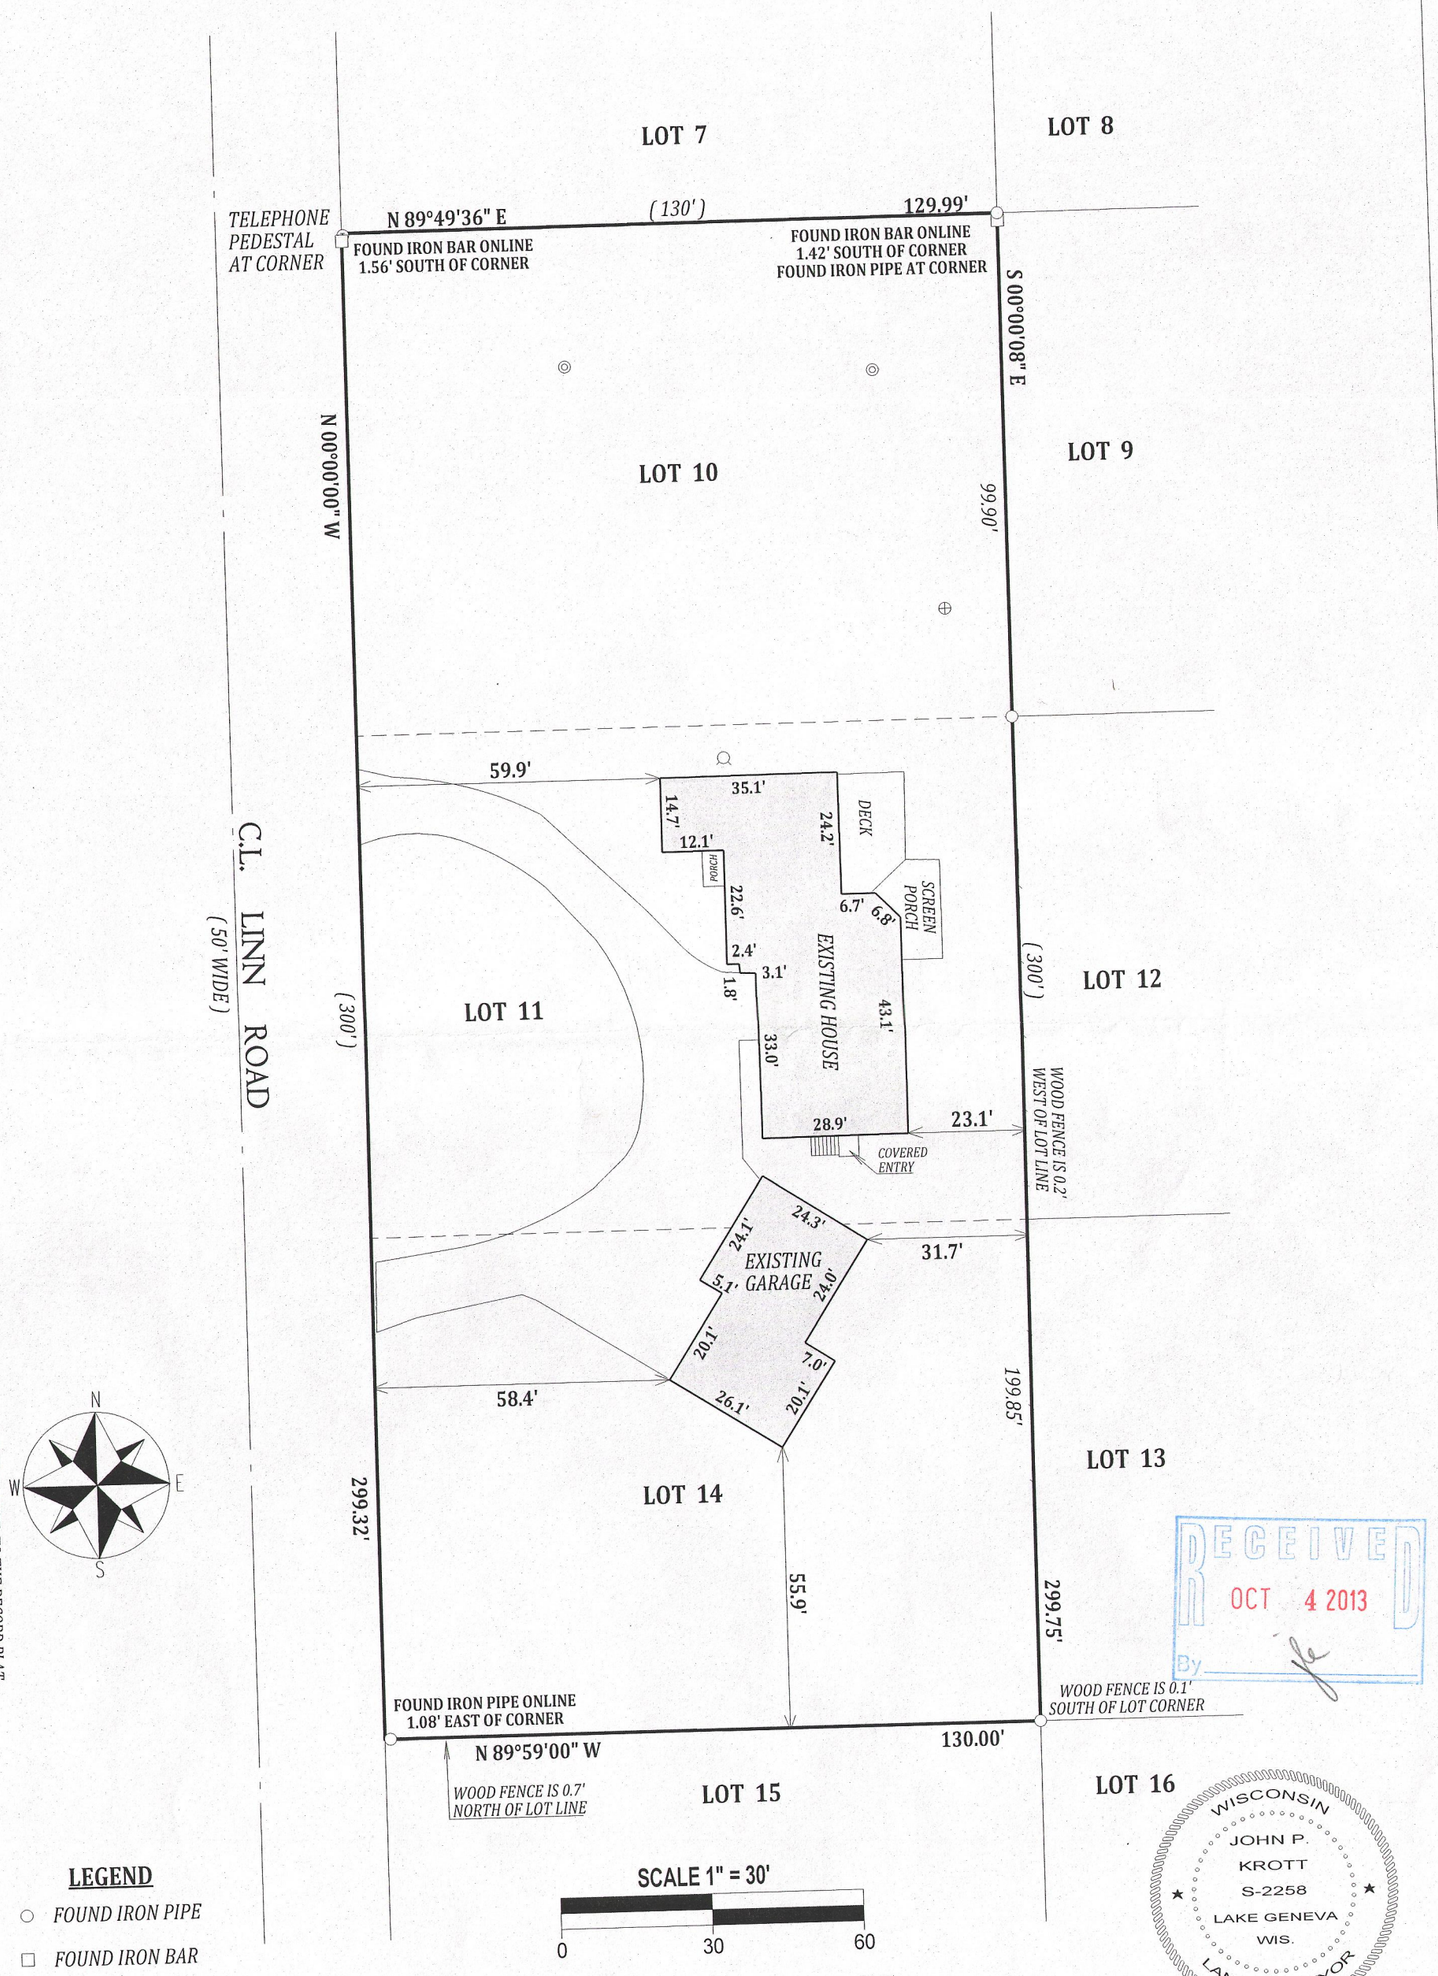

NOTE: BEARINGS ARE REFRENCED TO THE RECORD PLAT.

RECEIVED
OCT 4 2013
By

LEGEND

- FOUND IRON PIPE
- FOUND IRON BAR
- CONCRETE ACCESS COVER
- WELL
- 4" DIA. P.V.C. PIPE
- (XX) RECORDED AS
- TAX ID # ILGT00020C
- JOB # 13-141

SCALE 1" = 30'

0 30 60

I have surveyed the above-described property and the above map is a true representation thereof and shows the size and location of the property, its exterior boundaries, the location and dimensions of all structures thereon, fences apparent easements and roadways and visible encroachments. if any.

This survey is made for the exclusive use of the present owners of the property, and also those who puchase, mortgage,or insure the title therto within one (1) year from date hereof; and as to them I warrant the accuracy of said survey map.

WISCONSIN
JOHN P. KROTT
S-2258
LAKE GENEVA WIS.
LAND SURVEYOR

DATED THIS 17th DAY OF SEPTEMBER 2013

JOHN P. KROTT S-2258
WISCONSIN REGISTERED LAND SURVEYOR
(NOTE: THIS IS NOT A CERTIFIED COPY UNLESS SIGNED IN RED INK)

117-3582