
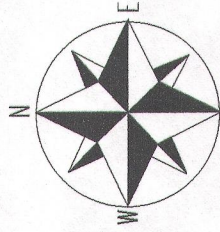


PREPARED FOR
DIANE K. URLANDS
KEPP REAL ESTATE
7000 WILLOW LANE
LAKE GENEVA WI 53147

KROTT SURVEYING INC.
(262) 248-3887
N 3705 WILLOW LANE
LAKE GENEVA WI 53147

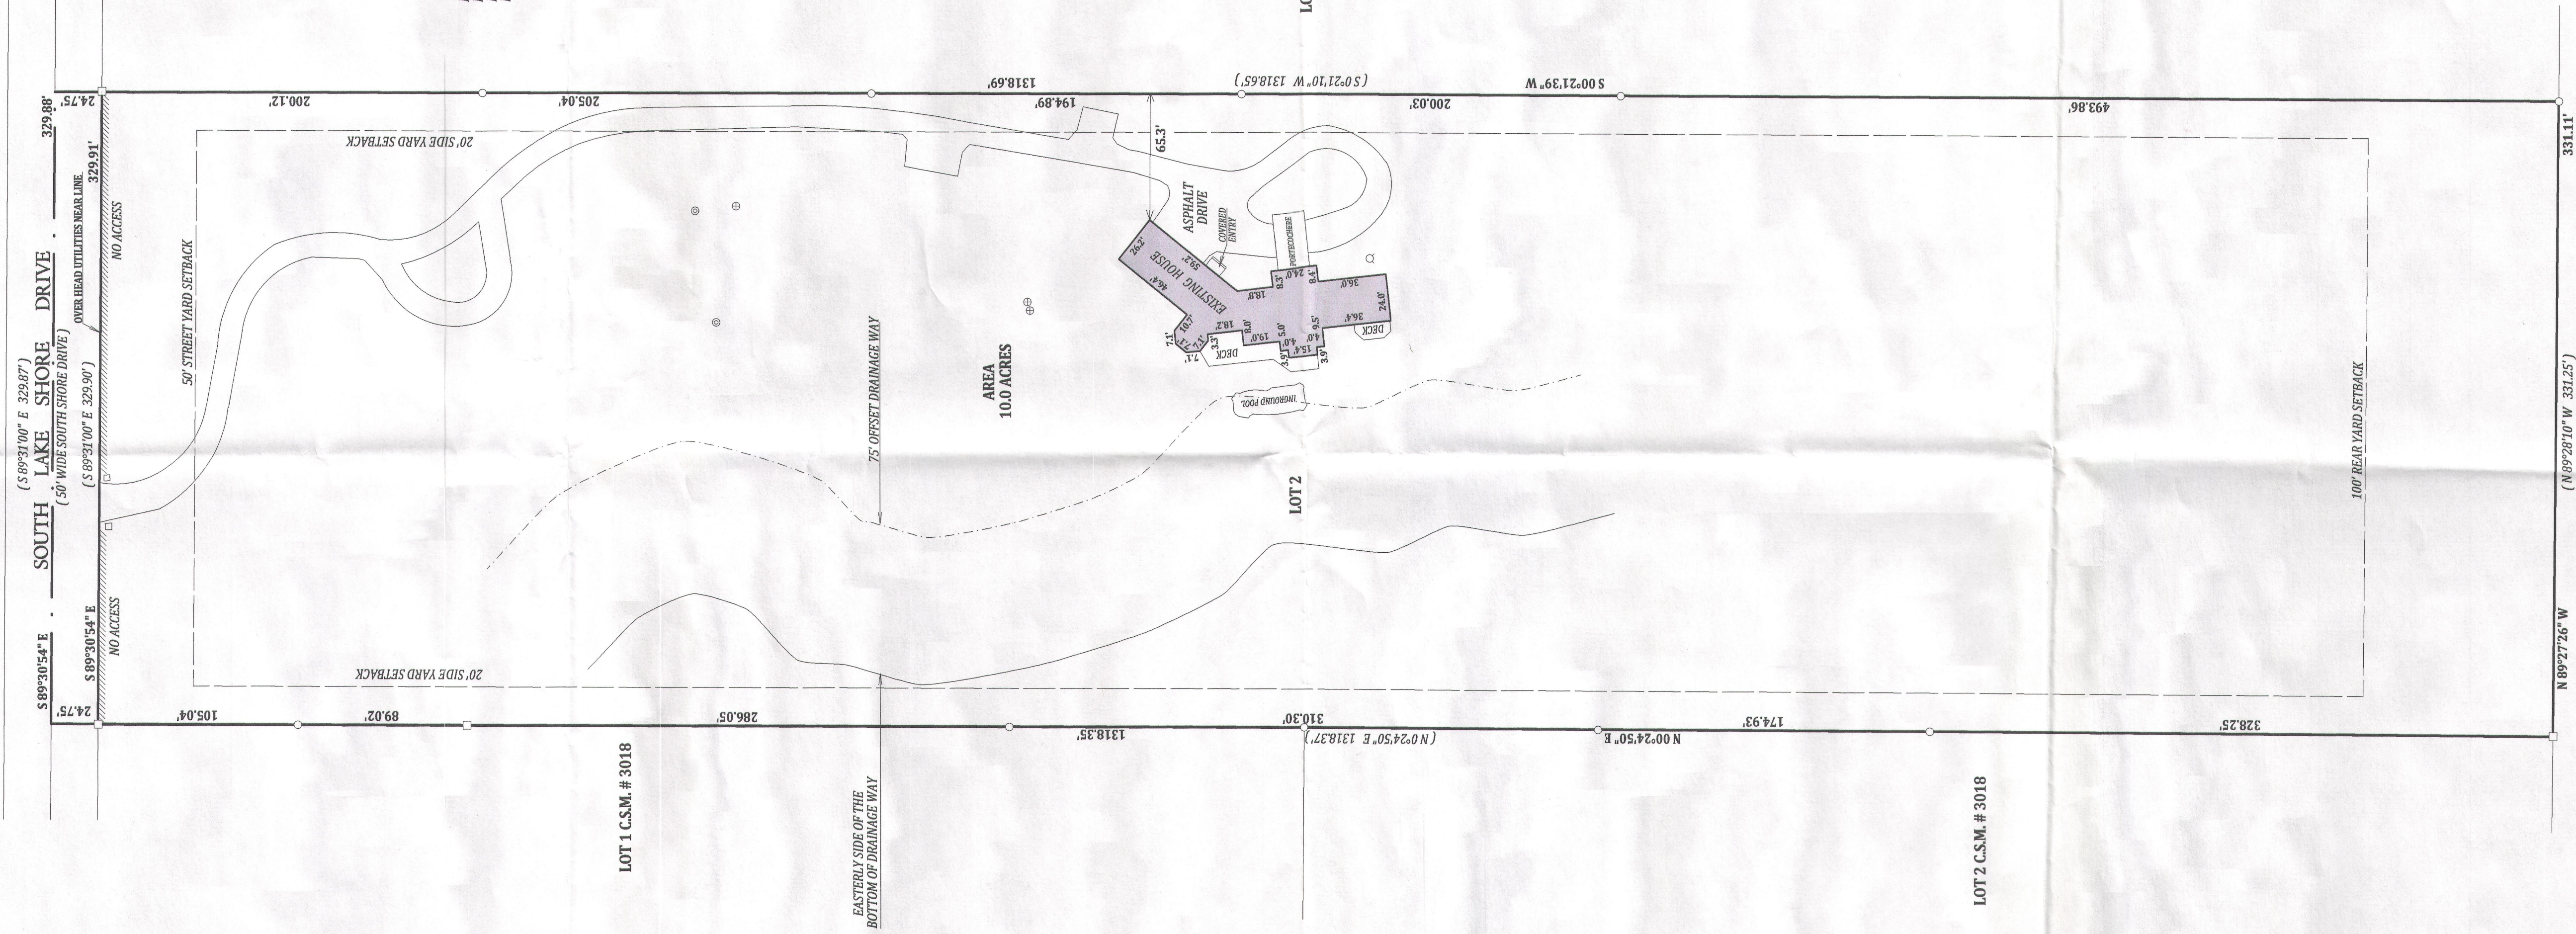

SCALE 1" = 50'

NOTE: BEARINGS ARE REFERENCED TO C.S.M. NO. 1672.



I have surveyed the above-described property and the above map is a true representation thereof and shows the size and location of the property, its exterior boundaries, the location and dimensions of all visible encroachments, easements and roadways and visible encroachments, if any.

This survey is made for the exclusive use of the present owners of the property, and also those who purchase, mortgage or insure the title thereto within one (1) year from date hereof; and as to them I warrant the accuracy of said survey map.

LEGEND

- FOUND IRON PIPE
- FOUND IRON BAR
- ⊕ CONCRETE ACCESS COVER
- ⊙ 4" DIA. P.V.C. PIPE
- ⊙ WELL


(XX) RECORDED AS

TAX ID # 1A167200002

JOB # 13-146

PLAT OF SURVEY OF

LOT 2 OF CERTIFIED SURVEY MAP NO. 1672, ACCORDING TO THE RECORDED PLAT THEREOF, RECORDED IN VOLUME 8 OF CERTIFIED SURVEYS ON PAGE 36 AS DOCUMENT NO. 159543, LOCATED IN THE NORTHWEST 1/4 OF THE SOUTHWEST 1/4 OF SECTION 17, TOWN 1 NORTH, RANGE 17 EAST, WALWORTH COUNTY, WISCONSIN.

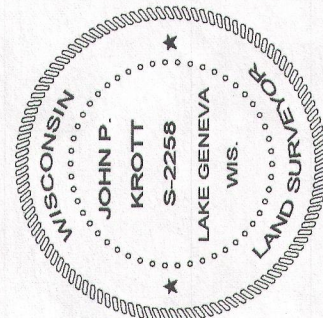

DATED THIS 26th DAY OF SEPTEMBER 2013



JOHN P. KROTT
WISCONSIN REGISTERED LAND SURVEYOR
(NOTE: THIS IS NOT A CERTIFIED COPY UNLESS SIGNED IN RED INK)

117-3588