


PREPARED FOR
LINDA TONGE
KEEFE REAL ESTATE
751 GENEVA PARKWAY
LAKE GENEVA WI 53147

PLAT OF SURVEY

- OF -

LOT 2 OF CERTIFIED SURVEY MAP NO. 781, LOCATED IN THE
EAST 1/2 OF SECTION 11, TOWN 1 NORTH, RANGE 17 EAST,
TOWN OF LINN, COUNTY OF WALWORTH AND STATE OF WISCONSIN.

KROTT SURVEYING INC.
N3705 WILLOW BEND LANE
LAKE GENEVA WI. 53147
PHONE # (262)248-3697
FAX # (262)249-0639

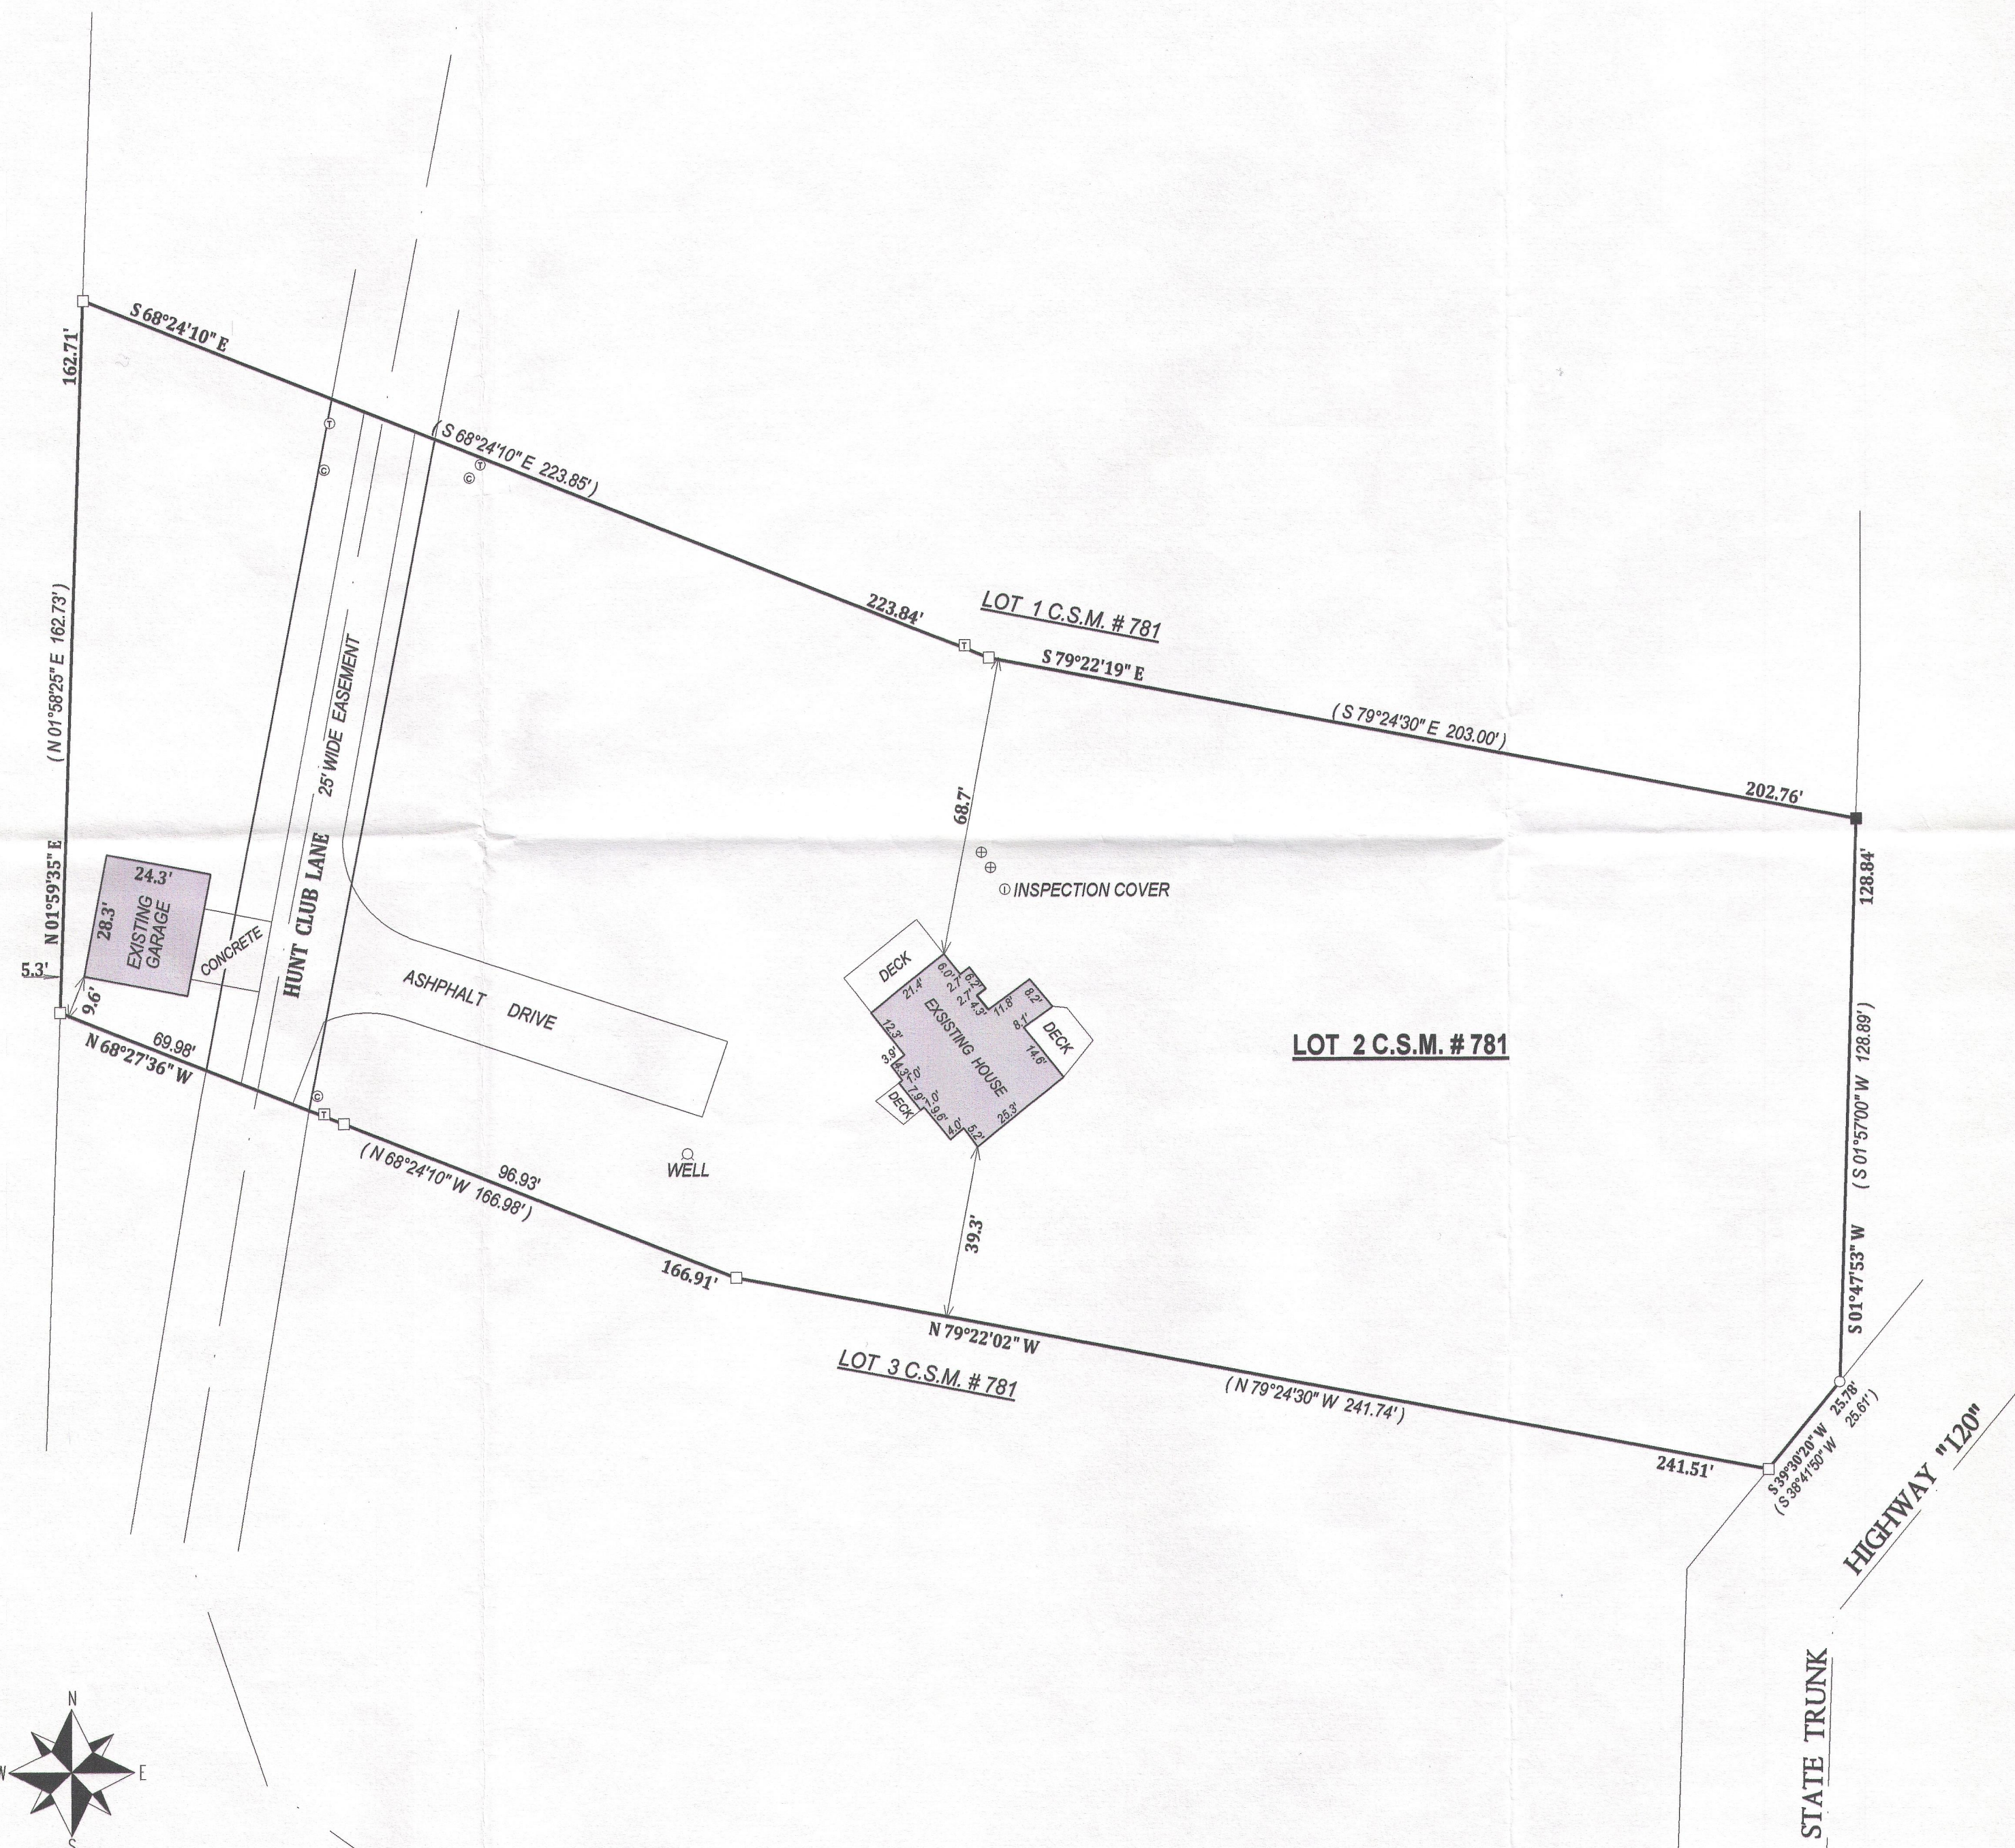


LEGEND

- FOUND IRON PIPE
- FOUND IRON BAR
- SET IRON BAR
- ⊞ ELECTRICAL TRANSFORMER
- ⊙ TELEPHONE PEDESTAL
- ⊙ CABLE PEDESTAL
- ⊙ WELL
- ⊙ CONCRETE LID

(XX) RECORDED AS

TAX ID # 1A78100002

JOB # 04-193

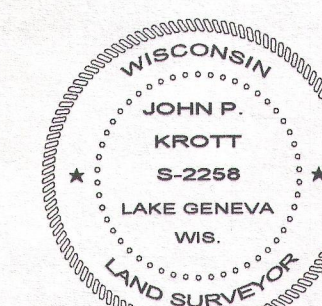

DATED THIS 21st DAY OF AUGUST 2013

John P. Krott
JOHN KROTT S - 2258
Wisconsin Registered Land Surveyor
(original if signed in red)

117-3594