TOPOGRAPHICAL MAPPING
PLAT OF SURVEY

LOTS 14, 15, 16 & 17, BLOCK J OF CISCO BEACH

LOCATED IN TOWN 1 NORTH, RANGE 17 EAST,
WALWORTH COUNTY, WISCONSIN

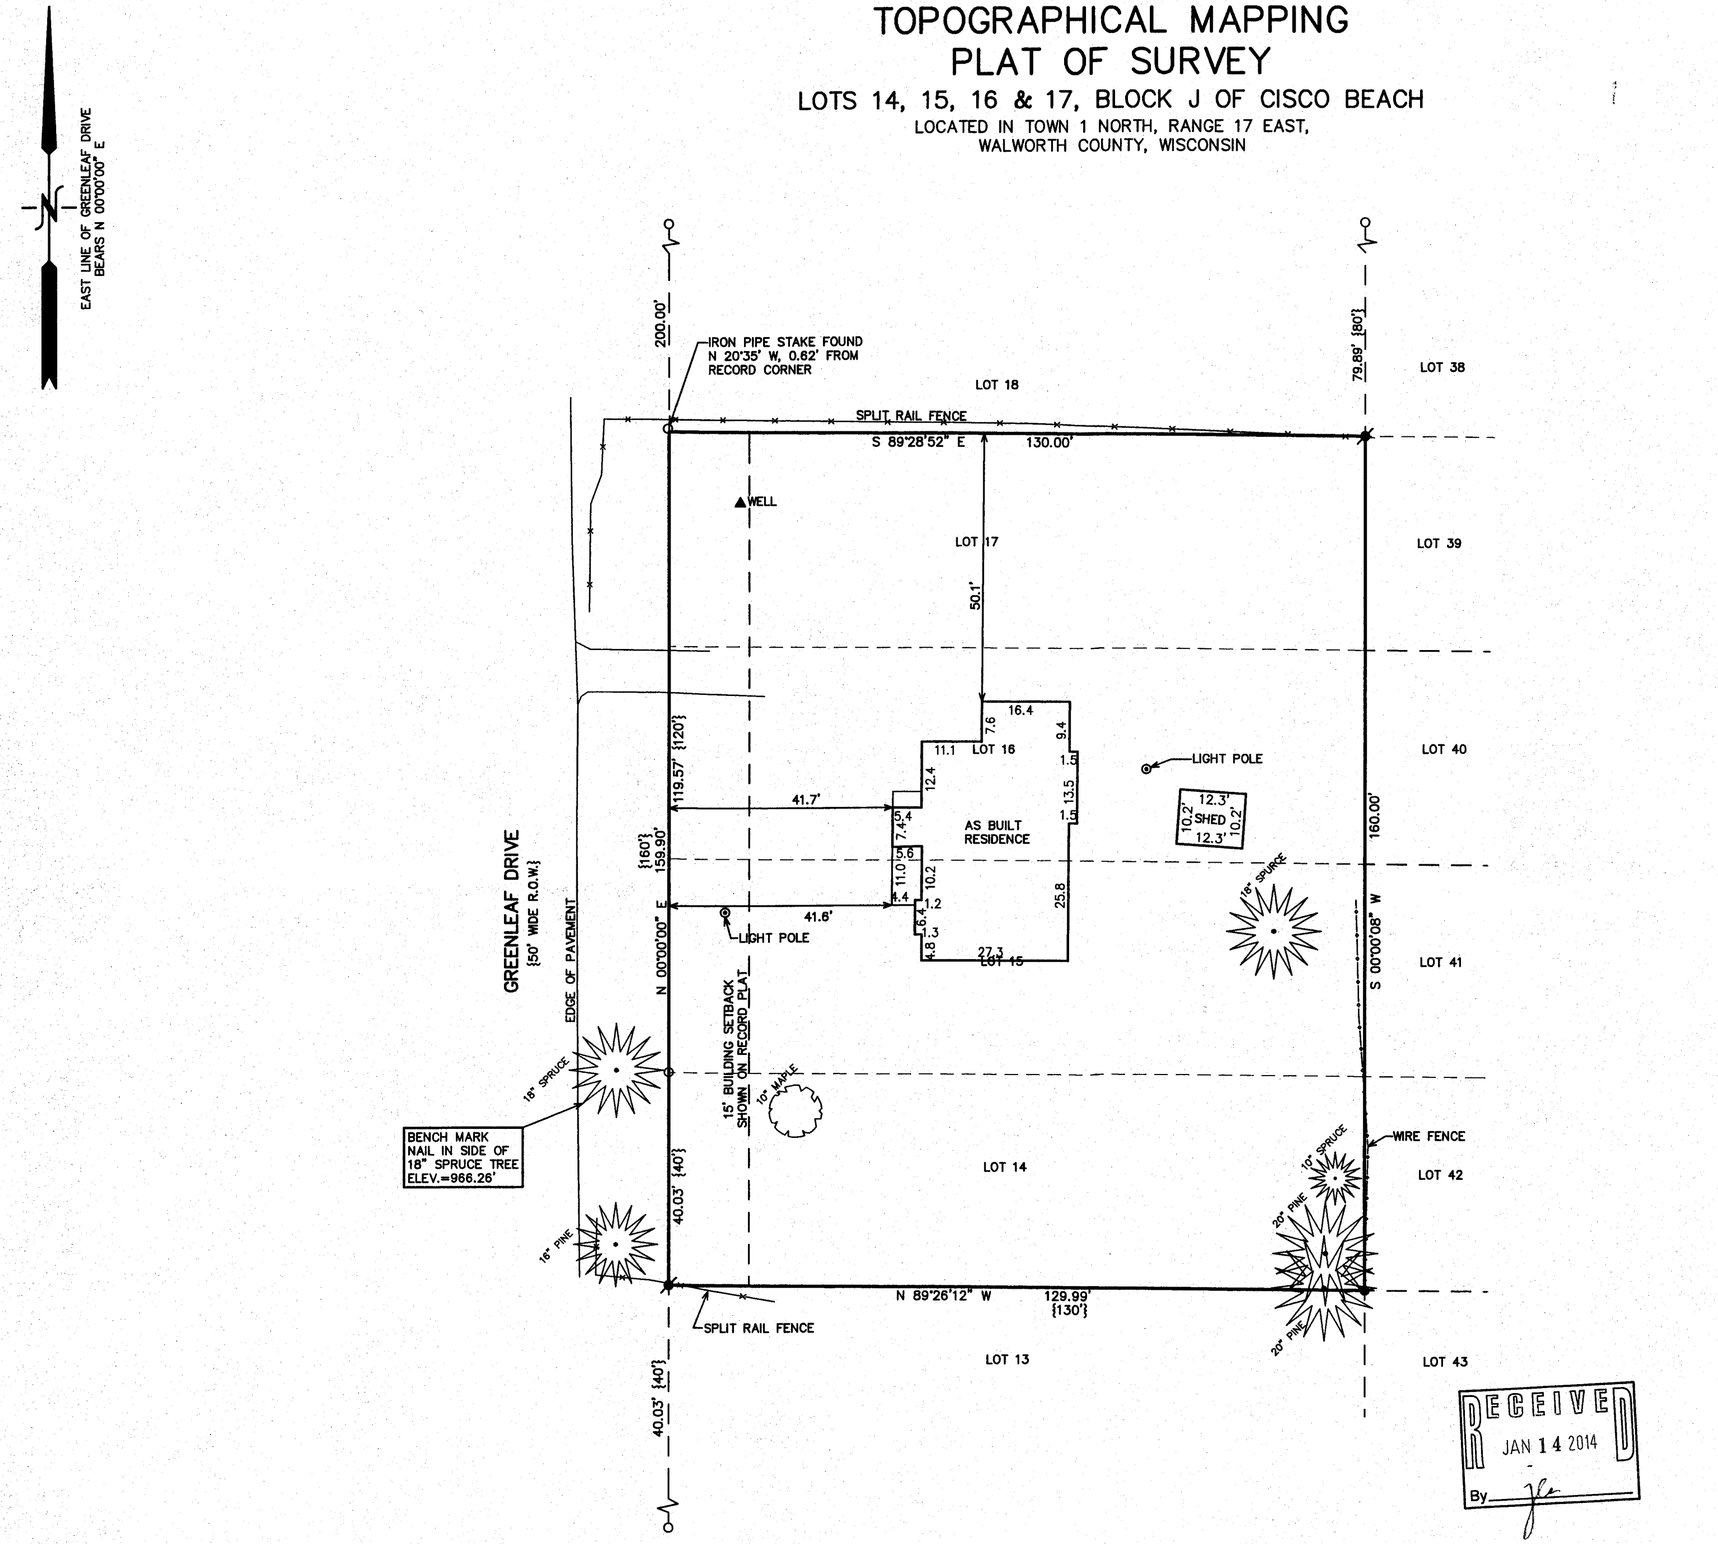

LEGEND

- ○ = IRON PIPE STAKE FOUND
- ● = IRON REBAR STAKE FOUND
- ⌀ = IRON REBAR STAKE SET
- {XXX} = RECORDED AS

TOTAL LAND AREA = 20,792 S.F. (0.48 ACRES)

RECEIVED
JAN 14 2014
By

NOTE: COPIES OF THIS MAP TO WHICH THE FOLLOWING CERTIFICATE WILL APPLY SHOW THE SURVEYOR'S ORIGINAL SEAL AND SIGNATURE IN RED INK. COPIES BY ANY OTHER MEANS MAY HAVE ALTERATIONS WHICH DO NOT REPRESENT THE SURVEYOR'S WORK PRODUCT.

I HEREBY CERTIFY THAT THE ABOVE DESCRIBED PROPERTY HAS BEEN SURVEYED UNDER MY DIRECTION AND THAT THE ABOVE MAP IS A TRUE REPRESENTATION THEREOF AND SHOWS THE SIZE AND LOCATION OF THE PROPERTY AND ITS EXTERIOR BOUNDARIES. THIS SURVEY IS MADE FOR THE USE OF THE PRESENT OWNERS OF THE PROPERTY, AND ALSO THOSE WHO PURCHASE, MORTGAGE, OR GUARANTEE THE TITLE THERETO WITHIN ONE YEAR FROM THE DATE HEREOF.

WISCONSIN PETER S. GORDON S-2101 ELKHORN, WI LAND SURVEYOR

DATED: JUNE 28, 2013

REVISED 12-09-2013
TO SHOW SIZE & LOCATION OF
AS BUILT RESIDENCE

PETER S. GORDON R.L.S. 2101

10 5 0 10 20 30 40 50 60 70 80 90 100
MAP SCALE IN FEET ORIGINAL 1" = 20'

12/9/2013 X:\Projects\8827\DcaD\ASBUILT

DEC 09 2013

– WORK ORDERED BY –
LOWELL MANAGEMENT, INC.
PO BOX 926
LAKE GENEVA, WI 53147

FARRIS, HANSEN & ASSOCIATES, INC.
ENGINEERING – ARCHITECTURE – SURVEYING
7 RIDGWAY COURT P.O. BOX 437
ELKHORN, WISCONSIN 53121
OFFICE: (262) 723-2098 FAX: (262) 723-5886

REVISIONS

PROJECT NO.	8827
DATE:	6/28/2013
SHEET NO.	1 OF 1

ICI -229 117-3617