
PREPARED FOR
MICHALENE MELGES
KEEFE REALESTATE
751 GENEVA PARKWAY
LAKE GENEVA WI. 53147

PLAT OF SURVEY OF

THE SOUTH 125 FEET OF THE SOUTH 250 FEET AS MEASURED ON WESTERLY LINE OF LOT 1 OF "THE BIRCHES" AS SHOWN BY THE PLAT THEREOF RECORDED IN THE OFFICE OF THE REGISTER OF DEEDS FOR WALWORTH COUNTY, WISCONSIN.

KROTT SURVEYING INC.
(262) 248-3697
N 3705 WILLOW BEND LANE
LAKE GENEVA WI. 53147

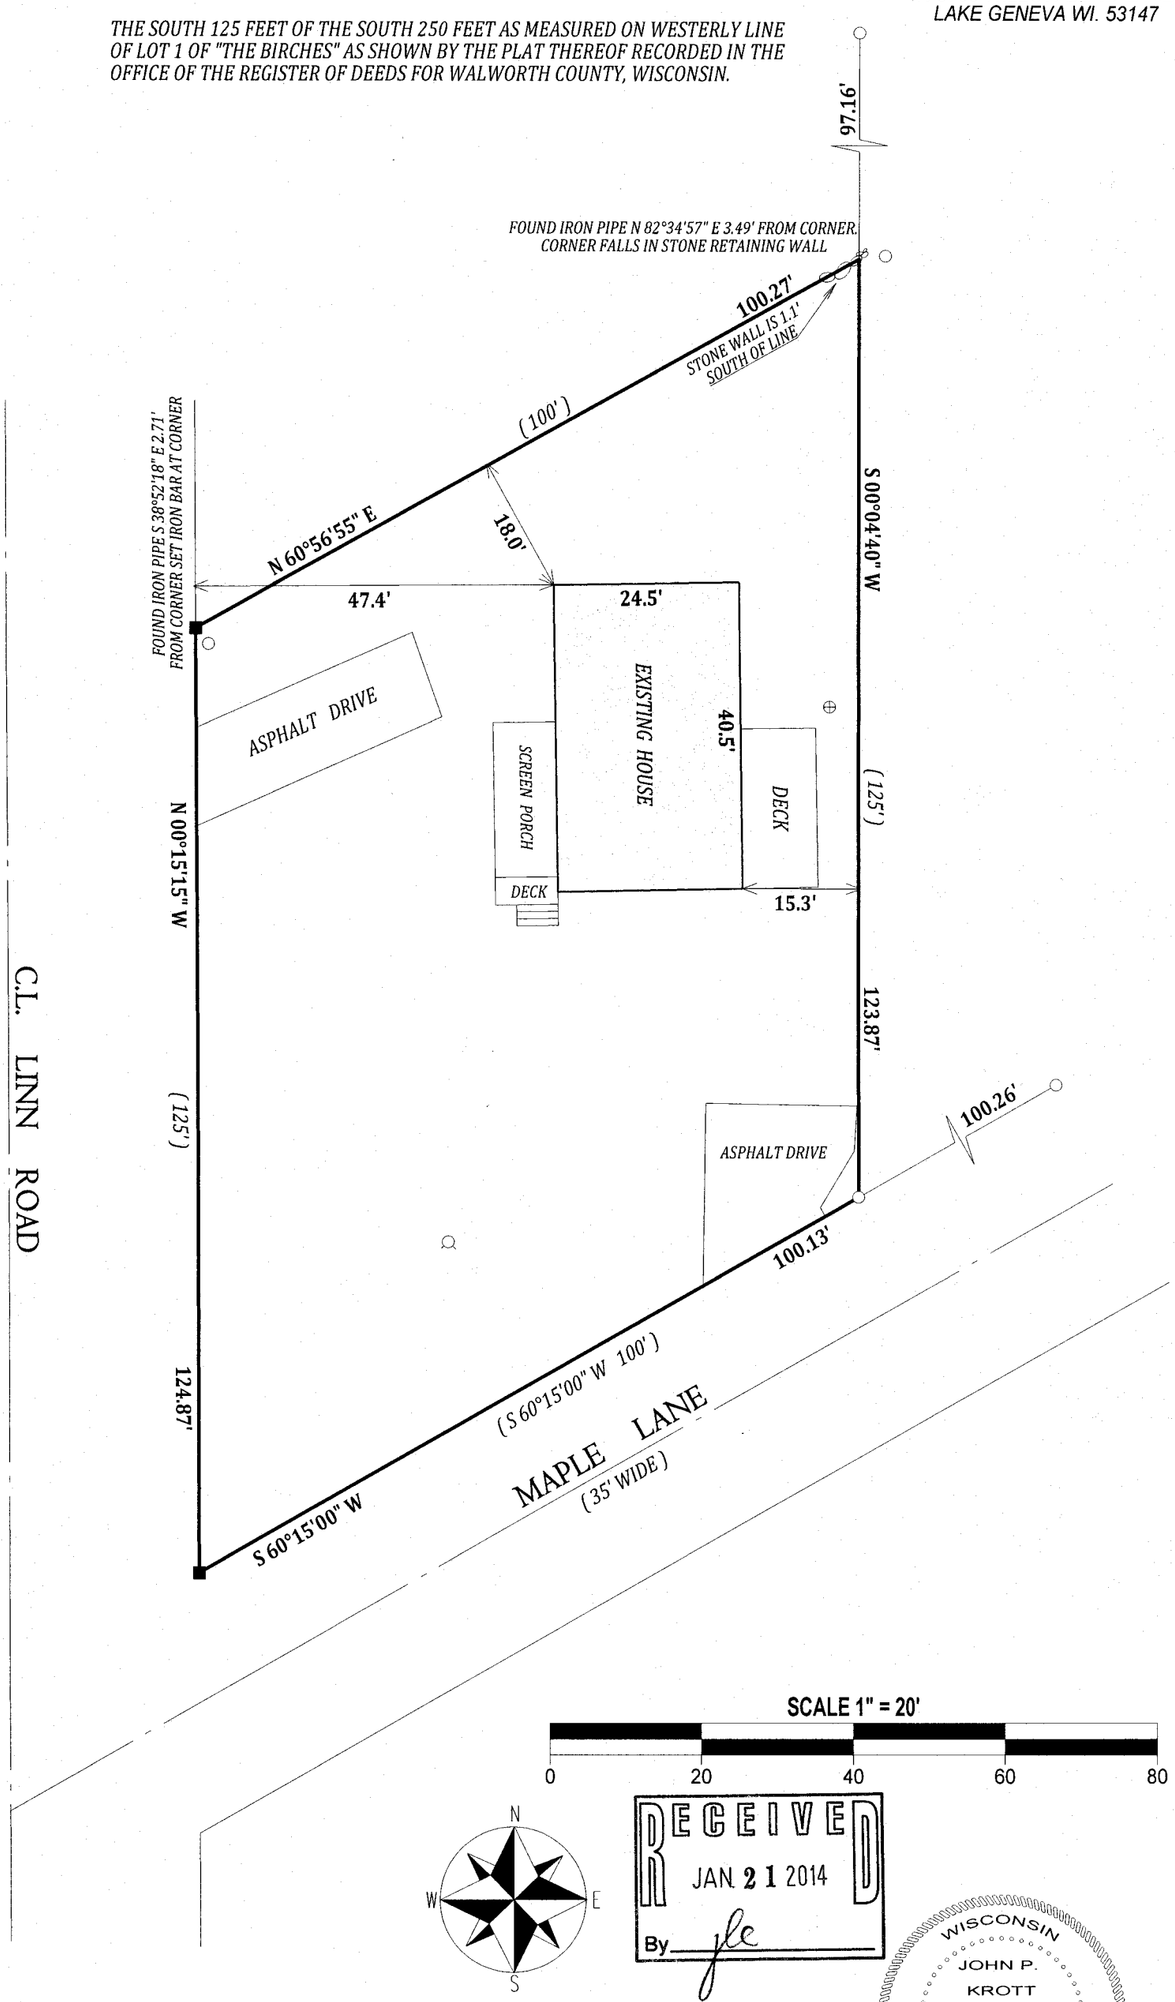

SCALE 1" = 20'

0 20 40 60 80

NOTE: BEARINGS ARE REFRENCED TO THE RECORD PLAT.

LEGEND


- ○ FOUND IRON PIPE
- ■ SET IRON BAR
- ⊕ CONCRETE ACCESS COVER
- ⌾ WELL
- (XX) RECORDED AS

TAX ID # IBA00001A

JOB # 13-178

I have surveyed the above-described property and the above map is a true representation thereof and shows the size and location of the property, its exterior boundaries, the location and dimensions of all structures thereon, fences apparent easements and roadways and visible encroachments. if any.

This survey is made for the exclusive use of the present owners of the property, and also those who puchase, mortgage,or insure the title therto within one (1) year from date hereof; and as to them I warrant the accuracy of said survey map.

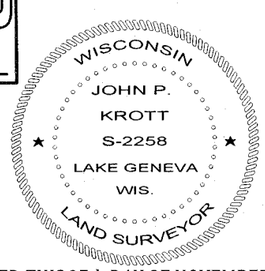

DATED THIS 27th DAY OF NOVEMBER 2013

JOHN P. KROTT S-2258
WISCONSIN REGISTERED LAND SURVEYOR
(NOTE: THIS IS NOT A CERTIFIED COPY UNLESS SIGNED IN RED INK)

IBA -1A 117-3622