
PLAT OF SURVEY

SURVEY FOR: BEAA SHEEHAN, KEEFE REAL ESTATE, INC.

PROPERTY ADDRESS: W4106 BUTTERNUT LN.
TAX KEY NO.: IA 57400003

LEGAL DESCRIPTION (TAKEN FROM WARRANTY DEED, DOC. NO. 824844):
LOT 3 OF CERTIFIED SURVEY MAP NO. 574, RECORDED IN THE OFFICE OF THE REGISTER OF DEEDS FOR WALWORTH COUNTY, WISCONSIN, ON JUNE 9, 1976, IN VOLUME 3, PAGE 25, AS DOCUMENT NO. 04102, BEING IN THE NORTHEAST 1/4 OF SECTION 5, TOWNSHIP 1 NORTH, RANGE 17 EAST. SAID LAND BEING IN THE TOWN OF LINN, COUNTY OF WALWORTH, AND STATE OF WISCONSIN.

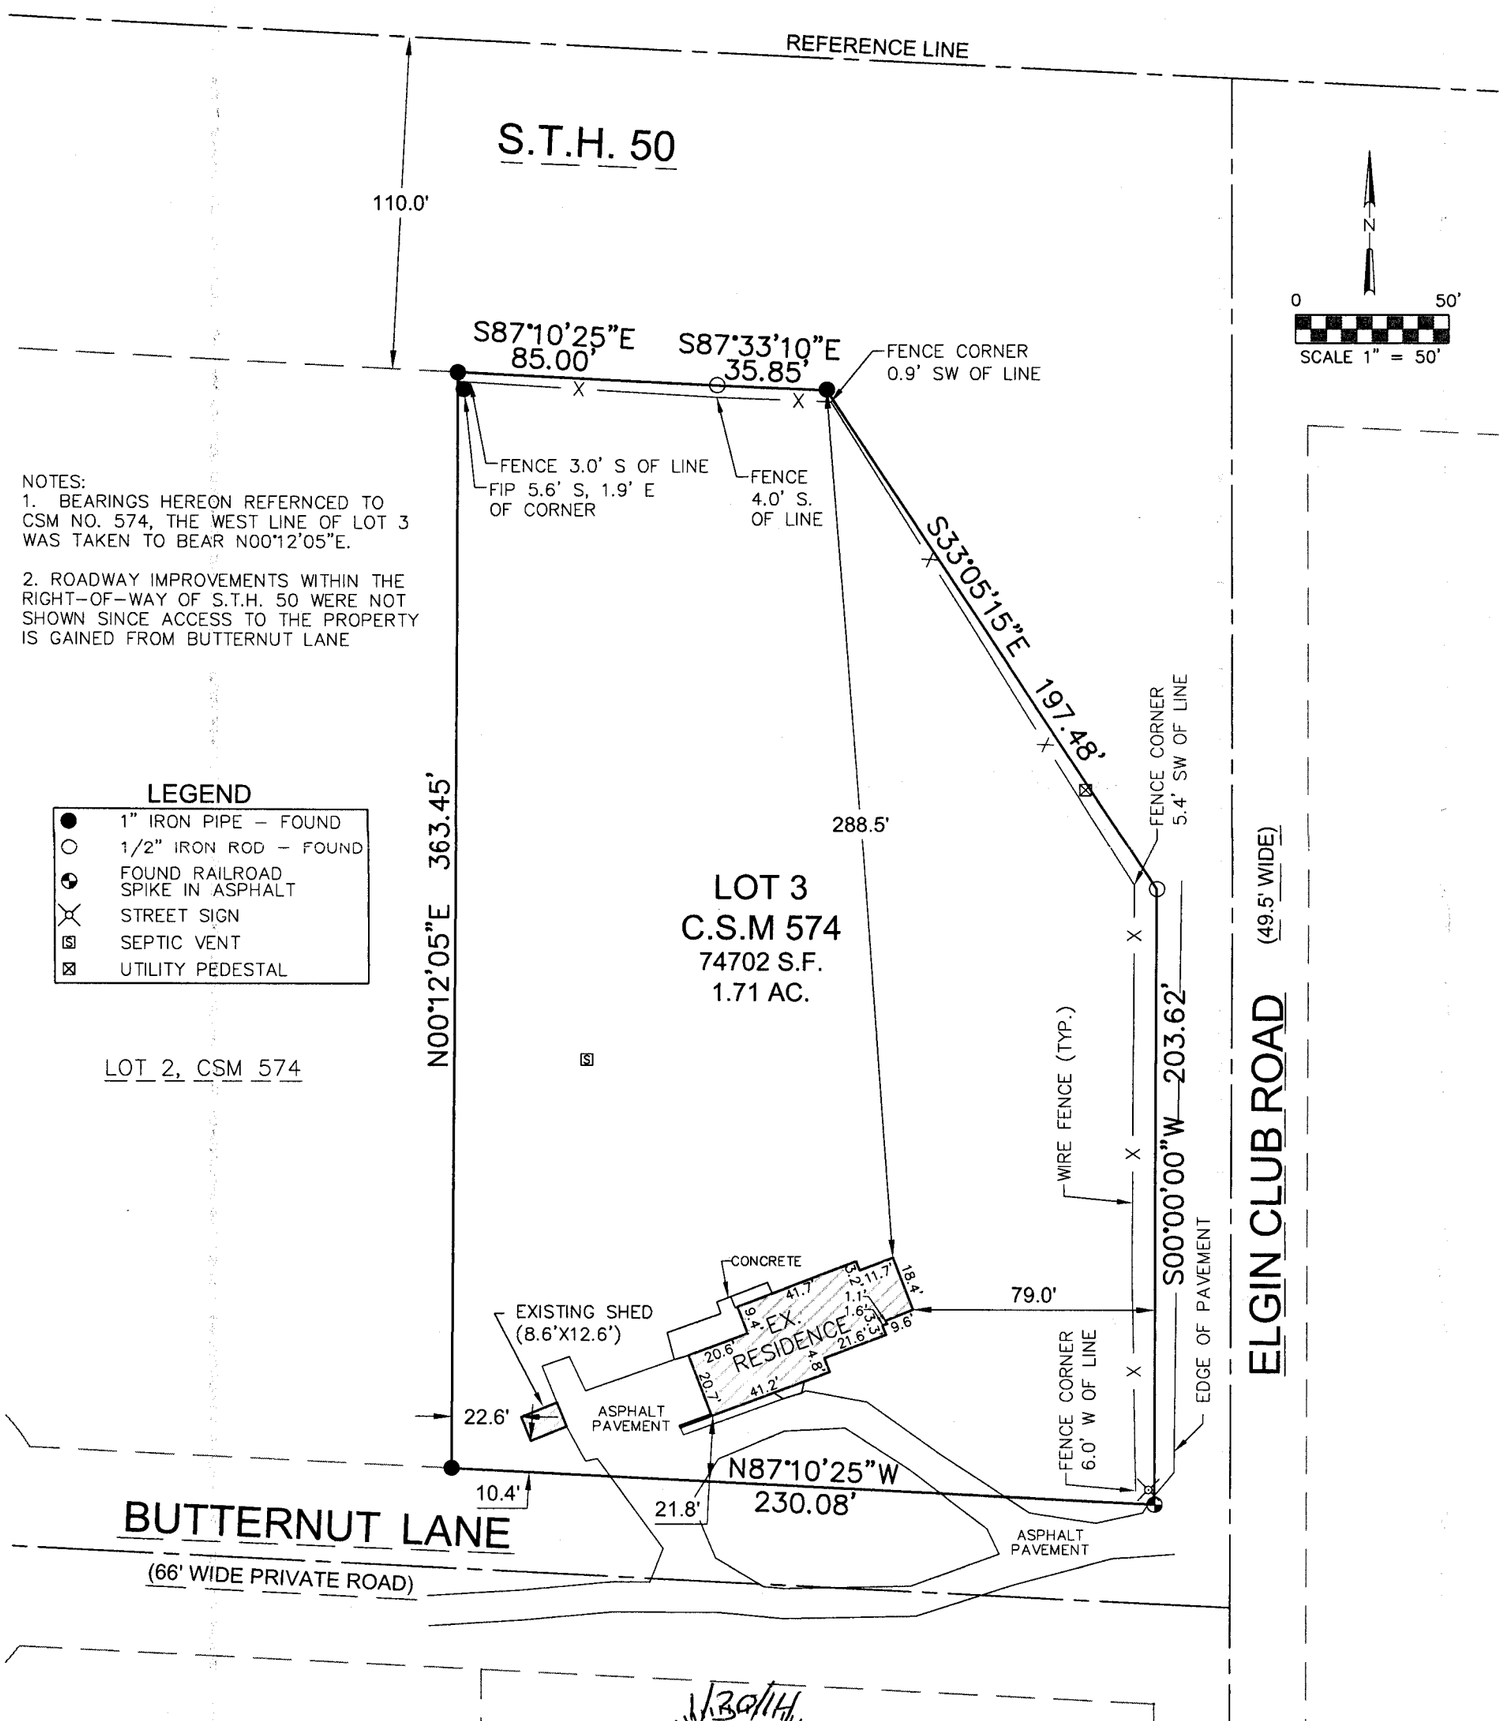

SURVEYOR'S CERTIFICATE:
THIS SURVEY IS MADE FOR THE USE OF THE PRESENT OWNERS OF THE PROPERTY, AND ALSO THOSE WHO MORTGAGE OR GUARANTEE TITLE TO WITHIN ONE (1) YEAR FROM DATE HERETO.

I, KENNETH B. MEHRING, #2838, HEREBY CERTIFY THAT THIS SURVEY WAS MADE IN ACCORDANCE WITH THE MINIMUM STANDARDS FOR PROPERTY SURVEYS (CHAPTER AE-7) FOR THE STATE OF WISCONSIN AND HAS BEEN PREPARED UNDER MY DIRECTION AND CONTROL AND IS CORRECT TO THE BEST OF MY KNOWLEDGE AND BELIEF.

KENNETH B. MEHRING, R.L.S. S-2838

WISCONSIN
KENNETH B MEHRING
S-2838
WATERFORD
WI
LAND SURVEYOR

RECEIVED
MAR 25 2014
By

LYNCH & ASSOCIATES
ENGINEERING CONSULTANTS, LLC
5492 S. WESTRIDGE DR.
NEW BERLIN, WI 53151
262-402-5040

DATE 1/30/2014
SHEET 1 OF 1
JOB#14--008

IA 574-3

117-3643