
# PLAT OF SURVEY

UNIT 9

SOUTH SHORE CLUB ON LAKE GENEVA
A CONDOMINIUM ADDENDUM NO. 1
**REC. IN CAB. A, SLIDE 508–509, DOC. NO. 692932**

LOCATED IN CERTIFIED SURVEY MAP 2631
RECORDED IN VOL. 13 OF CERTIFIED SURVEYS
ON PAGE 171, AS DOCUMENT NUMBER 311927
BEING IN ALL 1/4'S OF NE 1/4 OF
SECTION 18, TOWN 1 NORTH, RANGE 17 EAST
WALWORTH COUNTY, WISCONSIN

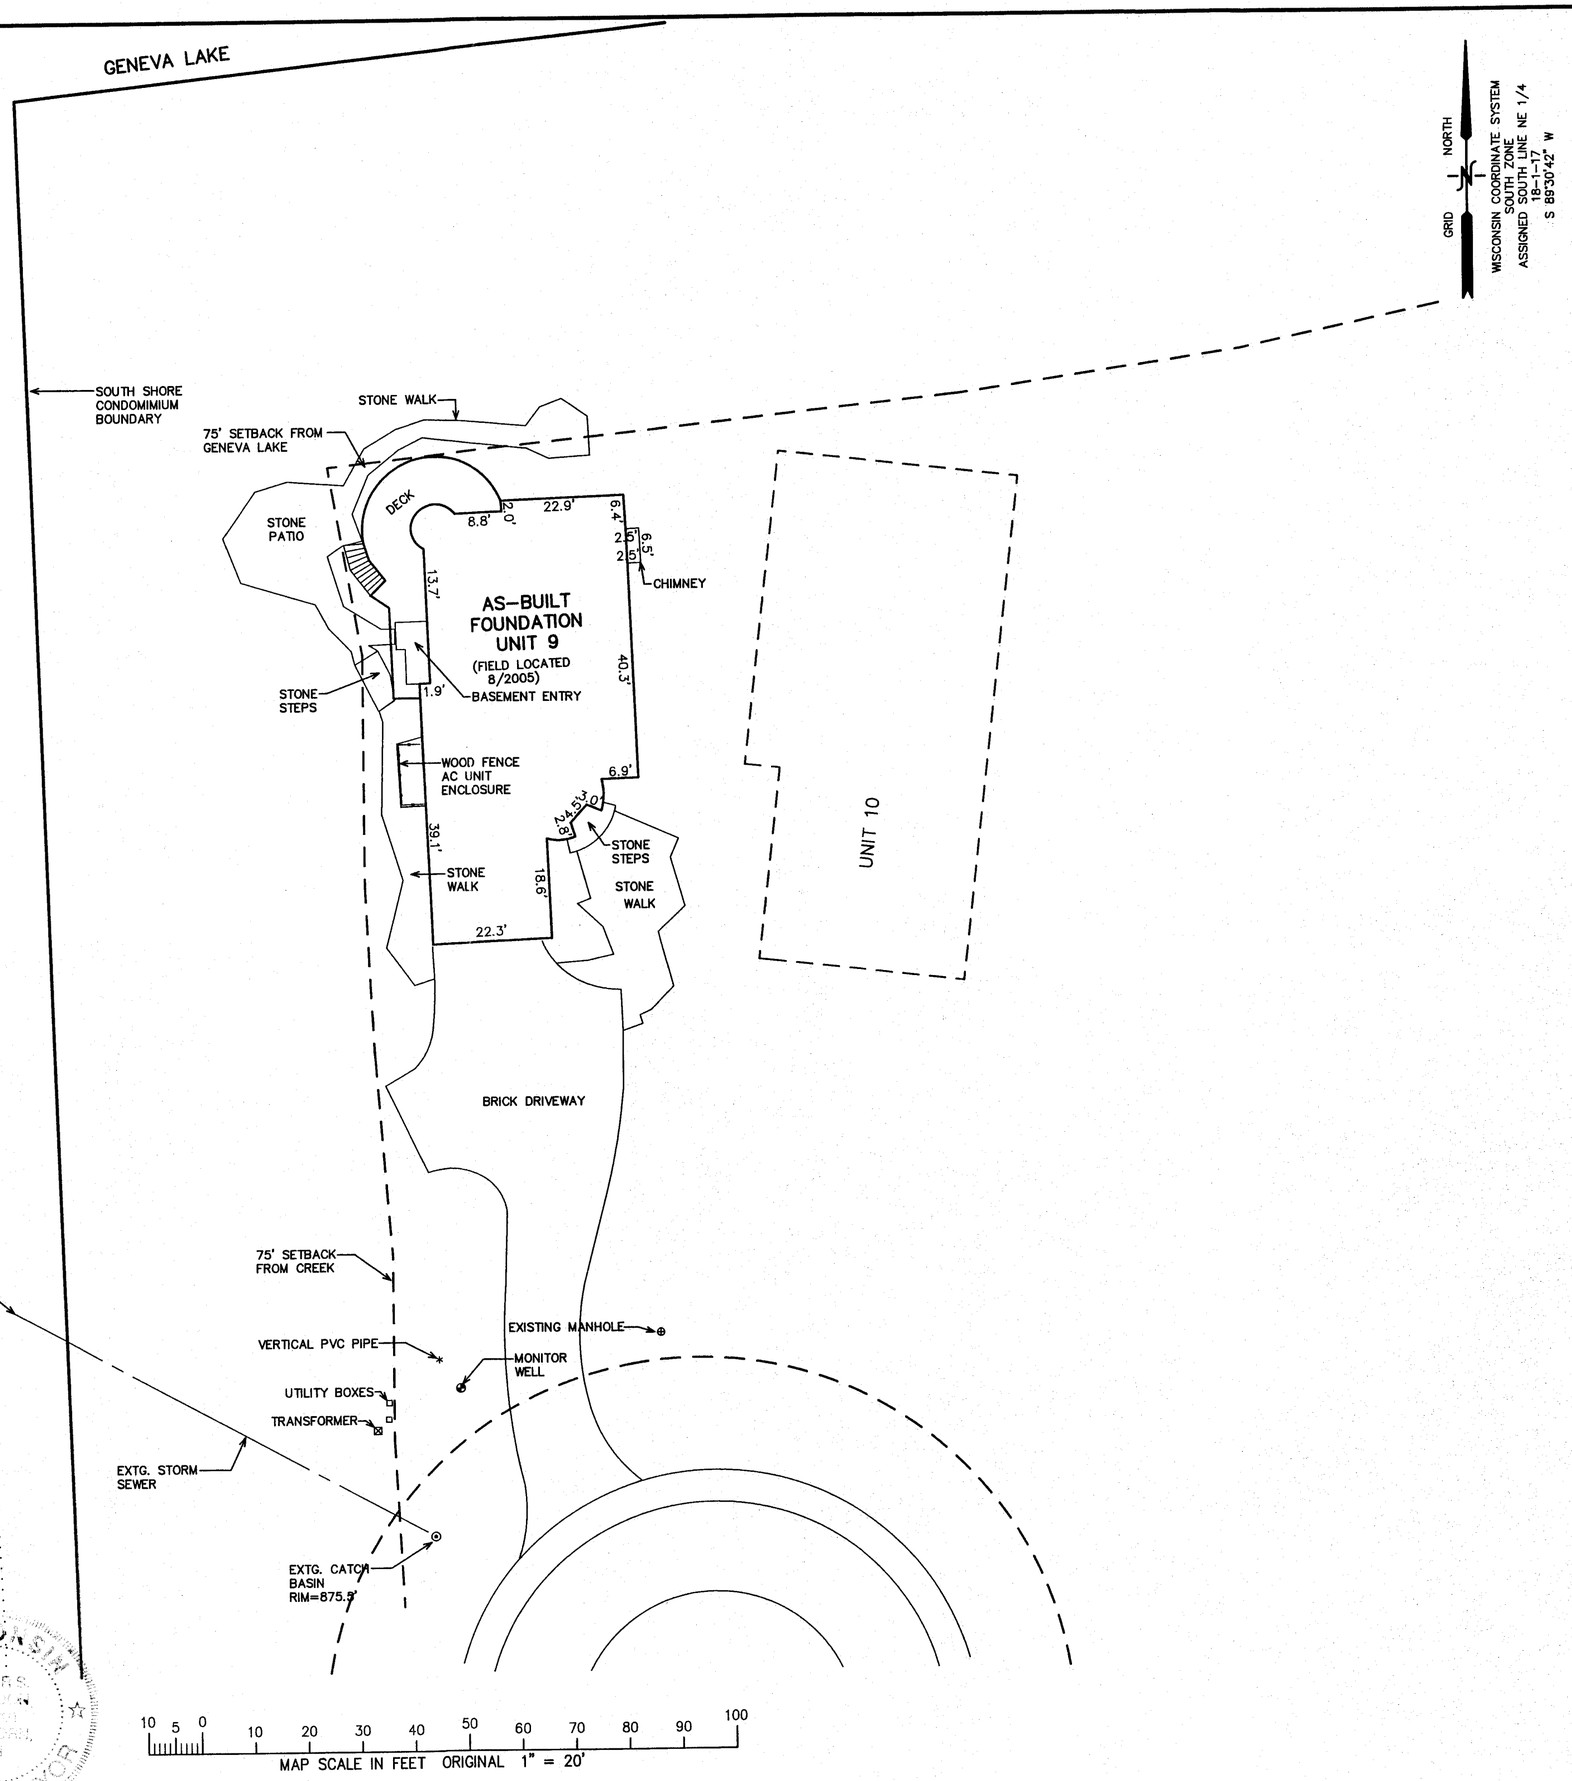


RECEIVED
SEP 5 2014
By

NOTE:
THE BOUNDARIES OF THE SUBJECT SITE ARE THE FOUNDATION WALLS OF THE BULDING AS BUILT AND SHOWN ON THIS PLAT, NO MONUMENTATION OF BOUNDARIES IS APPROPRIATE FOR THIS SURVEY.

NOTE: COPIES OF THIS MAP TO WHICH THE FOLLOWING CERTIFICATE WILL APPLY SHOW THE SURVEYOR'S ORIGINAL SEAL AND SIGNATURE IN RED INK. COPIES BY ANY OTHER MEANS MAY HAVE ALTERATIONS WHICH DO NOT REPRESENT THE SURVEYOR'S WORK PRODUCT.

I HEREBY CERTIFY THAT THE ABOVE DESCRIBED PROPERTY HAS BEEN SURVEYED UNDER MY DIRECTION AND THAT THE ABOVE MAP IS A TRUE REPRESENTATION THEREOF AND SHOWS THE SIZE AND LOCATION OF THE PROPERTY, ITS EXTERIOR BOUNDARIES, THE LOCATION OF ALL VISIBLE STRUCTURES, AND DIMENSIONS OF ALL PRINCIPLE BUILDINGS THEREON, BOUNDARY FENCES, APPARENT EASEMENTS, ROADWAYS, AND VISIBLE ENCROACHMENTS, IF ANY. THIS SURVEY IS MADE FOR THE USE OF THE PRESENT OWNERS OF THE PROPERTY, AND ALSO THOSE WHO PURCHASE, MORTGAGE, OR GUARANTEE THE TITLE THERETO WITHIN ONE YEAR FROM THE DATE HEREOF.

DATED: APRIL 29, 2005 RESURVEYED 8/26/2014

PETER S. GORDON

WISCONSIN PETER S. GORDON ENGINEER-SURVEYOR

– WORK ORDERED BY –
KEVIN BATZ – ORREN PICKELL
200 TRI–STATE INTERNATIONAL, SUITE 200
LINCOLNSHIRE, WI 60069


FARRIS, HANSEN & ASSOCIATES, INC.
ENGINEERING – ARCHITECTURE – SURVEYING
7 RIDGWAY COURT P.O. BOX 437
ELKHORN, WISCONSIN 53121
OFFICE: (262) 723–2098 FAX: (262) 723–5886


REVISIONS

PROJECT NO. 4161.09
DATE: 04/29/05
SHEET NO. 1 OF 1

AUG 27 2014

8/27/2014 X:\Projects\4161\INDV_LOTS\Lot_9\4161.09.14\Dcad\TITSUR_UNIT09

I88c–9 117-3672