

PREPARED FOR:
JOHN MATUSTIK
MATUSTIK BUILDERS
2413 W. ALGONQUIN RD., SUITE 515
ALGONQUIN, IL 60102

SURVEY ADDRESS:
N1983 BIRCHES DRIVE


PLAT OF SURVEY

-OF-


LYNCH & ASSOCIATES
ENGINEERING CONSULTANTS, LLC.
5482 S. WESTRIDGE DR.
NEW BERLIN, WI 53151
(262) 248-3697

LOT NO. 3 OF THE BIRCHES FIRST ADDITION, ACCORDING TO THE RECORDED PLAT THEREOF ON
RECORD IN THE OFFICE OF THE REGISTER OF DEEDS IN AND FOR WALWORTH COUNTY, AND
LOCATED IN THE NORTHEAST 1/4 OF SECTION 9, TOWNSHIP 1 NORTH, RANGE 17 EAST, TOWN OF
LINN, WALWORTH COUNTY, WISCONSIN.

NOTE: EXISTING STRUCTURES AND IMPROVEMENTS
WERE NOT SHOWN TO IMPROVE MAP CLARITY.

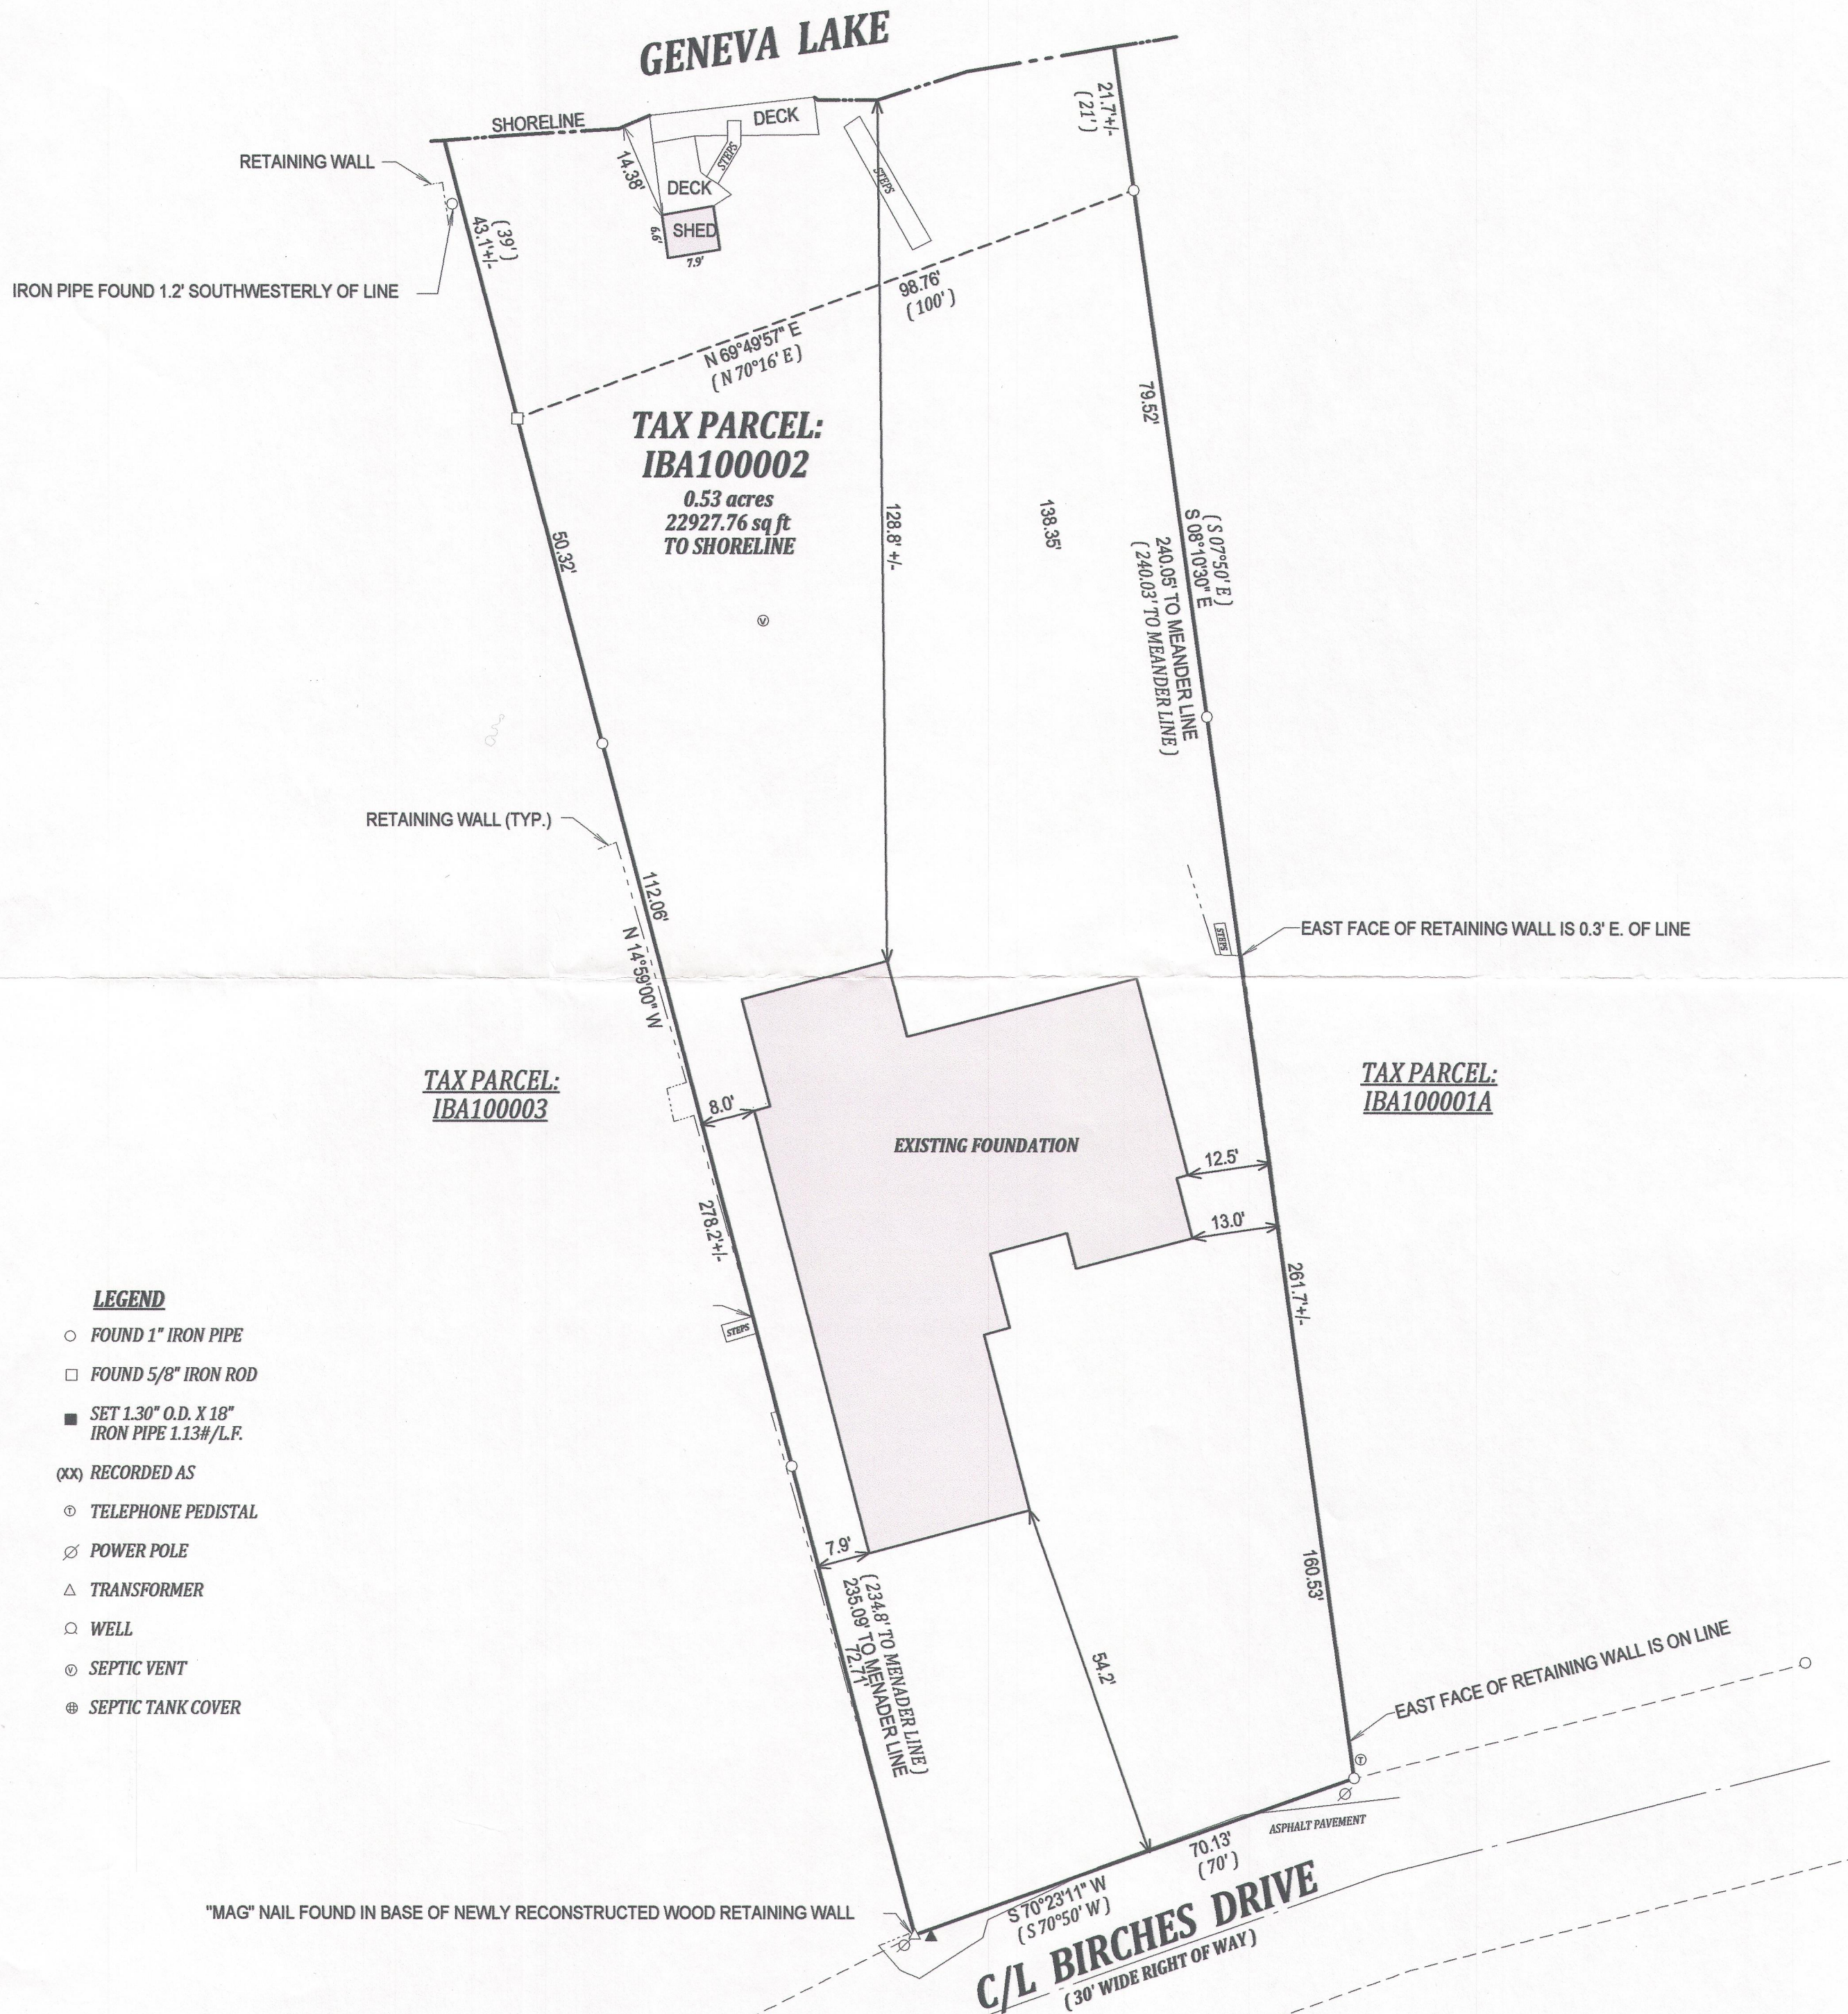


JOB # 14-610
TAX ID # IBA 100002

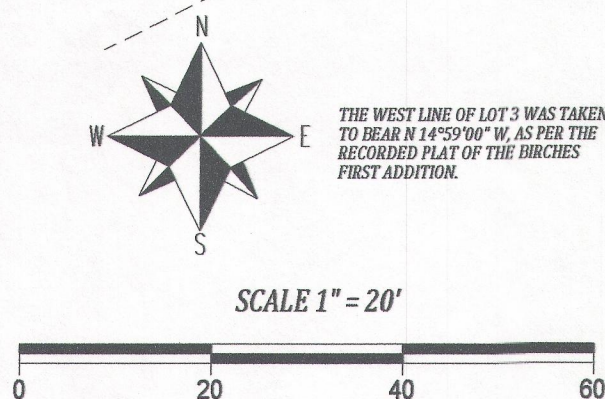

NOTE:
No title commitment or results of a title search were provided to
this office pertaining to this survey. This Plat Of Survey may not
reflect easements of record, encumbrances, restrictions,
ownership, title evidence, or other facts that a current and
accurate title search may disclose.

I have surveyed the above-described property and the above map is
a true representation thereof and shows the size and location of the
property, its exterior boundaries, the location and dimensions of all
structures thereon, fences apparent easements and roadways and
visible encroachments, if any.

This survey is made for the exclusive use of the present owners of
the property, and also those who purchase, mortgage, or insure the
title thereto within one (1) year from date hereof; and as to them I
warrant the accuracy of said survey map.

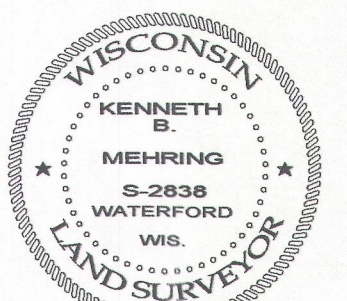

DATED THIS 3rd DAY OF APRIL, 2014
REVISED THIS 25th DAY OF AUGUST, 2014
LAST REVISED THIS 16th DAY OF OCTOBER, 2014

KENNETH B. MEHRING S - 2838
Wisconsin Registered Land Surveyor
(original if signed in red)

IBA1 - 2

117-3691