
FARRIS, HANSEN & ASSOCIATES, INC.

ENGINEERING – ARCHITECTURE – SURVEYING
7 RIDGWAY COURT – P.O. BOX 437 – ELKHORN, WISCONSIN 53121
PHONE: (262) 723–2098 FAX: (262) 723–5886

PLAT OF SURVEY

LOT 4 BLOCK 1 OF FOREST REST
A SUBDIVISION LOCCATED IN THE SE 1/4 OF THE SW 1/4 SEC. 35, T2N, R17E
& THE NE 1/4 OF HE NW 1/4 SEC. 2, T1N, R17E
WALWORTH COUNTY, WISCONSIN

– WORK ORDERED BY –
PATRICIA PETERSEN
10451 ST. ANDREWS ROAD
BOYNTON BEACH, FL. 33436

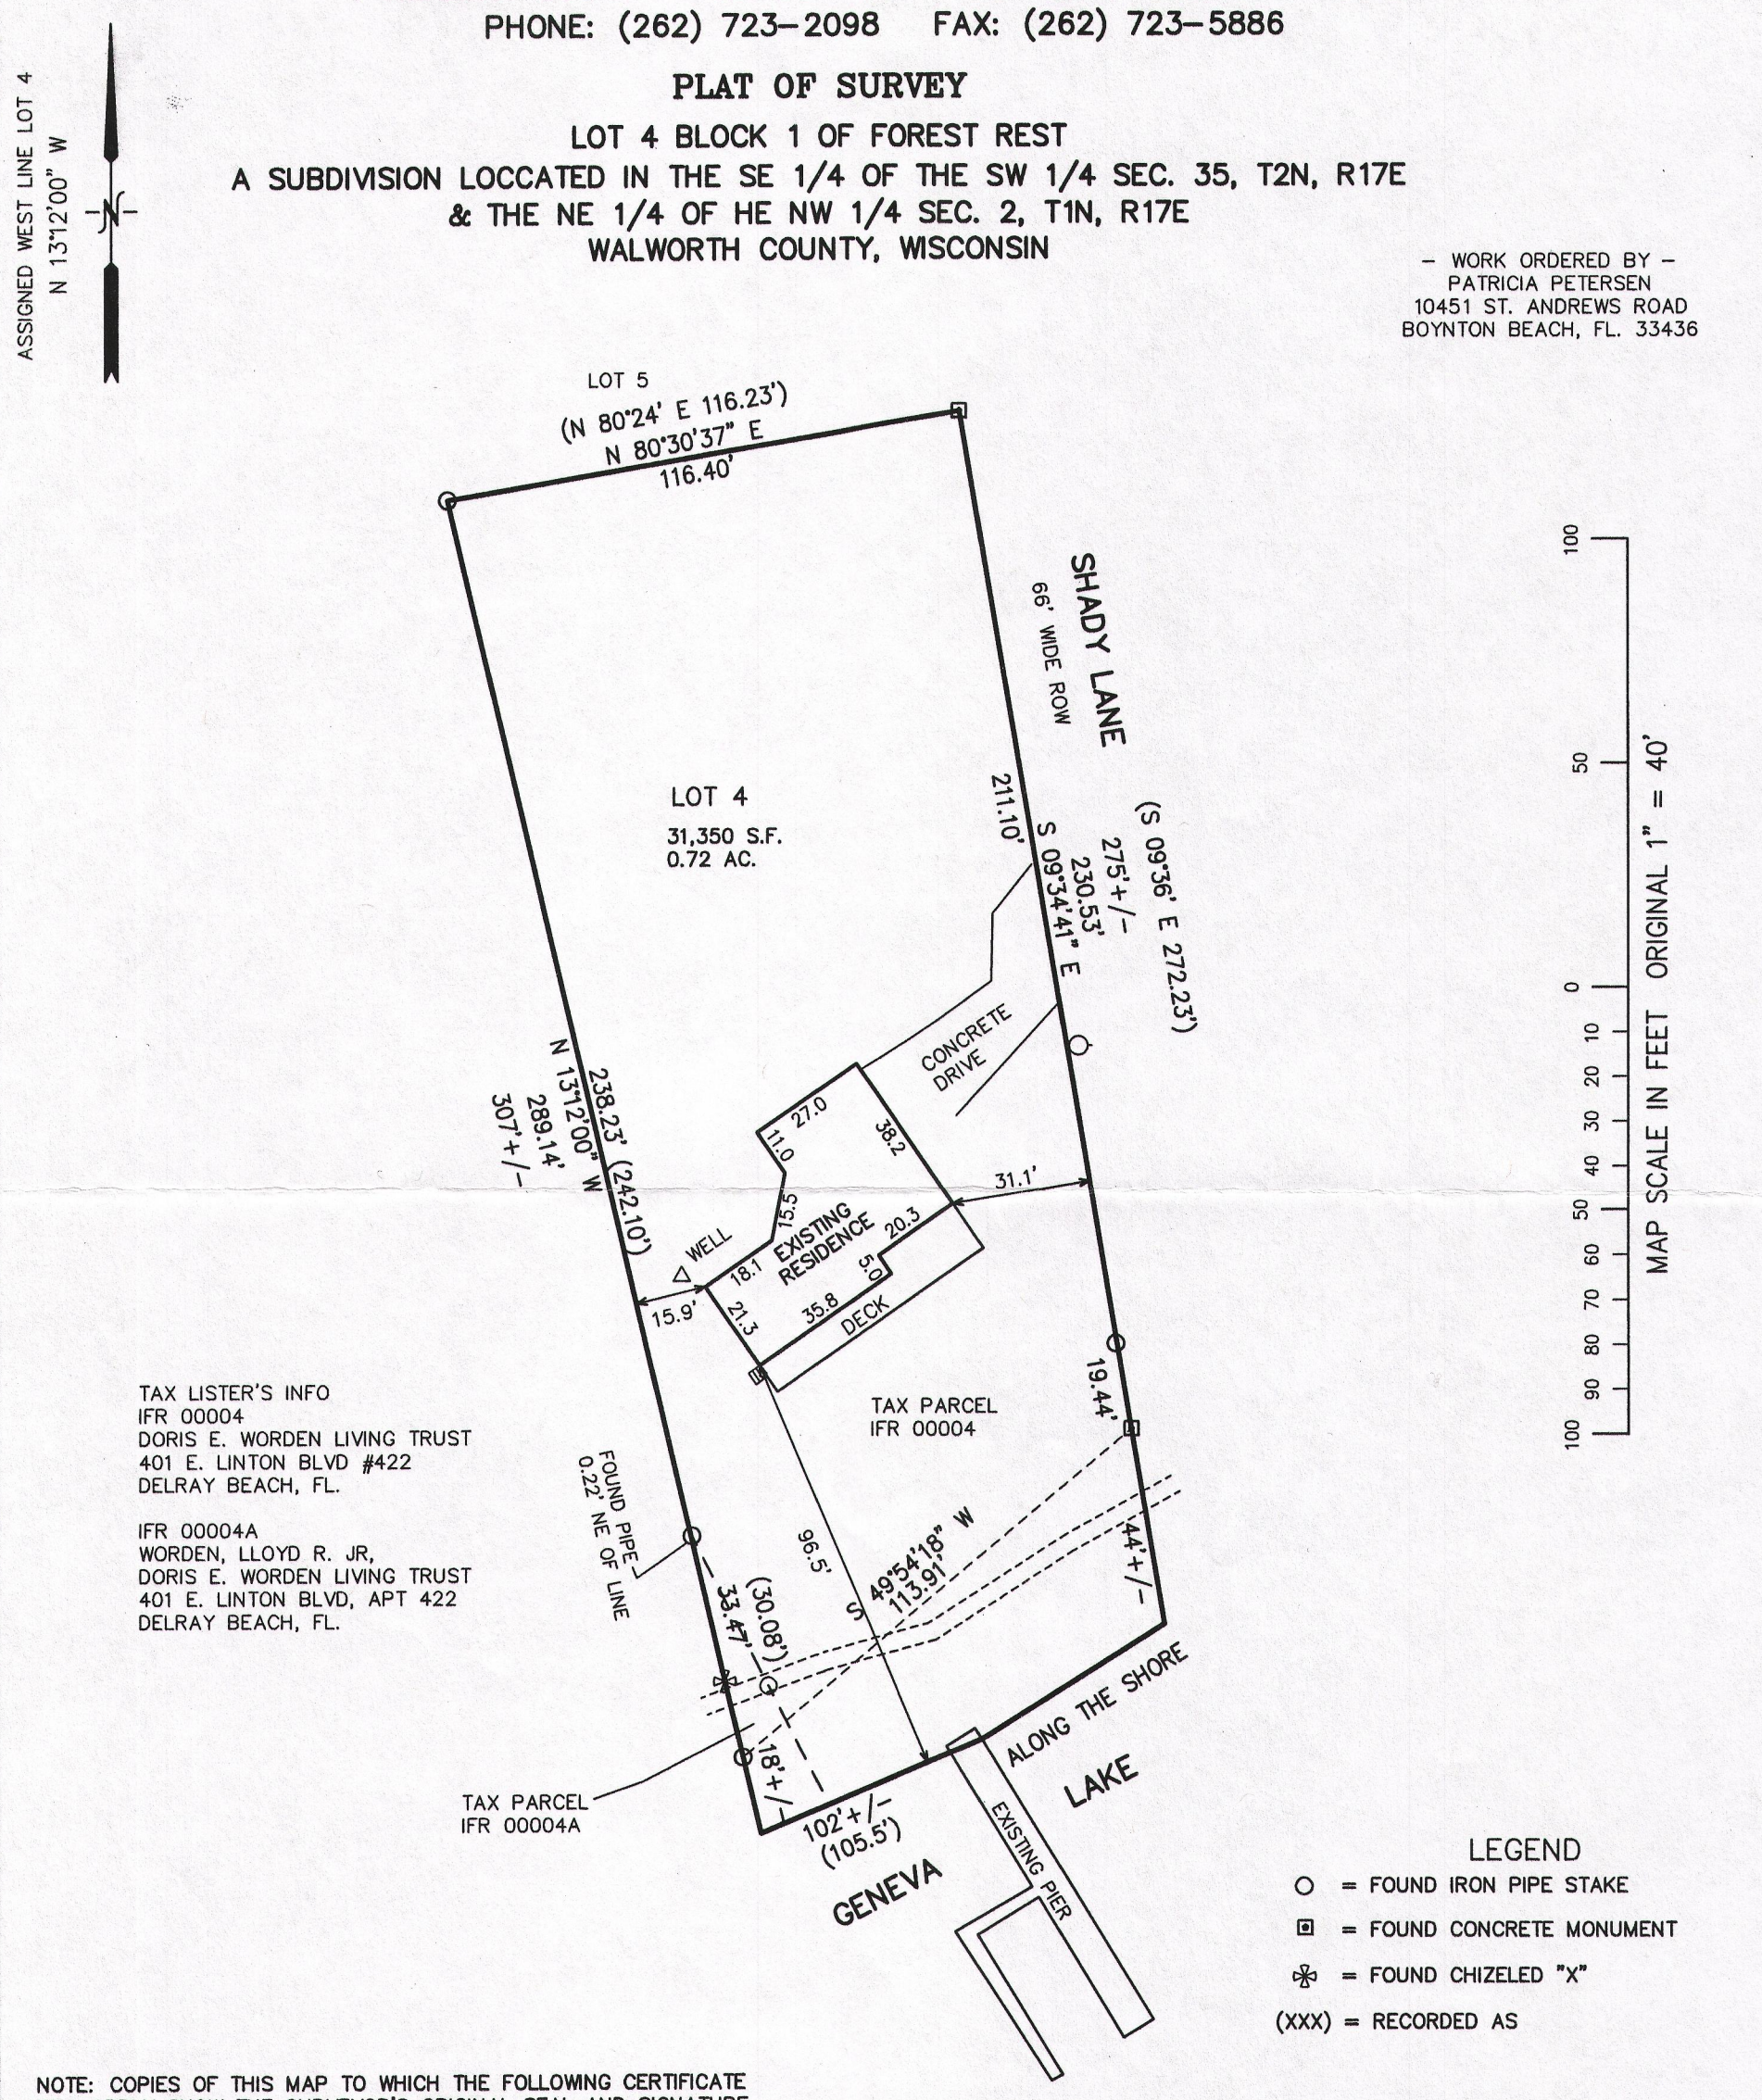

TAX LISTER'S INFO
IFR 00004
DORIS E. WORDEN LIVING TRUST
401 E. LINTON BLVD #422
DELRAY BEACH, FL.

IFR 00004A
WORDEN, LLOYD R. JR,
DORIS E. WORDEN LIVING TRUST
401 E. LINTON BLVD, APT 422
DELRAY BEACH, FL.

LEGEND
○ = FOUND IRON PIPE STAKE
▣ = FOUND CONCRETE MONUMENT
✠ = FOUND CHIZELED "X"
(XXX) = RECORDED AS

NOTE: COPIES OF THIS MAP TO WHICH THE FOLLOWING CERTIFICATE WILL APPLY SHOW THE SURVEYOR'S ORIGINAL SEAL AND SIGNATURE IN RED INK. COPIES BY ANY OTHER MEANS MAY HAVE ALTERATIONS WHICH DO NOT REPRESENT THE SURVEYOR'S WORK PRODUCT.

I HEREBY CERTIFY THAT THE ABOVE DESCRIBED PROPERTY HAS BEEN SURVEYED UNDER MY DIRECTION AND THAT THE ABOVE MAP IS A TRUE REPRESENTATION THEREOF AND SHOWS THE SIZE AND LOCATION OF THE PROPERTY AND ITS EXTERIOR BOUNDARIES. THIS SURVEY IS MADE FOR THE USE OF THE PRESENT OWNERS OF THE PROPERTY, AND ALSO THOSE WHO PURCHASE, MORTGAGE, OR GUARANTEE THE TITLE THERETO WITHIN ONE YEAR FROM THE DATE HEREOF.

DATED: OCTOBER 10, 2014

PETER S. GORDON R.L.S. 2101

WISCONSIN
PETER S. GORDON
S-2101
ELKHORN, WI
LAND SURVEYOR

RECEIVED
JAN 6 2015
By jan

PROJECT: 9156
DATE: 10–10–2014
SHEET 1 OF 1

10/10/2014 X:\Projects\9156\dcad\survey

OCT 10 2014

IFR–4
±FR–4A

117-3729