Pinter

HAROLD H. KOLB

REGISTERED PROFESSIONAL LAND SURVEYOR
LAKE GENEVA, WISCONSIN

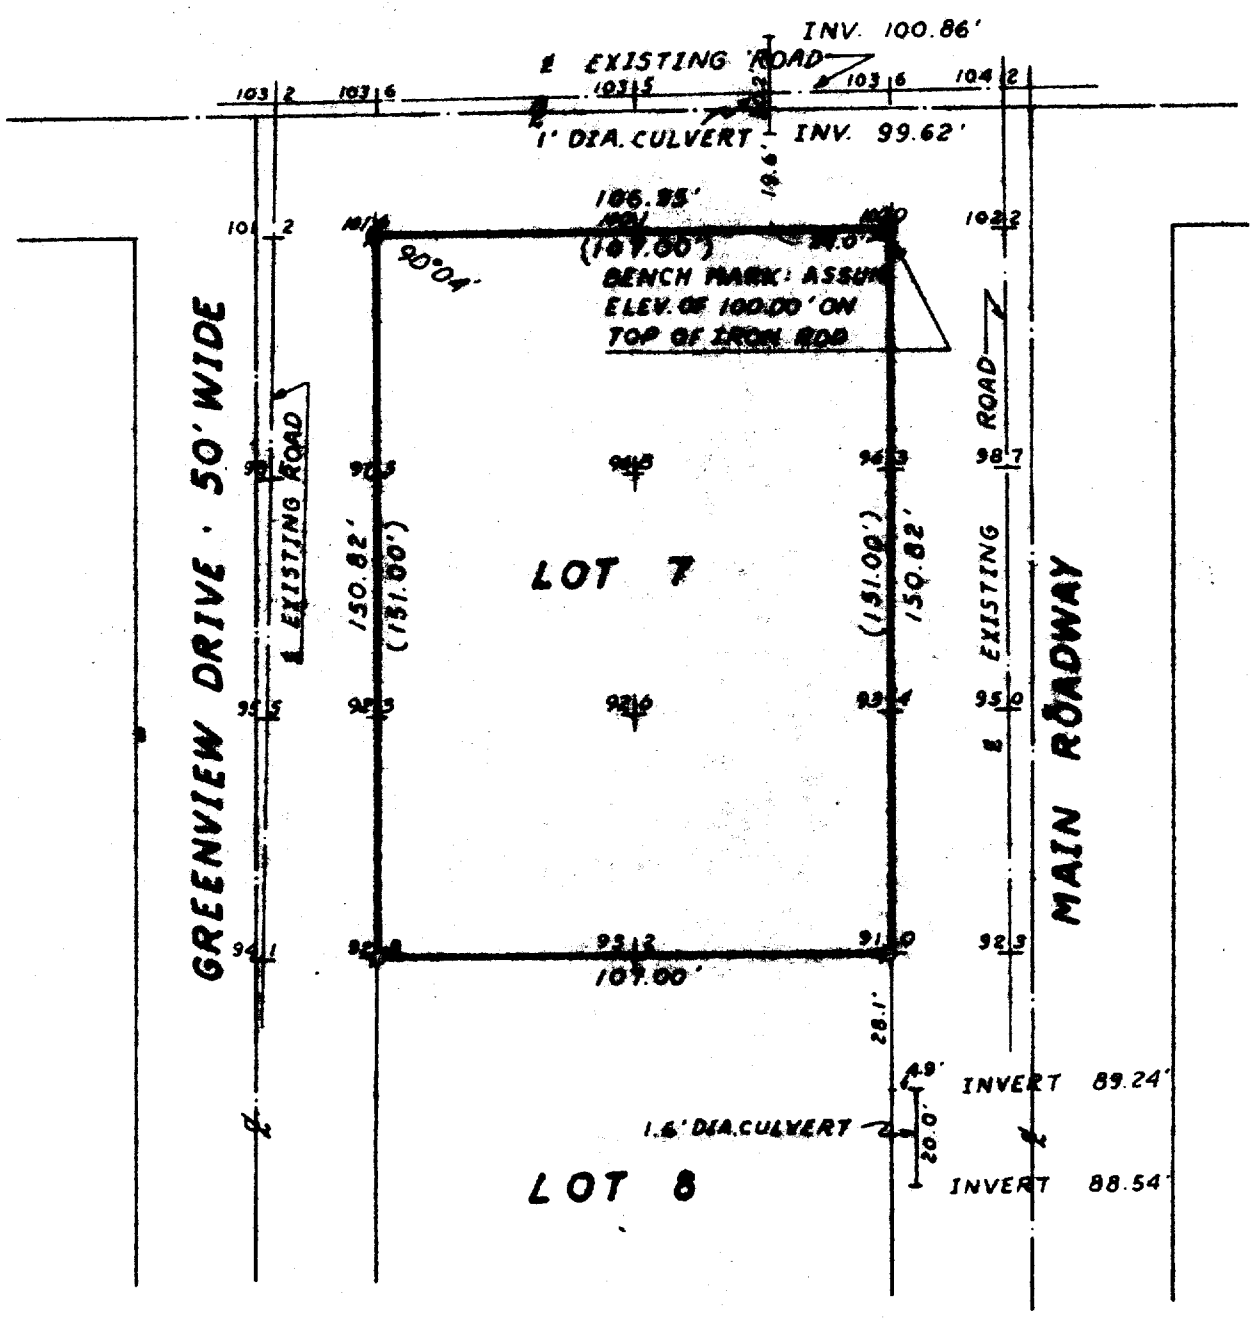

PLAT OF SURVEY OF

Lot 7, Sunset Hills Shores Subdivision,

located in the Northwest ¼ of Section 4,

T 1 N, R 17 E, Walworth County, Wisconsin.

N

SCALE: 1" = 40'

LEGEND

- ⌀ — IRON PIPE FOUND
- o — IRON PIPE PLACED
- ⌀ — Iron Rod Found
- x — SPIKE
- ( ) — As Platted

HAROLD H. KOLB S-187 LAKE GENEVA, WIS. LAND SURVEYOR

I, HAROLD H. KOLB, DO HEREBY CERTIFY THAT I HAVE SURVEYED THE PROPERTY HEREON DESCRIBED ACCORDING TO THE OFFICIAL RECORDS, AND THAT THE PLAT HEREON IS A CORRECT REPRESENTATION OF THE LOT LINES.

Harold H. Kolb

HAROLD H. KOLB
WISCONSIN REGISTERED LAND SURVEYOR, S-187
DATE March 15, 1973

ISH S-7

117-373