


SURVEY ADDRESS:
N2454 FOREST REST LANE

-OF-

LOT 1, BLOCK 1, FOREST REST SUBDIVISION, LOCATED IN THE
SE 1/4 OF THE SW 1/4 OF SECTION 35, T2N, R17E, AND THE NE
1/4 OF THE NW 1/4 OF SECTION 2, T1N, R17E, TOWN OF LINN,
WALWORTH COUNTY, WISCONSIN

LYNCH & ASSOCIATES
ENGINEERING CONSULTANTS, LLC.
5482 S. WESTRIDGE DR.
NEW BERLIN, WI 53151
(262) 248-3697

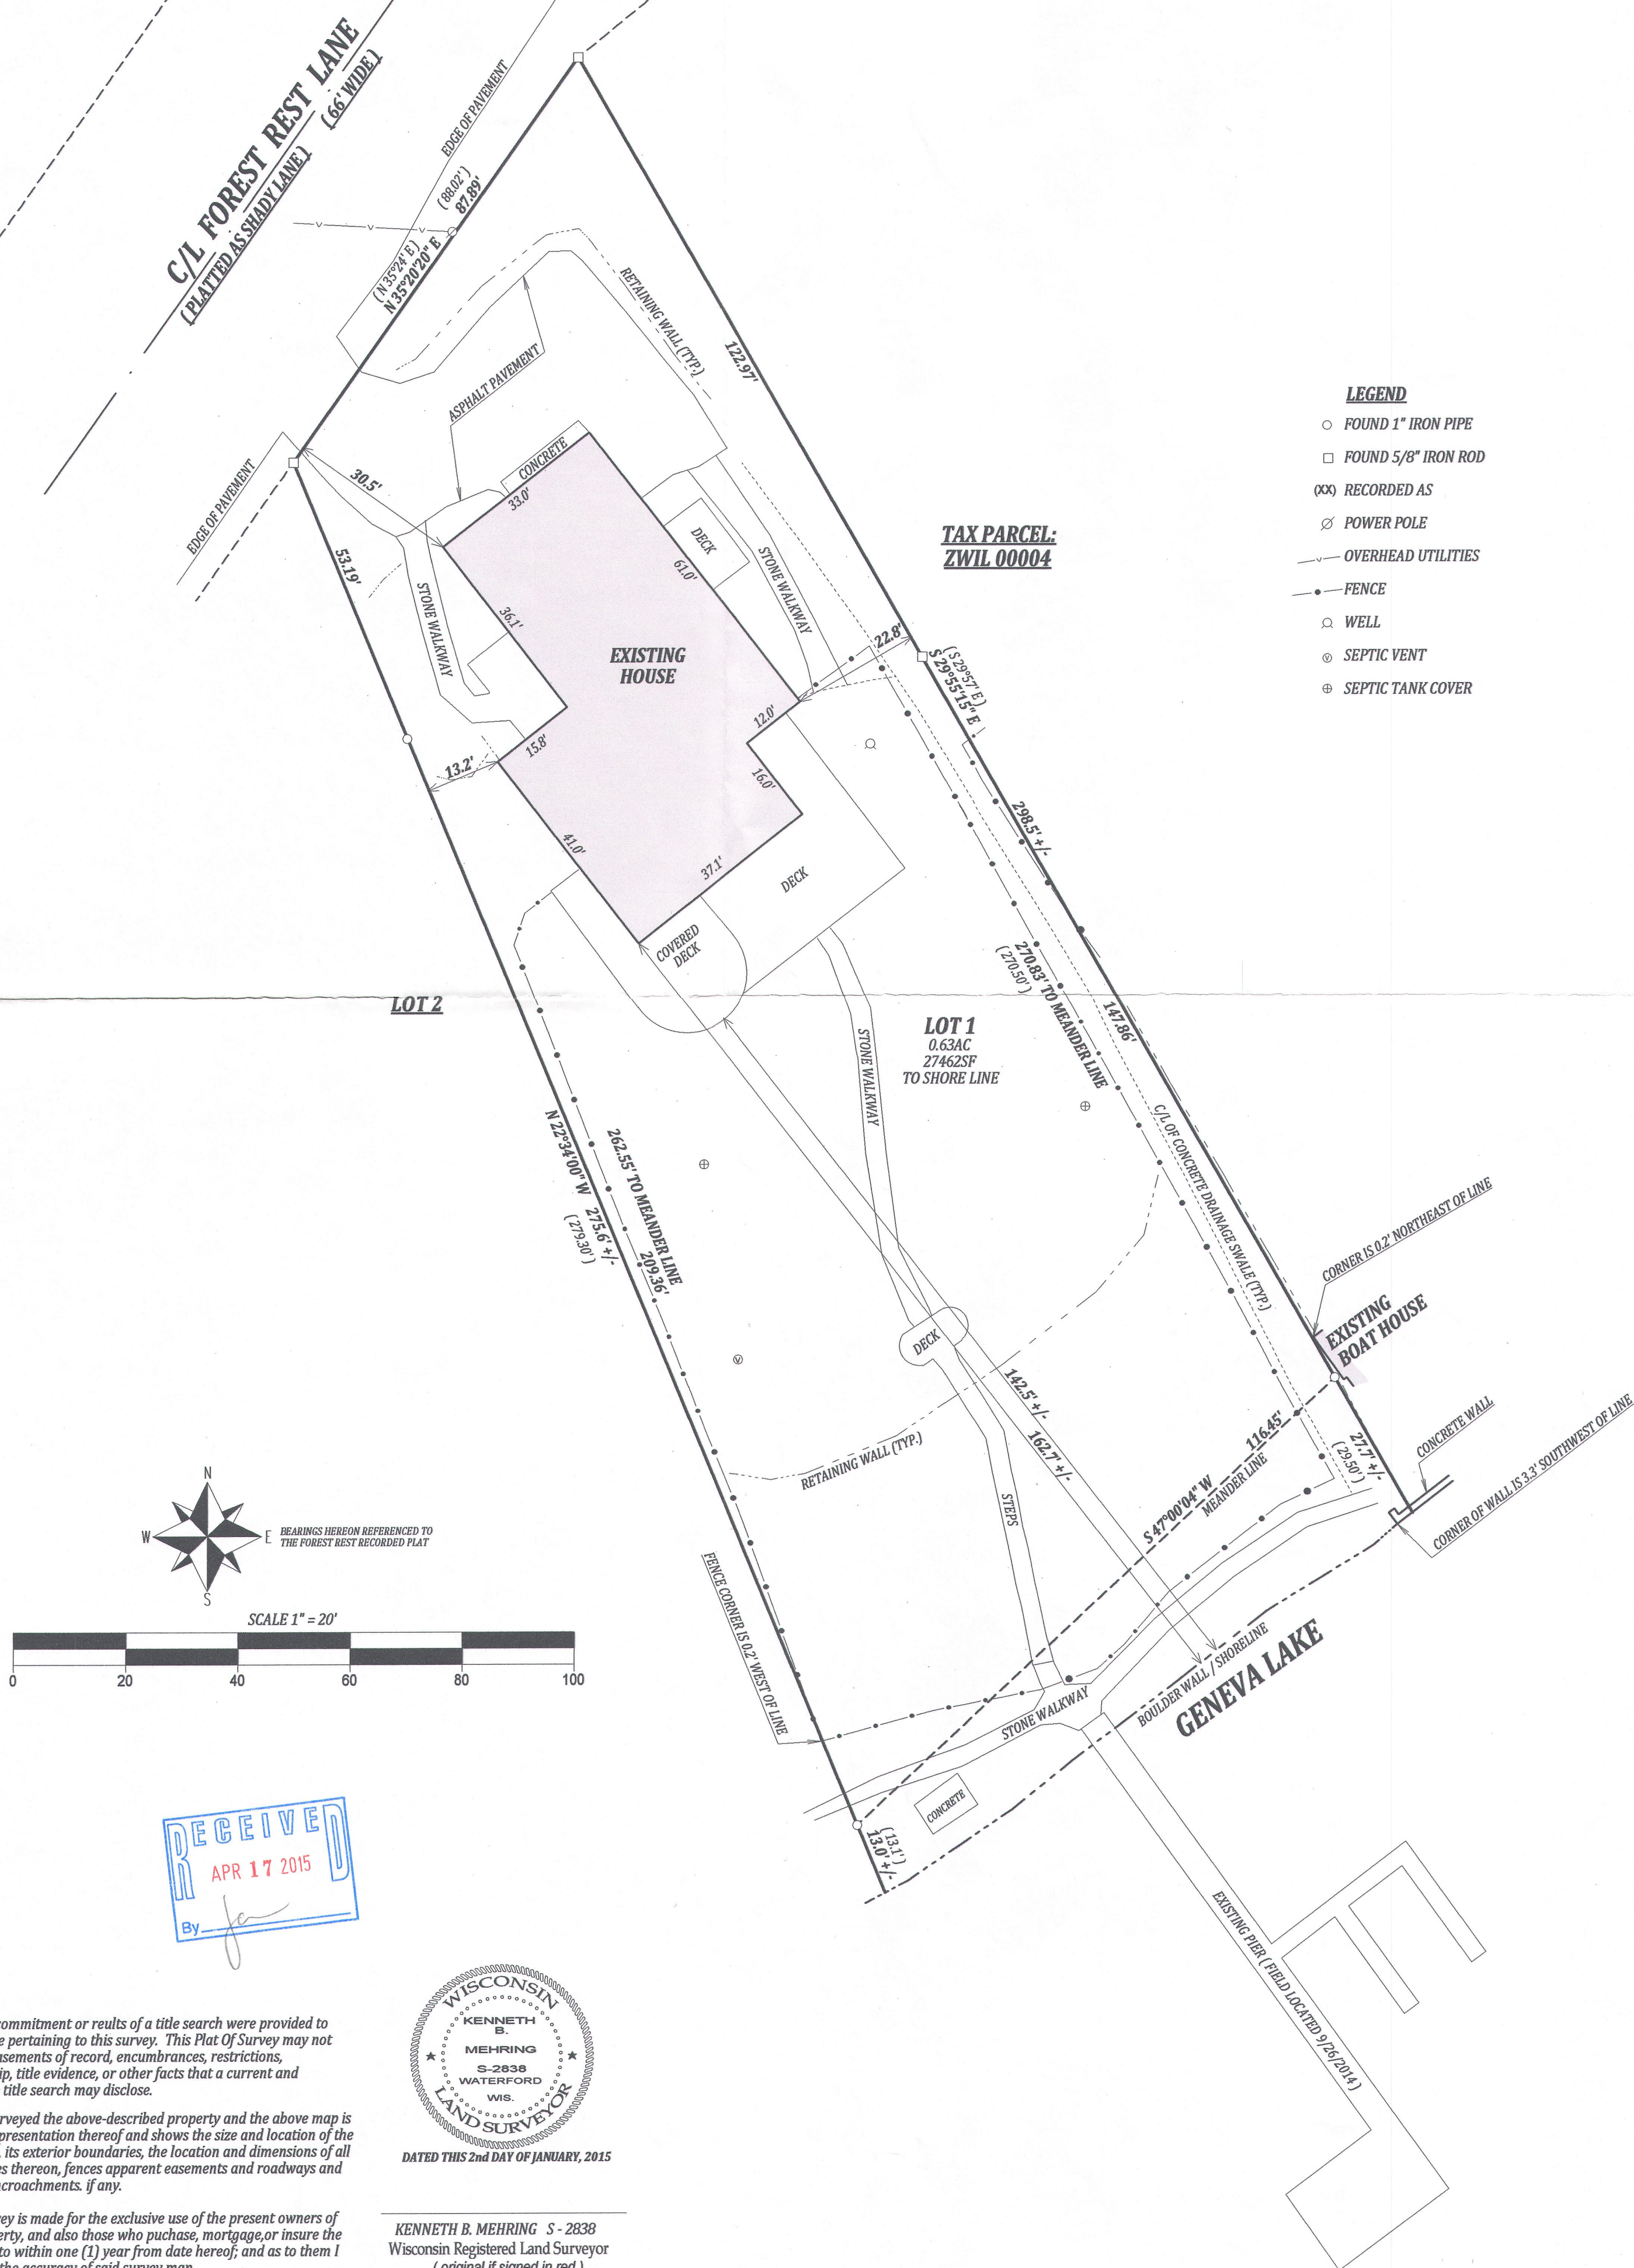

JOB # 14-627 PCS
TAX ID # IFR 00001

IFR-1 117-3772