


Plat of Survey

of



Lot 32 of Lake Geneva Highlands,

a subdivision located in Government Lot 1 in the Southeast 1/4 of Section 8,
Town 1 North, Range 17 East, Town of Linn, Walworth County, Wisconsin.

Surveyed for: **Keefe Real Estate, Inc.**
751 Geneva Parkway * P.O. Box 460
Lake Geneva, Wisconsin. 53147

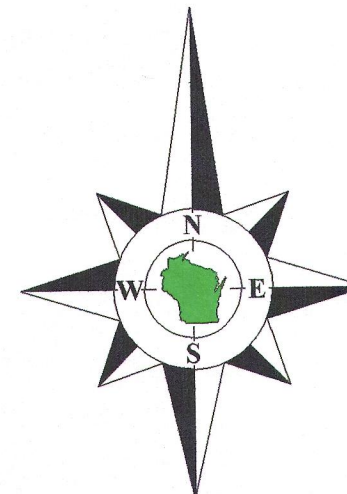

Bearings reference to the West line of
Oakland Road, assumed as South.

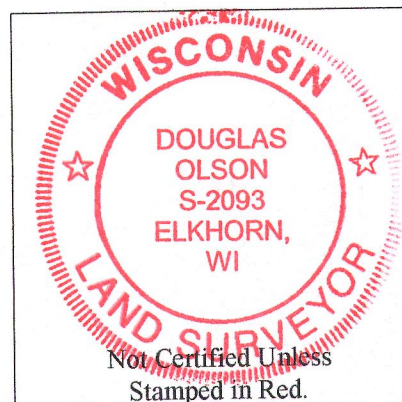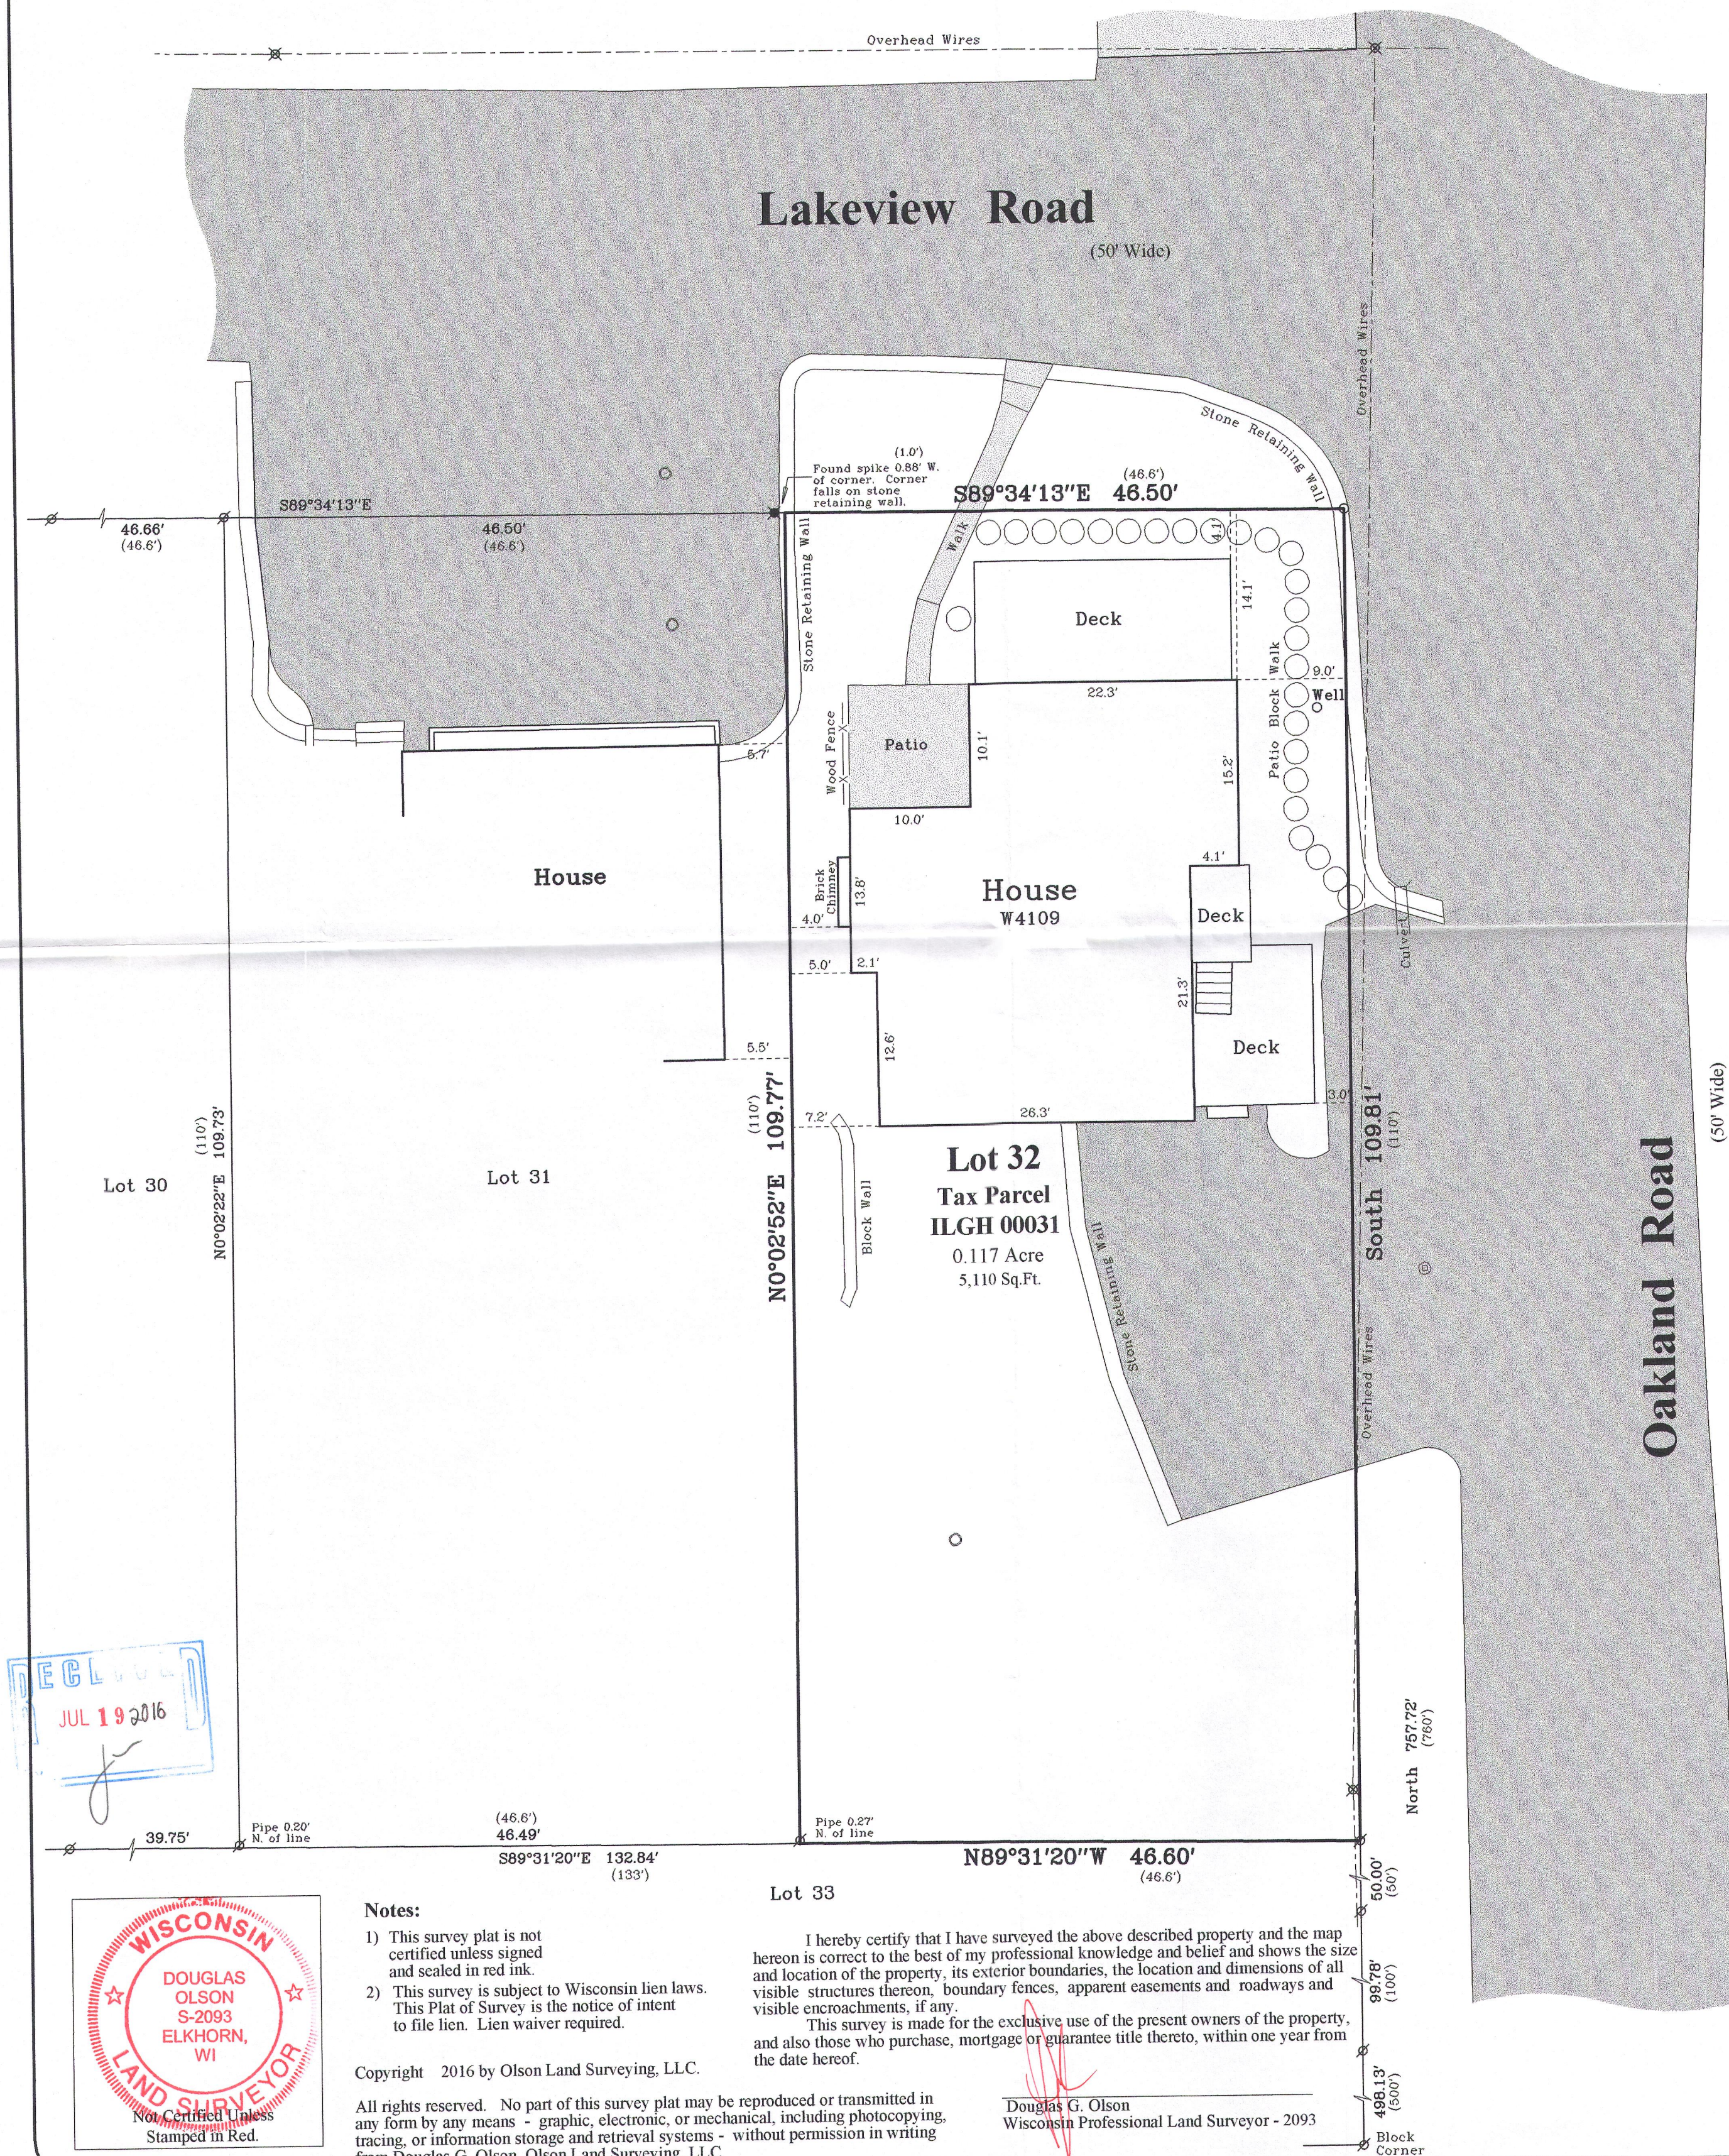

Notes:

- This survey plat is not certified unless signed and sealed in red ink.
- This survey is subject to Wisconsin lien laws. This Plat of Survey is the notice of intent to file lien. Lien waiver required.

Copyright 2016 by Olson Land Surveying, LLC.

All rights reserved. No part of this survey plat may be reproduced or transmitted in any form by any means - graphic, electronic, or mechanical, including photocopying, tracing, or information storage and retrieval systems - without permission in writing from Douglas G. Olson, Olson Land Surveying, LLC.

Douglas G. Olson
Wisconsin Professional Land Surveyor - 2093

2016.064

Sheet 1 of 1 Sheets

Drawing Name:

Job Reference Number

2016.064

Legend

- Found Iron Pipe
- Found Nail
- Set Iron Pipe, 1" dia.
- Recorded Information
- Utility Pole
- Concrete Cover
- Catch Basin
- Asphalt Surface
- Concrete




Olson Land Surveying, LLC

45 South Wisconsin Street * P.O. Box 322 * Elkhorn, Wisconsin. 53121

Telephone: (262) 723-3434 * Facsimile: (262) 723-8044

Email: doug@olsonsurveying.com

Scale in Feet
1" = 10'

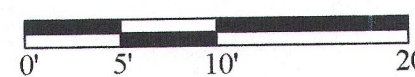

Survey Date: June 15, 2016.
Revisions:

ILGH-31 117-3918