



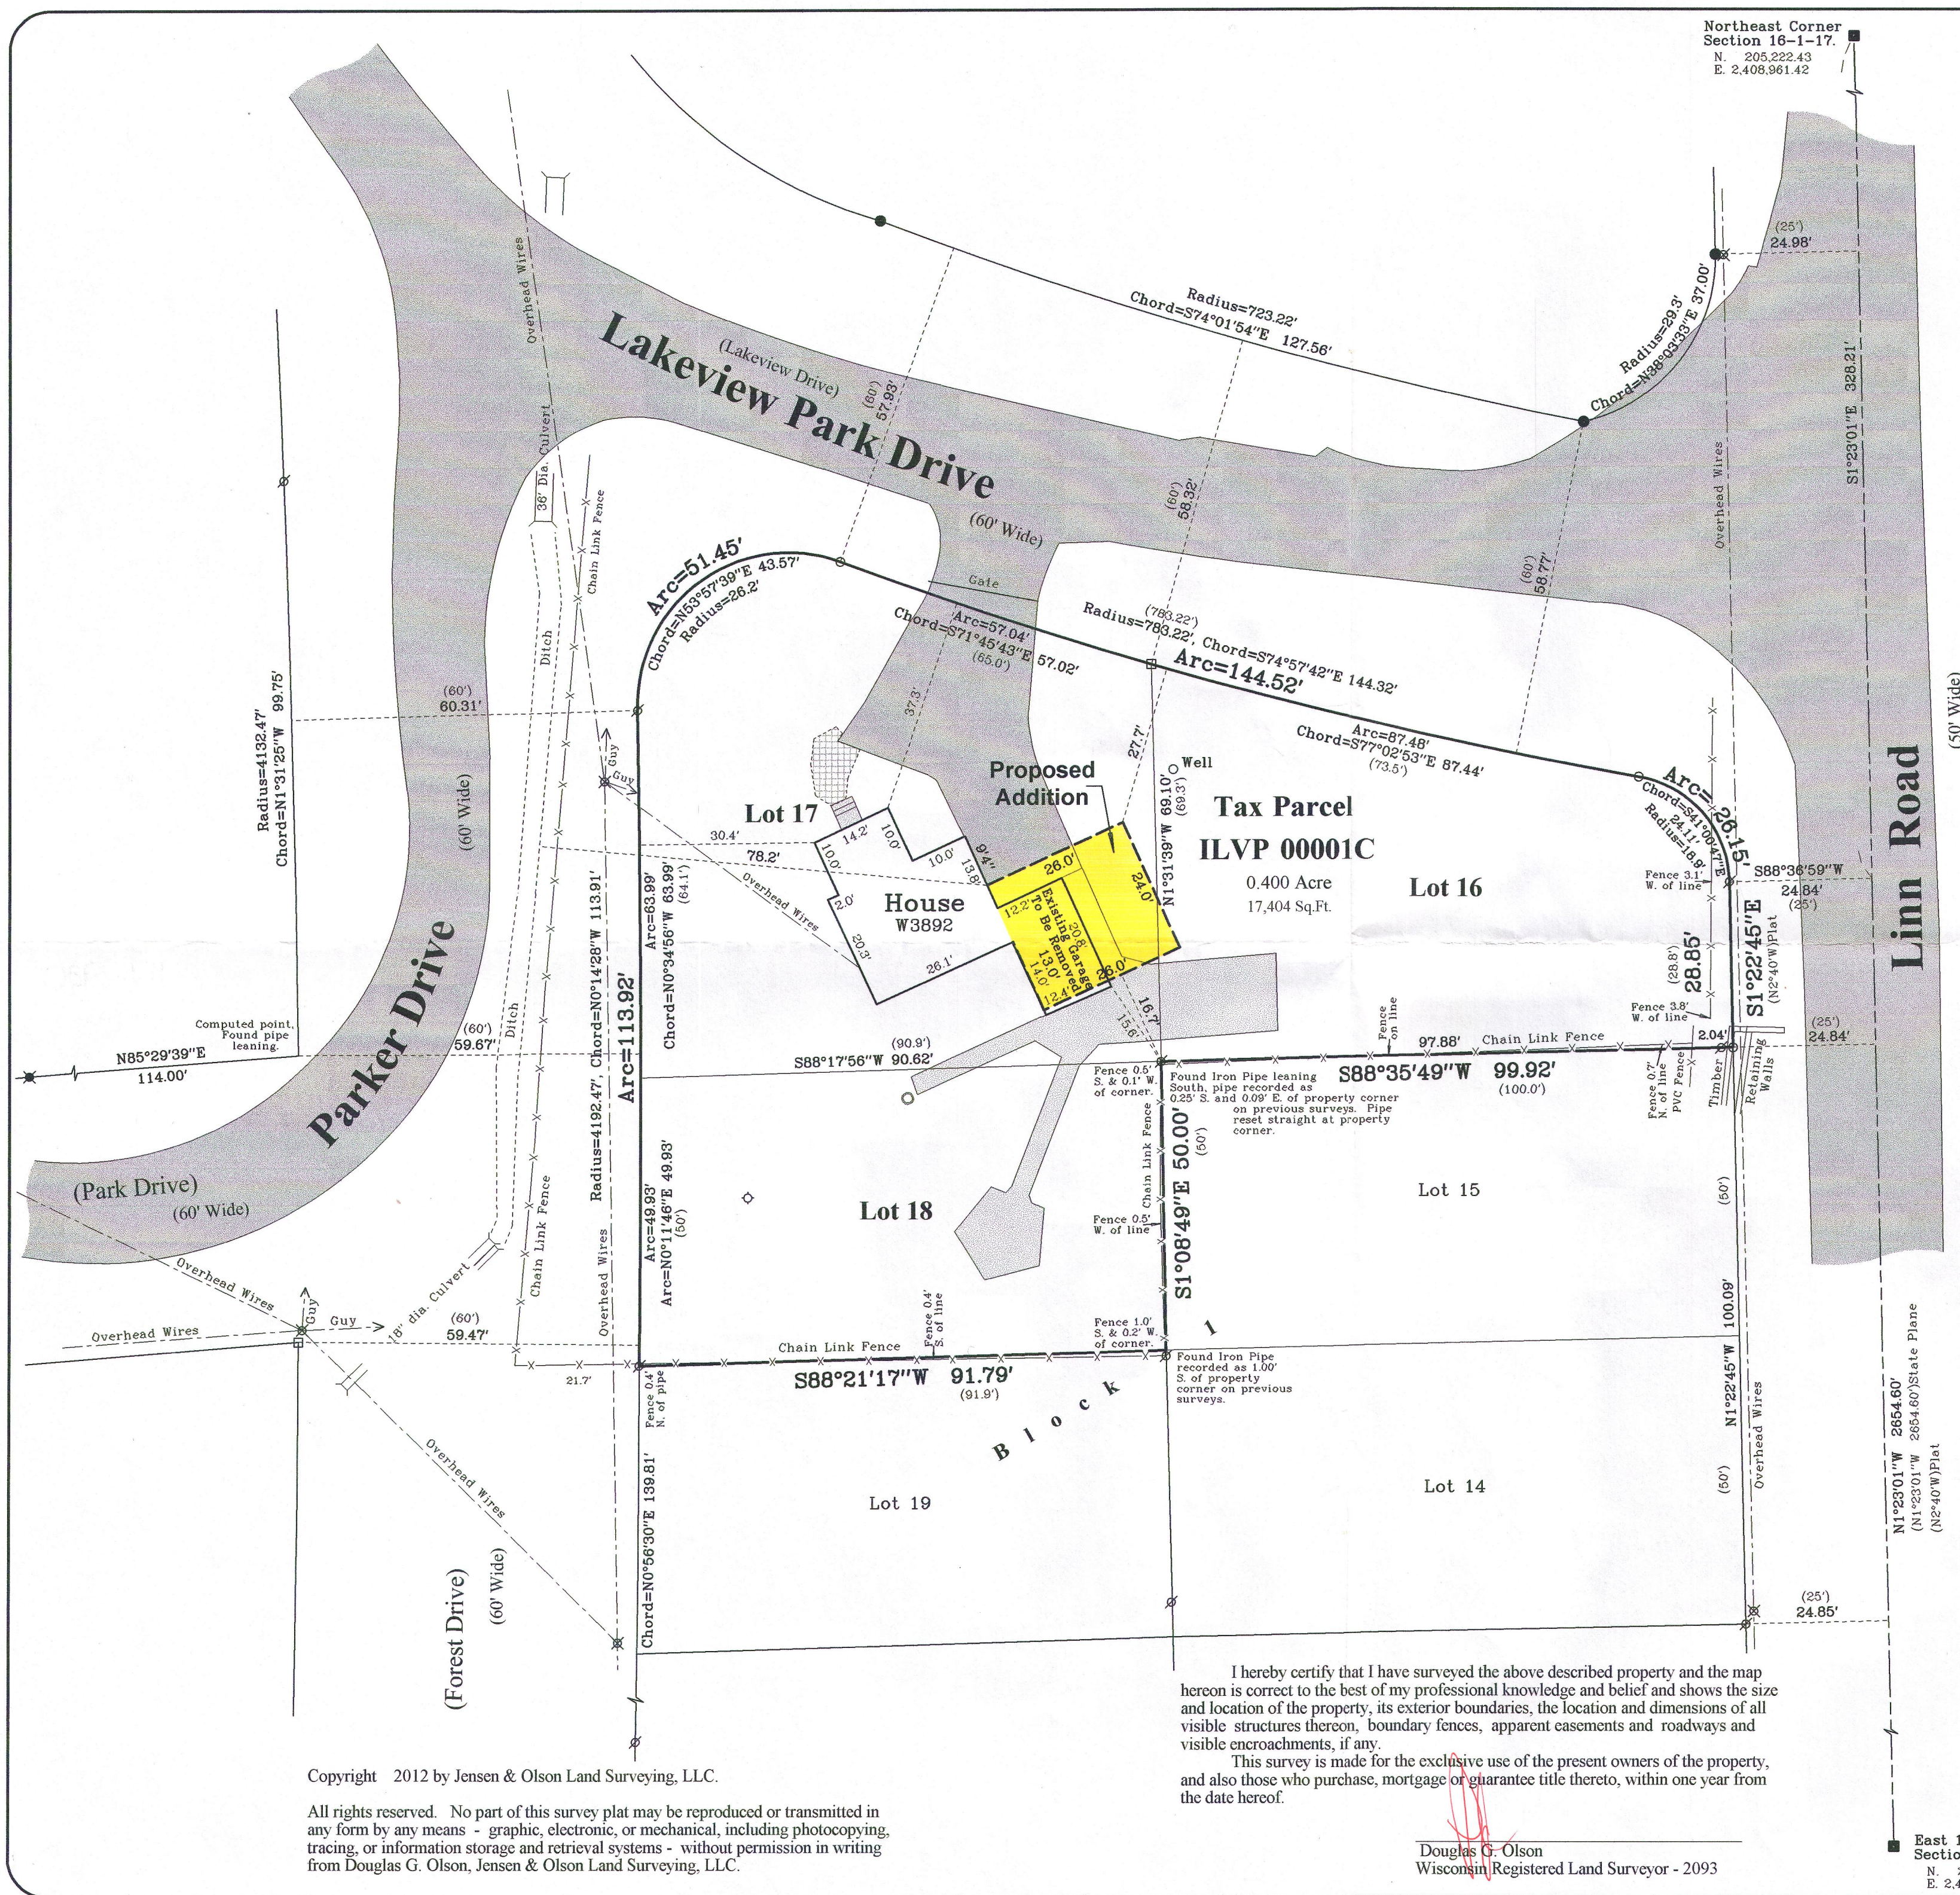



Plat of Survey

of
**Lots 16, 17 & 18 in Block 1
of Lakeview Park,**
a subdivision located in the Northeast 1/4 of Section 16,
Town 1 North, Range 17 East, Town of Linn,
Walworth County, Wisconsin.

Surveyed for: **Home Design Mfg.**
P.O. Box 527
Fontana, Wisconsin. 53125

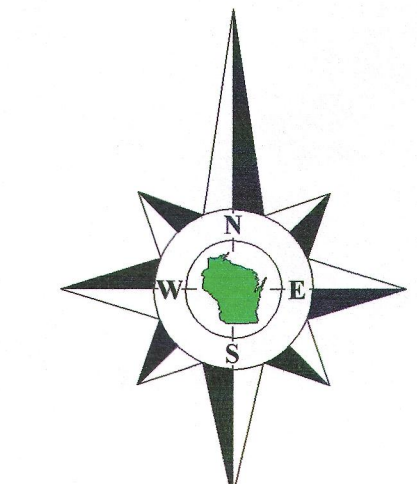

Bearings reference to the Wisconsin State
Plane Coordinate System, South Zone.

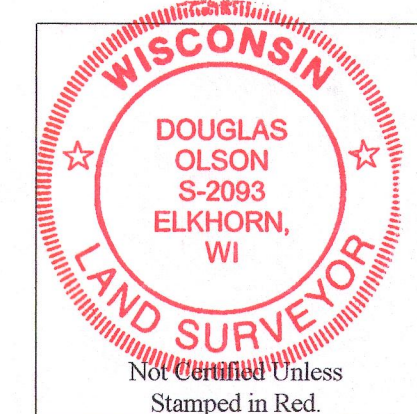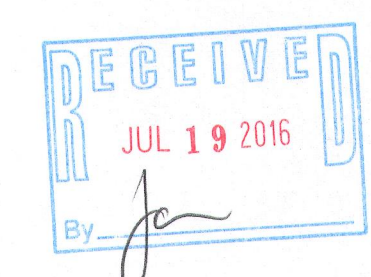

- Notes:**
- 1) This survey plat is not certified unless signed and sealed in red ink.
 - 2) This survey is subject to Wisconsin lien laws. This Plat of Survey is the notice of intent to file lien. Lien waiver required.

Copyright 2012 by Jensen & Olson Land Surveying, LLC.
All rights reserved. No part of this survey plat may be reproduced or transmitted in any form by any means - graphic, electronic, or mechanical, including photocopying, tracing, or information storage and retrieval systems - without permission in writing from Douglas G. Olson, Jensen & Olson Land Surveying, LLC.

Douglas G. Olson
Wisconsin Registered Land Surveyor - 2093

East 1/4 Corner
Section 16-1-17.
N. 202.568.61
E. 2,409,025.52

Survey Date: September 21, 2012. Revisions: No. 1 - Proposed House Addition No. 2 - Revised Proposed House Addition	
Scale in Feet 1" = 20' 0' 10' 20' 40'	
Jensen & Olson Land Surveying, LLC 45 South Wisconsin Street * P.O. Box 322 * Elkhorn, Wisconsin. 53121 Telephone: (262) 723-3434 * Facsimile: (262) 723-8044 Email: jensen.olson@elknet.net	
Sheet 1 of 1 Sheets Drawing Name: Linn 17-2012105-201205Plat.dwg	Job Reference Number 2015.102
2015.102	

ILVP-1C 117-3920