PLAT OF SURVEY


ASSIGNED THE WESTERLY LINE OF LOT 6
N 18°12'00" W

Lot 6 and part of Lot 7, Block 1, Forest Rest, according to the recorded plat thereof and described as follows, to-wit: Beginning at the Southwest corner of said Lot 7; thence North 22° 16' West 154.68 feet; thence South 36°46' East 100.96 feet; thence South 0° 52' East 59.87 feet to the place of beginning. EXCEPTING therefrom the following described parcel: Beginning at the Northeast corner of said Lot 6; thence South 22° 16' East 107.21 feet; thence North 67°16' West 28.28 feet; thence North 22° 16' West 79.26 feet; thence North 45° 24' East 21.47 feet to the place of beginning. Said land being in the Town of Linn, County of Walworth and State of Wisconsin.

FOR INFORMATIONAL PURPOSES ONLY:

Property Address: N2481 Forest Rest Ln, Lake Geneva, WI 53147

Tax Key Number: IFR 00006

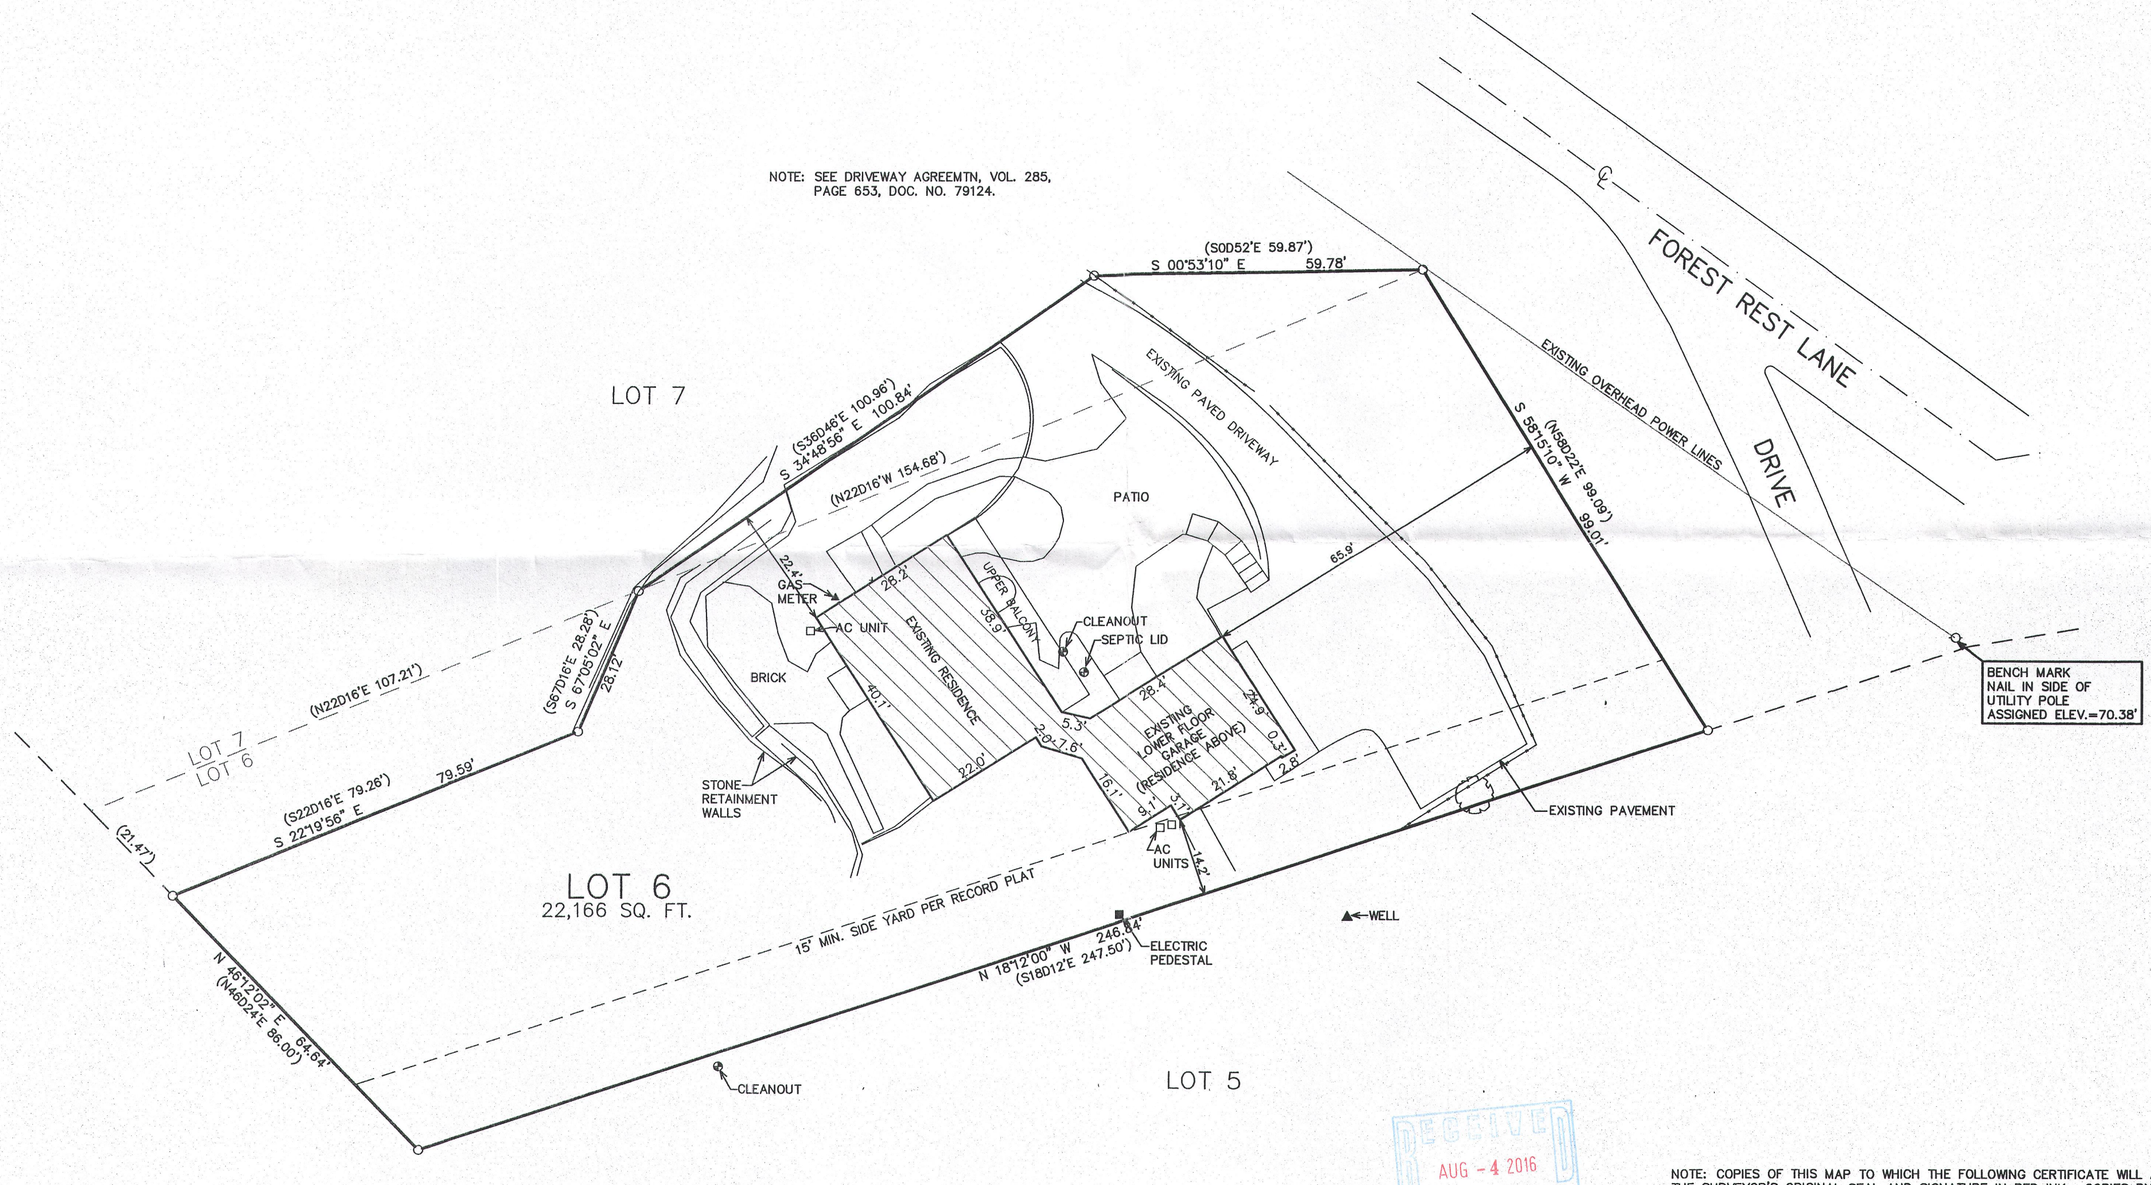

10 5 0 10 20 30 40 50 60 70 80 90 100
MAP SCALE IN FEET ORIGINAL 1" = 20'

RECEIVED
AUG - 4 2016
By SMF

WISCONSIN
PETER S. GORDON
S-2101
ELKHORN, WI
LAND SURVEYOR

NOTE: COPIES OF THIS MAP TO WHICH THE FOLLOWING CERTIFICATE WILL APPLY SHOW THE SURVEYOR'S ORIGINAL SEAL AND SIGNATURE IN RED INK. COPIES BY ANY OTHER MEANS MAY HAVE ALTERATIONS WHICH DO NOT REPRESENT THE SURVEYOR'S WORK PRODUCT.

I HEREBY CERTIFY THAT THE ABOVE DESCRIBED PROPERTY HAS BEEN SURVEYED UNDER MY DIRECTION AND THAT THE ABOVE MAP IS A TRUE REPRESENTATION THEREOF AND SHOWS THE SIZE AND LOCATION OF THE PROPERTY, ITS EXTERIOR BOUNDARIES, THE LOCATION OF ALL VISIBLE STRUCTURES, AND DIMENSIONS OF ALL PRINCIPLE BUILDINGS THEREON, BOUNDARY FENCES, APPARENT EASEMENTS, ROADWAYS, AND VISIBLE ENCROACHMENTS, IF ANY. THIS SURVEY IS MADE FOR THE USE OF THE PRESENT OWNERS OF THE PROPERTY, AND ALSO THOSE WHO PURCHASE, MORTGAGE, OR GUARANTEE THE TITLE THERETO WITHIN ONE YEAR FROM THE DATE HEREOF.

DATED: 7/31/2009

REVISED 6/17/2014 TO SHOW EXISTING IMPROVEMENTS

RECERTIFIED MAY 16, 2016

PETER S. GORDON

– WORK ORDERED BY –
DONNA BRONGIEL
C/O DESIGNS BY MAIDA
5050 NEWPORT, SUITE 6
ROLLING MEADOWS, IL 60008

FARRIS, HANSEN & ASSOCIATES, INC.
ENGINEERING – ARCHITECTURE – SURVEYING
7 RIDGWAY COURT P.O. BOX 437
ELKHORN, WISCONSIN 53121
OFFICE: (262) 723-2098 FAX: (262) 723-5886

REVISIONS

PROJECT NO.
7956.09

DATE:
10/26/2011

SHEET NO.
1 OF 1

MAY 16 2016

5/16/2016 X:\Projects\7956\Dcad\SURVEY

IFR-6

117-3929