
FARRIS, HANSEN & ASSOCIATES, INC.

ENGINEERING – ARCHITECTURE – SURVEYING
7 RIDGWAY COURT – P.O. BOX 437 – ELKHORN, WISCONSIN 53121
PHONE: (262) 723–2098 FAX: (262) 723–5886

PLAT OF SURVEY

THE SOUTH 30' OF LOT 92, AND LOTS 93, 94, & 95
LAKE GENEVA HIGHLANDS
LOCATED IN THE SE 1/4 SEC. 8, TOWN 1 NORTH, RANGE 17 EAST
WALWORTH COUNTY, WISCONSIN

– WORK ORDERED BY –
CLAIR LAW OFFICES
617 EAST WALWORTH AVE
DELAVAN, WI. 53115

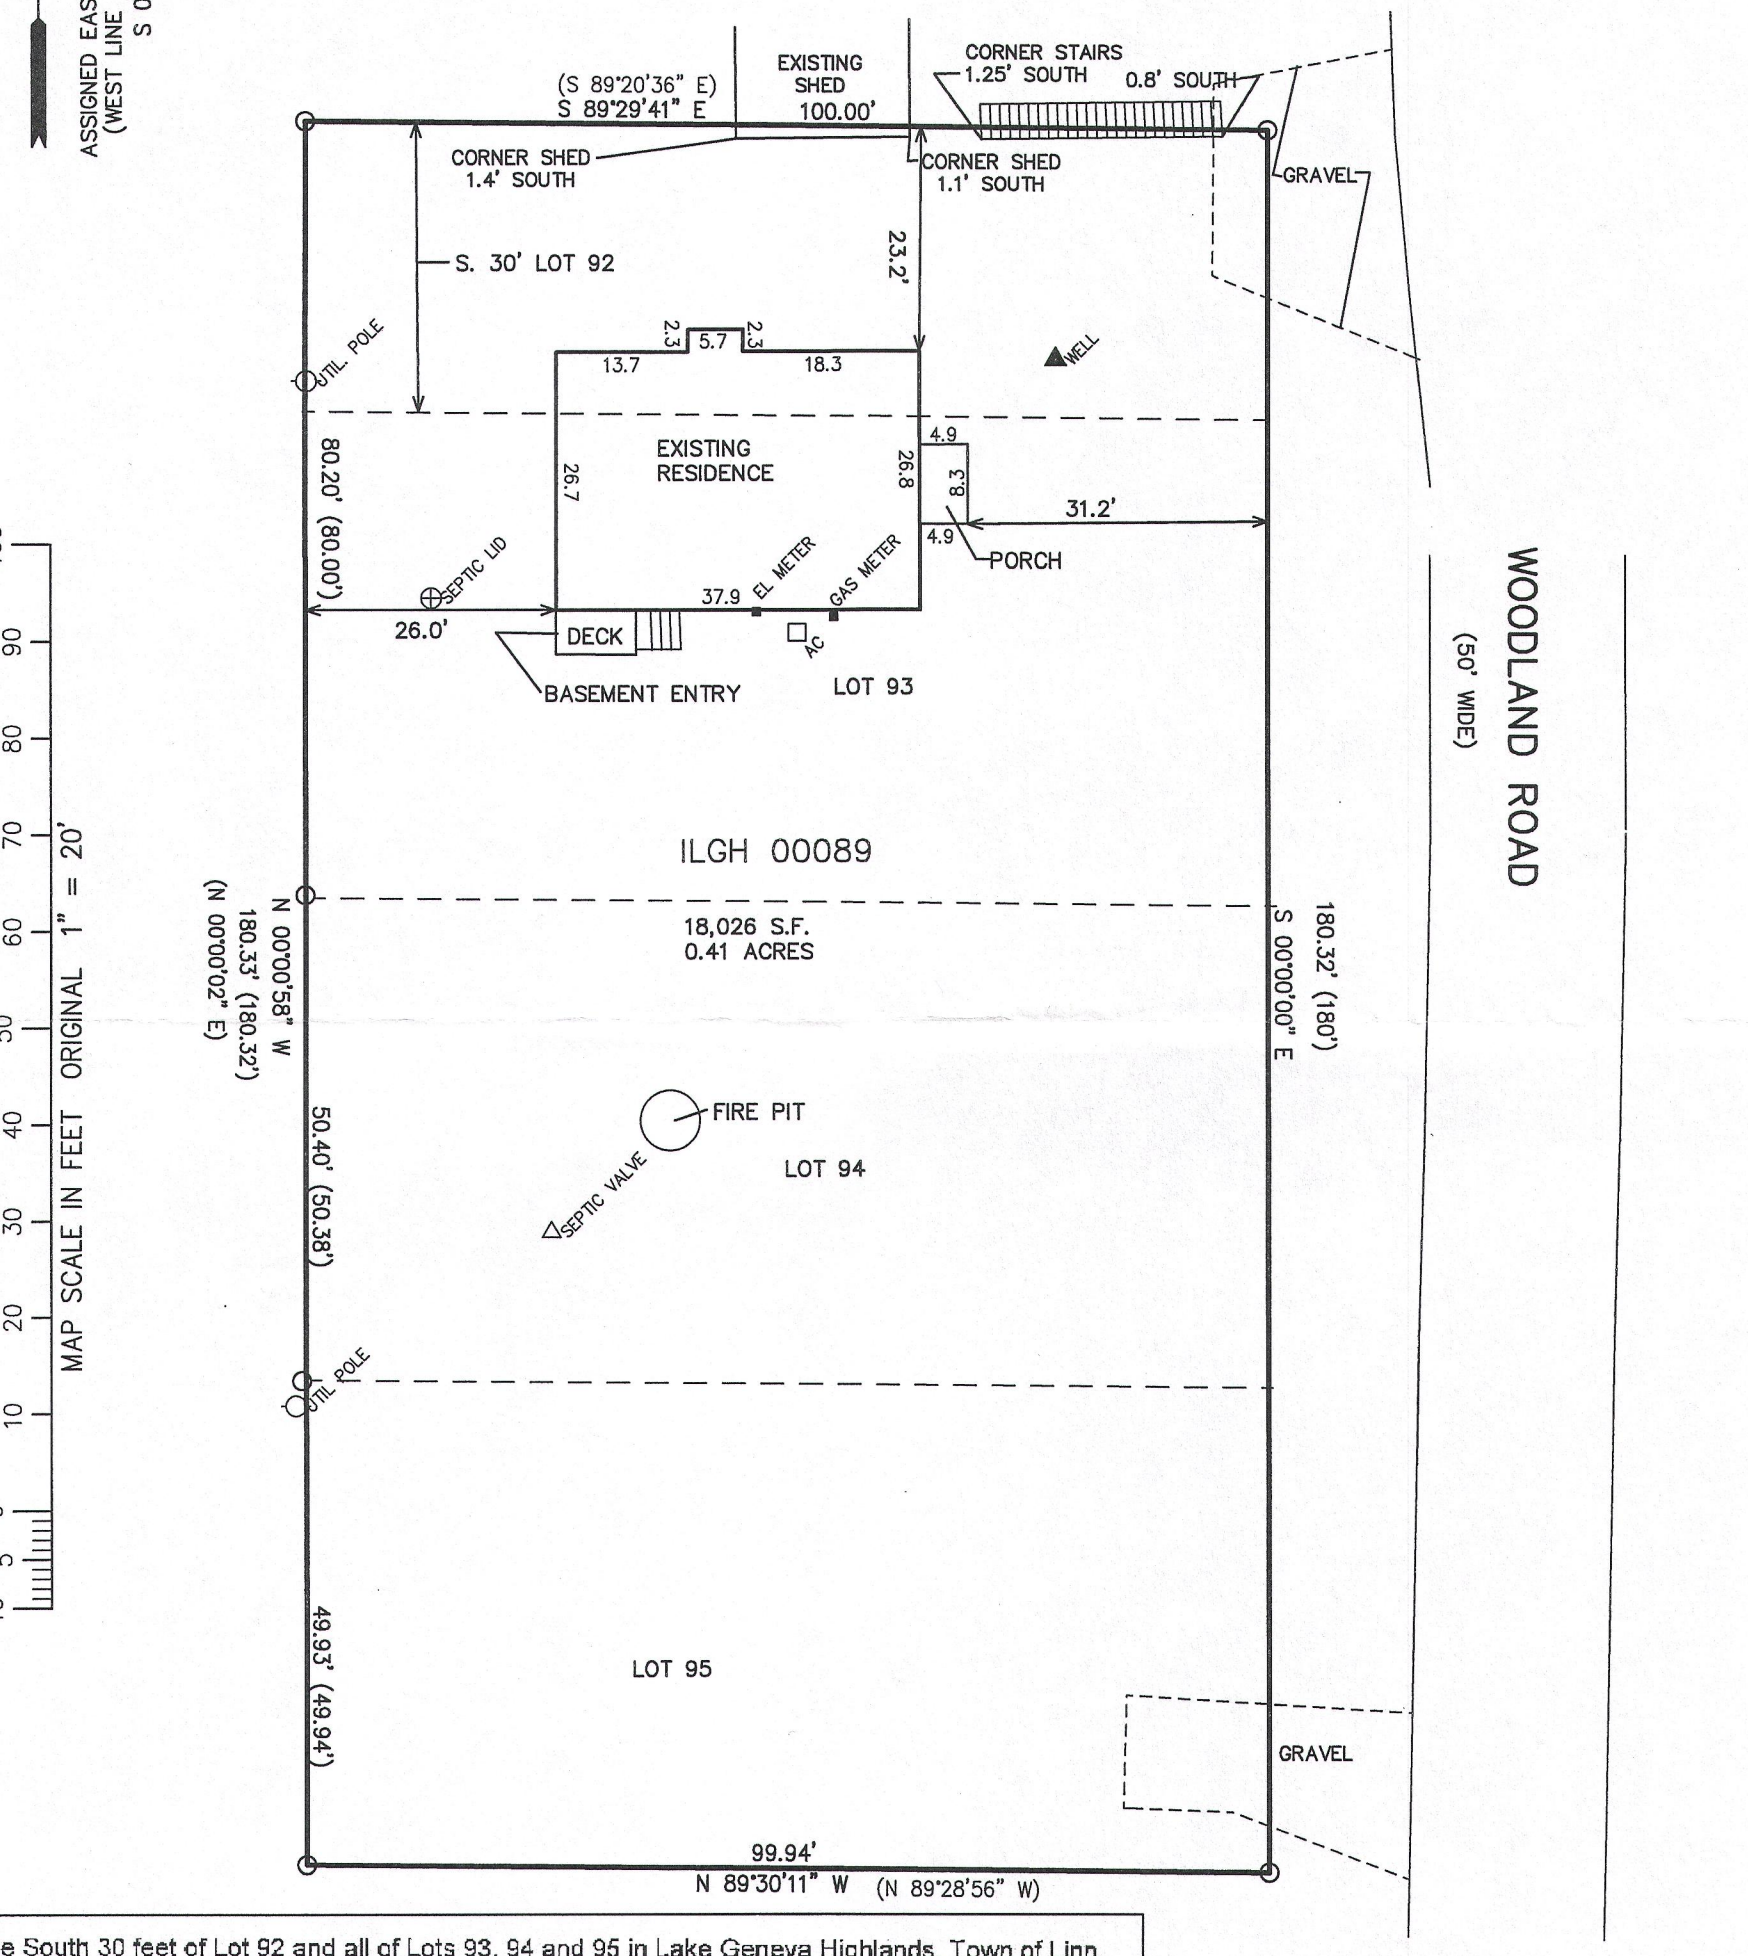

The South 30 feet of Lot 92 and all of Lots 93, 94 and 95 in Lake Geneva Highlands, Town of Linn, Walworth County, Wisconsin.

Tax Key No. ILGH 00089

LEGEND
O = FOUND IRON PIPE STAKE
(XXX) = RECORDED AS

NOTE: COPIES OF THIS MAP TO WHICH THE FOLLOWING CERTIFICATE WILL APPLY SHOW THE SURVEYOR'S ORIGINAL SEAL AND SIGNATURE IN RED INK. COPIES BY ANY OTHER MEANS MAY HAVE ALTERATIONS WHICH DO NOT REPRESENT THE SURVEYOR'S WORK PRODUCT.

I HEREBY CERTIFY THAT THE ABOVE DESCRIBED PROPERTY HAS BEEN SURVEYED UNDER MY DIRECTION AND THAT THE ABOVE MAP IS A TRUE REPRESENTATION THEREOF AND SHOWS THE SIZE AND LOCATION OF THE PROPERTY, ITS EXTERIOR BOUNDARIES, THE LOCATION OF ALL VISIBLE STRUCTURES, AND DIMENSIONS OF ALL PRINCIPLE BUILDINGS THEREON, BOUNDARY FENCES, APPARENT EASEMENTS, ROADWAYS, AND VISIBLE ENCROACHMENTS, IF ANY. THIS SURVEY IS MADE FOR THE USE OF THE PRESENT OWNERS OF THE PROPERTY, AND ALSO THOSE WHO PURCHASE, MORTGAGE, OR GUARANTEE THE TITLE THERETO WITHIN ONE YEAR FROM THE DATE HEREOF.

DATED: MAY 16, 2016

PETER S. GORDON P.L.S. 2101

WISCONSIN
PETER S. GORDON
S-2101
ELKHORN, WI
LAND SURVEYOR

RECEIVED
AUG – 4 2016
By SMF

PROJECT: 9515
DATE: 05–16–2016
SHEET 1 OF 1

5/16/2016 X:\Projects\3836\BLOCK_03\Lot_6\A