

45-17

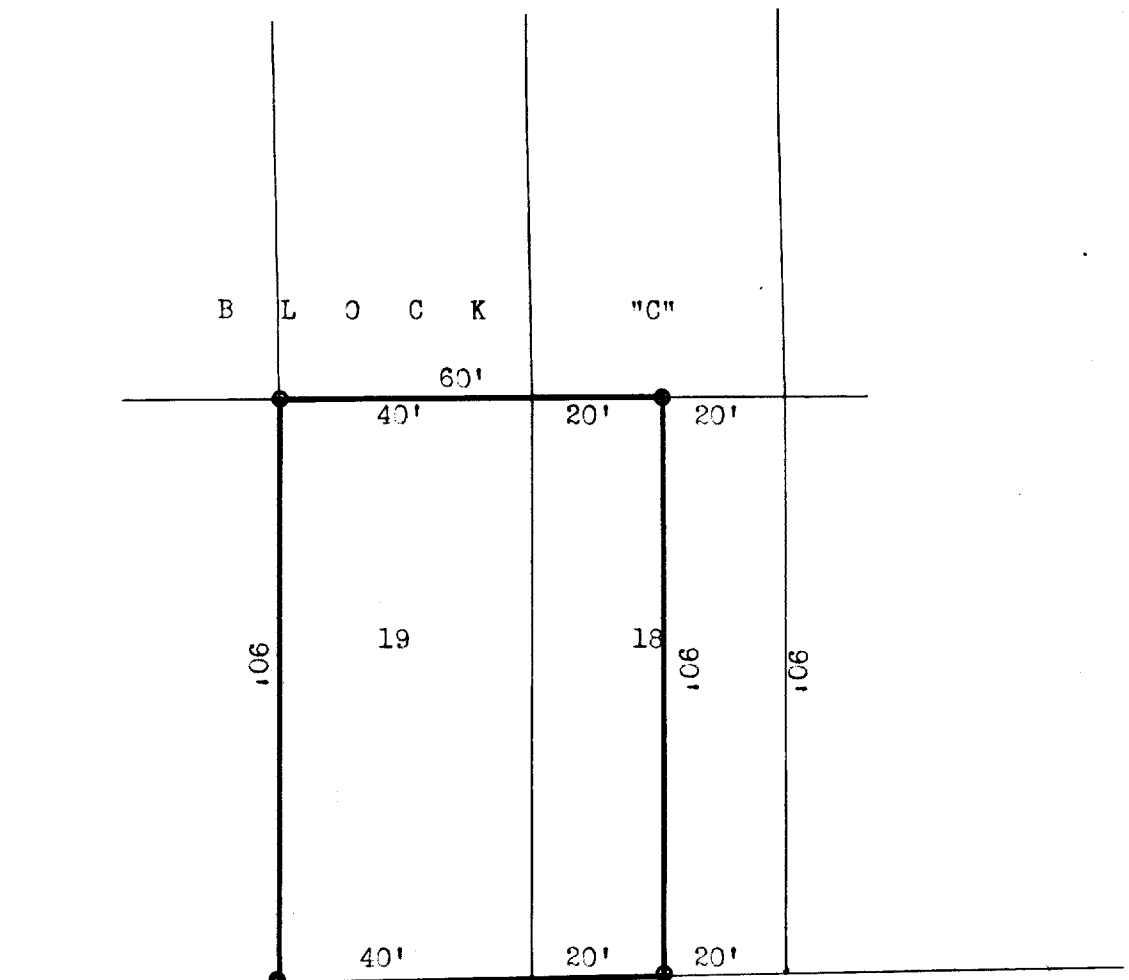


COMO AVENUE.

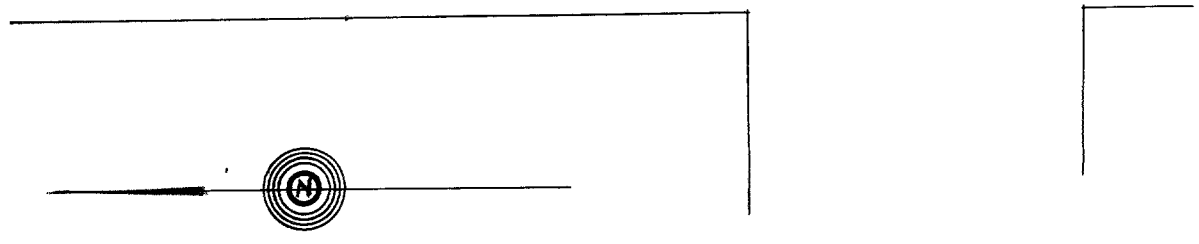

DESCRIPTION: Lot 19 and Lot 18 except the south 20 feet thereof of Cisco Beach Subdivision a subdivision of a portion of the N.E.$\frac{1}{4}$ of Section 5, Township 1 north, Range 17 east of the 4th P. M.

CERTIFICATE: I, hereby certify that I have on this the 21st day of June 1945, surveyed the above described property according to the official records on file in the office of the Recorder of Deeds in and for Walworth County, Wisconsin, and find that no encroachments exist and that the plat here portrayed is an exact reproductionsof the conditions found at the site on this day.

SIGNED AND SEALED THIS 21stDAY OF JUNE 1945.

Joseph M. Biagi.

Joseph M. Biagi. Professional Engineer.
Elkhorn Wisconsin.

ICT 42

11-33