
**LAND-MARK SURVEYING**
Mark L. Miritz
Wisconsin Professional Land Surveyor S-2582

N9330 Knuteson Drive
Whitewater, WI 53190
Phone:(262)495-3284
MARKMIRITZ@
LAND-MARKSURVEYING.COM

**ORDERED BY:**
**MICHAEL & PEGGY BENTLEY**
**KEEFE REAL ESTATE**
**751 GENEVA PARKWAY**
**LAKE GENEVA, WI 53147**

# PLAT OF SURVEY

**LOTS 1-4, BLOCK 6, MAPLE HILLS "A" SUBDIVISION, LOCATED IN SECTION 18, TOWN 1 NORTH, RANGE 17 EAST, LINN TOWNSHIP, WALWORTH COUNTY, WISCONSIN.**

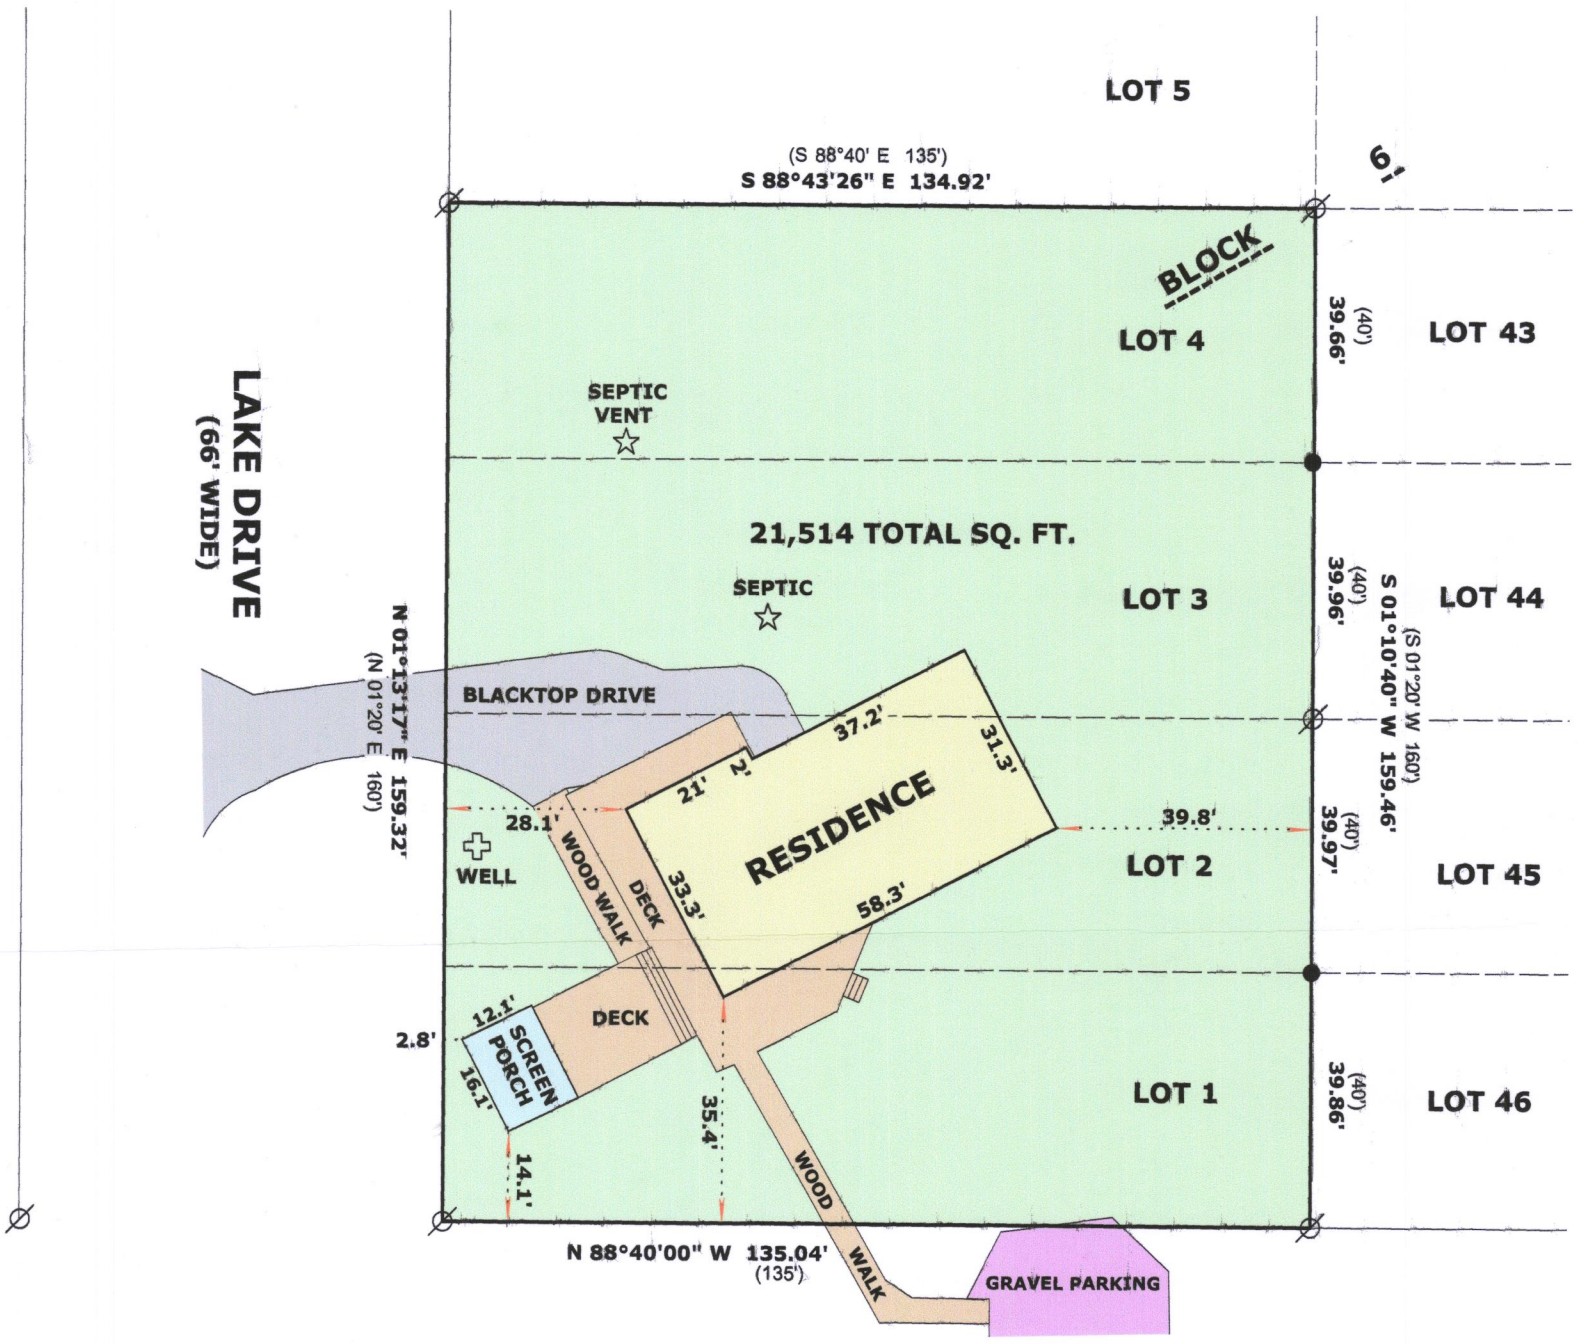


SOUTH LINE LOT 1
ASSUMED N 88°40'00" W
AS PLATTED

## LEGEND

| | |
|---|---|
| ⌀ | FOUND IRON PIPE 1 1/4" |
| ● | FOUND SQUARE IRON ROD 1/2" |
| ( x x ) | RECORDED AS DIMENSION |

WISCONSIN
MARK L. MIRITZ
S-2582
WHITEWATER, WI
LAND SURVEYOR

RECEIVED
OCT 26 2017
By Jan

**SCALE: 1 INCH = 30 FEET**

"I hereby certify that the above described property has been surveyed by me or under my direction and that the above map is a true representation thereof and shows the size and location of the property, its exterior boundaries, the location of all visible structures and dimensions of all principal buildings thereon, boundary fences, apparent easements, roadways and visible encroachments, if any."
"This survey is made for the use of the present owners of the property, and also those who purchase, mortgage, or guarantee the title thereto within one year from date hereof."

Mark L. Miritz

**MARK L. MIRITZ**
**WISCONSIN PROFESSIONAL LAND SURVEYOR S-2582**

**DATE:** SEPT. 27, 2017 **JOB NO.** 17.915

IMH-134 117-4071