PREPARED FOR
KEEFE REAL ESTATE


ORDERED BY
TRICIA FORBECK

PLAT OF SURVEY

- OF -

LOT 1 OF CERTIFIED SURVEY MAP NO. 3631 IN THE NORTHEAST 1/4 AND THE NORTHWEST 1/4 OF THE NORTHEAST 1/4 OF SECTION 17, TOWNSHIP 1 NORTH, RANGE 17 EAST, IN THE TOWN OF LINN, WALWORTH COUNTY, WISCONSIN.

PATHFINDER SURVEYING
(a NMB Company)
P.O BOX 322
LAKE GENEVA, WI. 53147
WWW.PATHFINDERSURVEYING.NET
262-248-8303

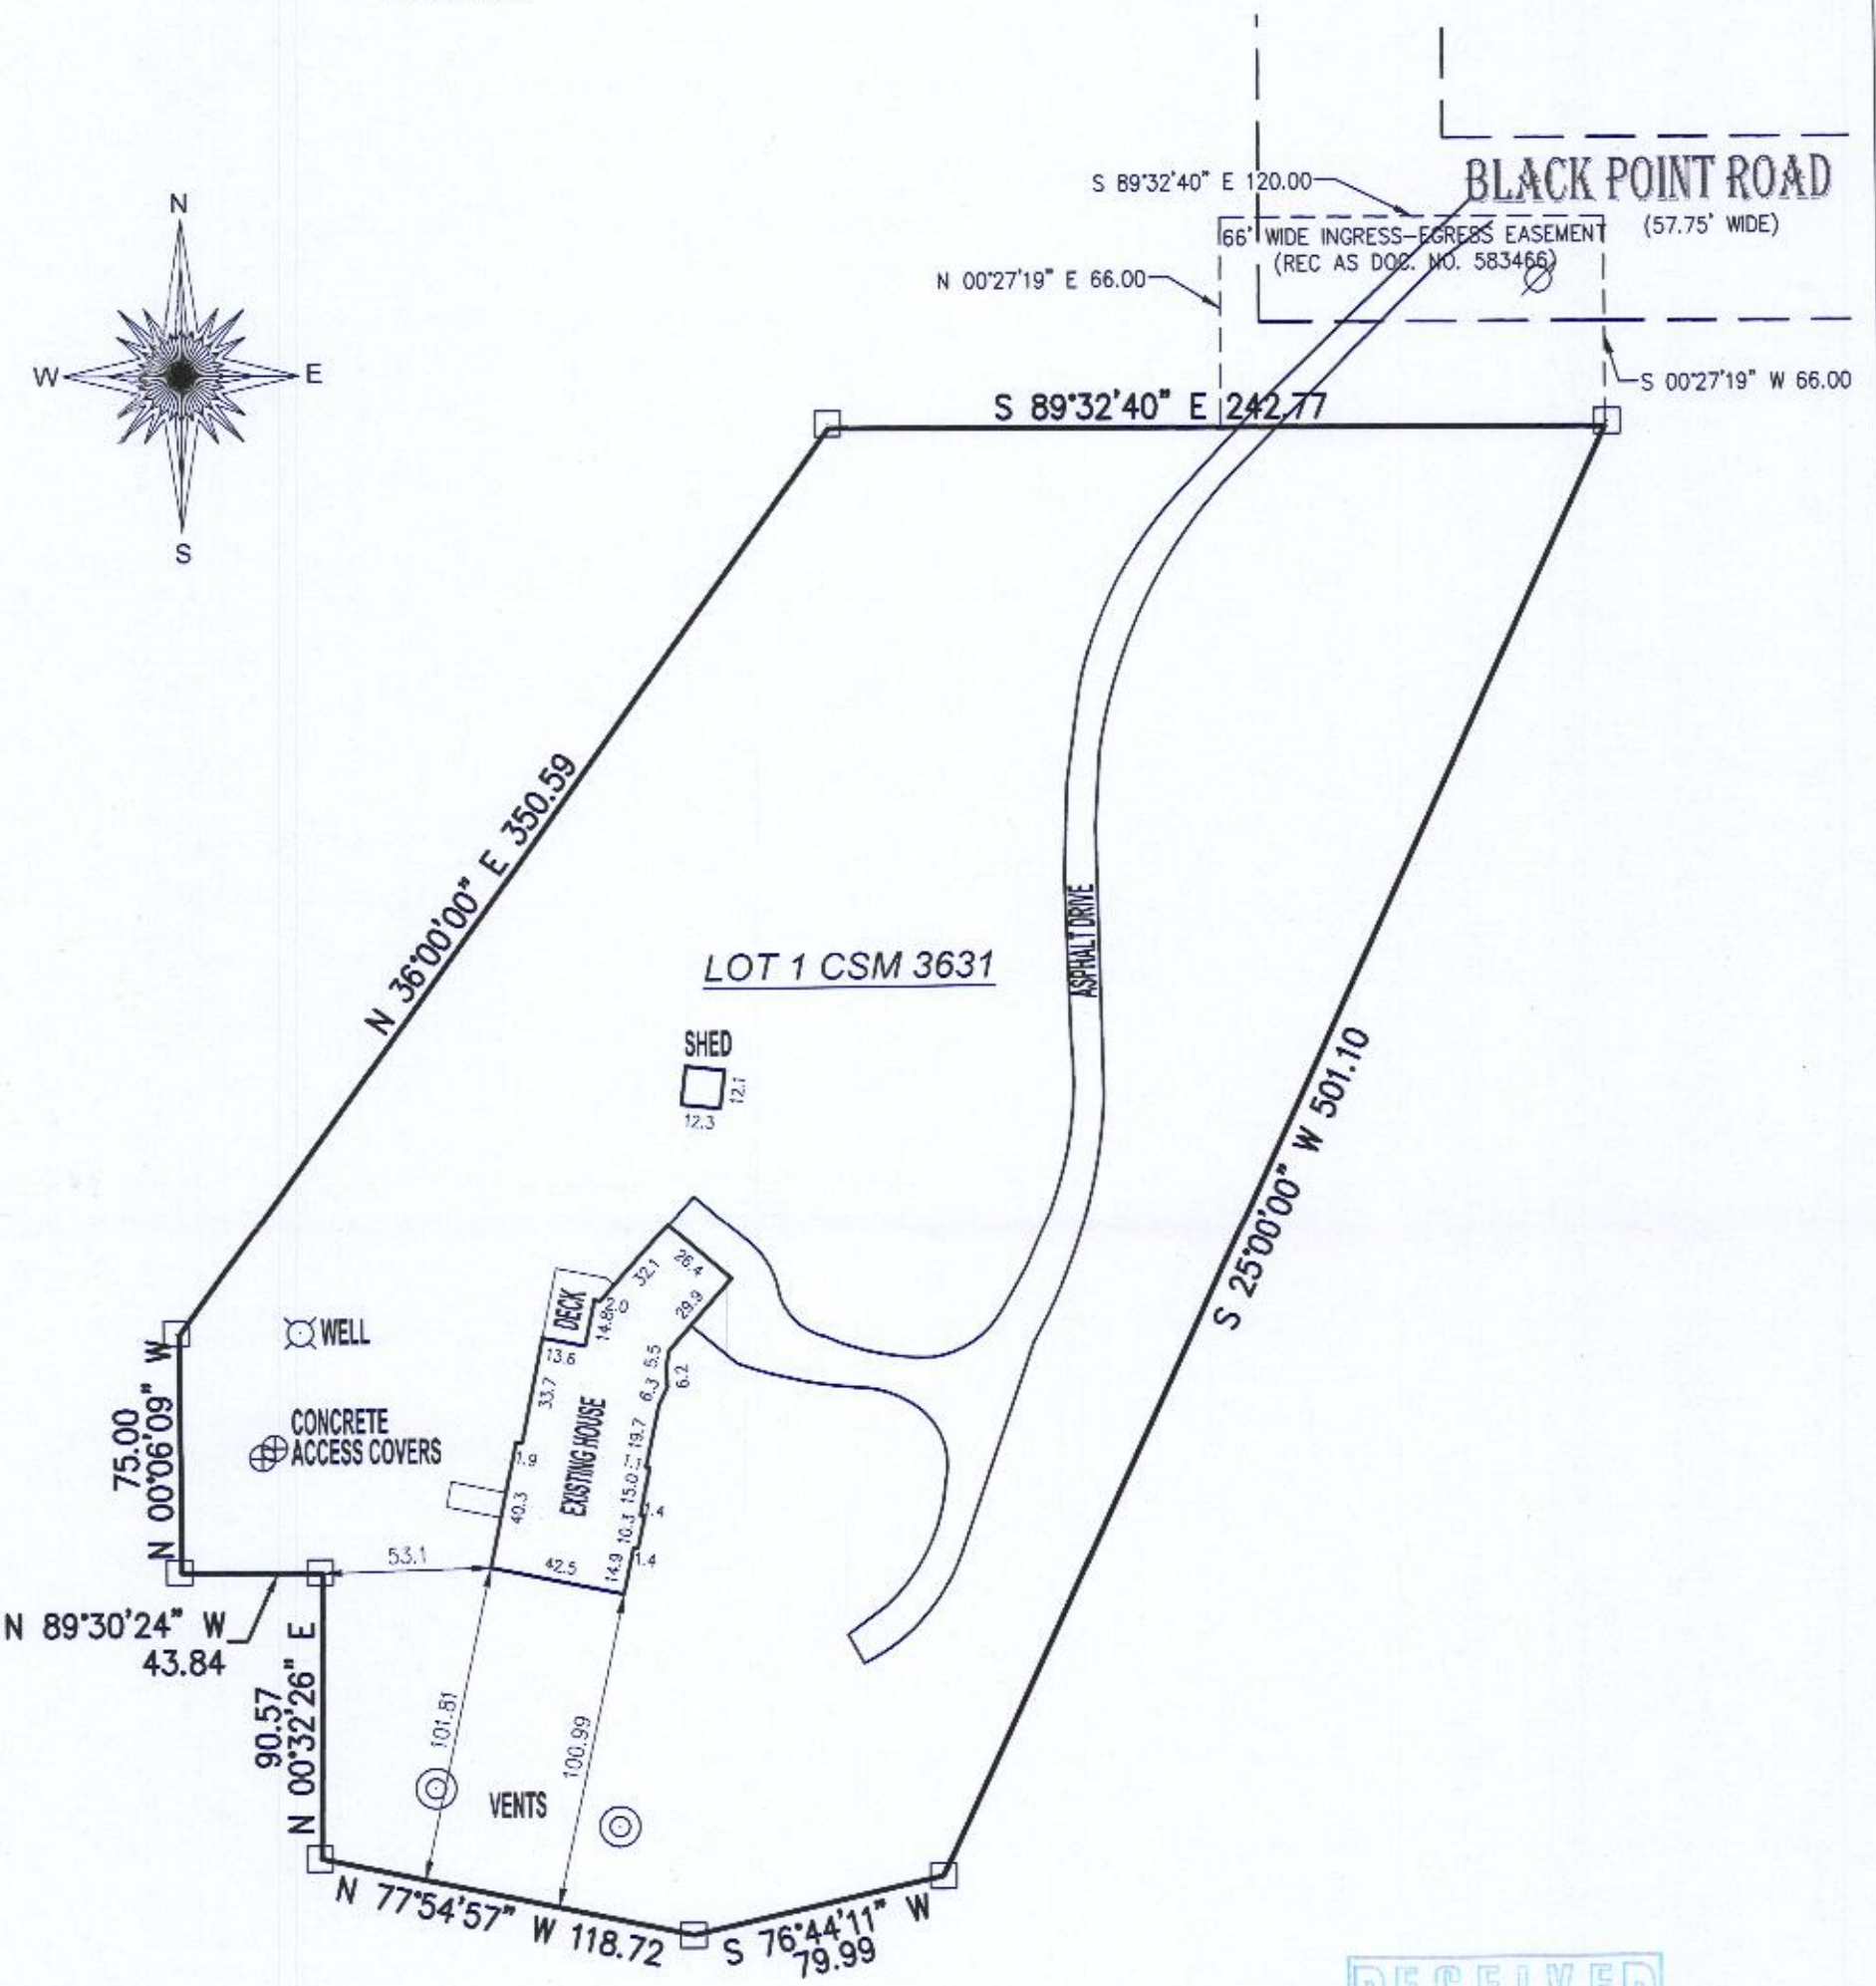

□ = found iron bar
∅ = found power pole

SCALE 1" = 60'

JOB # 2017.0217.01

TAX ID # IA363100001

BASIS OF BEARING OF THIS PLAT: THE US STATE PLANE COORDINATE SYSTEM SOUTH ZONE, NAD 83. WISCORS.

I hereby certify that I have surveyed the above- described property and the above map is a is a true representation thereof and shows the size and location of the property, its exterior boundaries, the location and dimensions of all structures thereon, fences, apparent easements and roadways and visible encroachments if any.

This survey is made for the present owners of the property, and those who purchase, mortgage, or guarantee the title thereto, within one year from the date hereof.

DATED THIS 16TH DAY OF OCTOBER, 2017.

RECEIVED
NOV 29 2017
By Jan

WISCONSIN
MARK R. MADSEN
S-2271
RACINE, WI
LAND SURVEYOR

MARK R. MADSEN S - 2271
Wisconsin Professional Land Surveyor

117-4083