
HAROLD H. KOLB

REGISTERED PROFESSIONAL LAND SURVEYOR
LAKE GENEVA, WISCONSIN

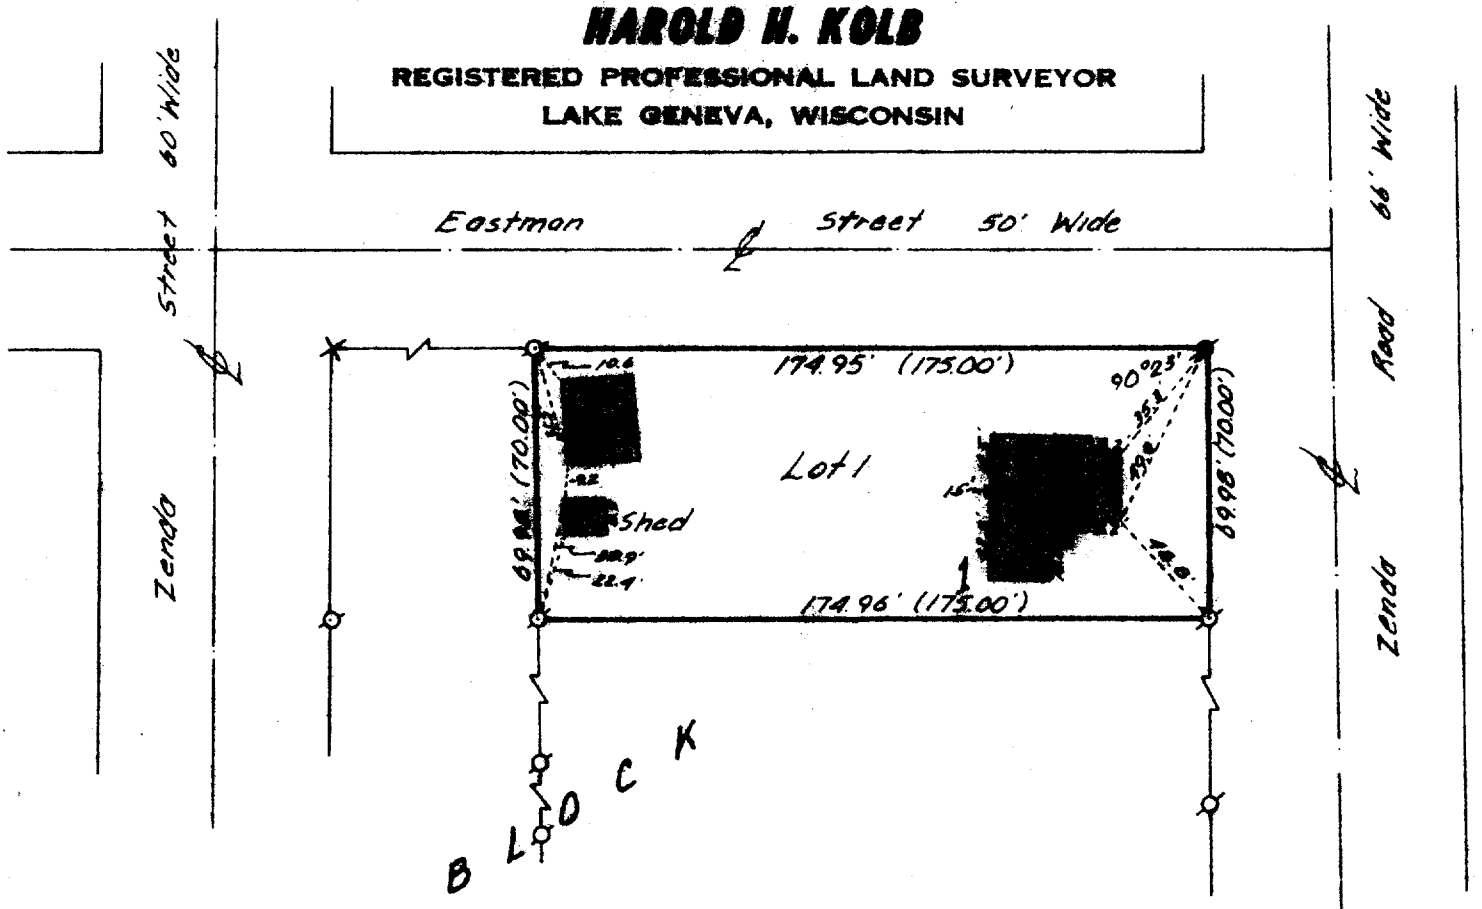

PLAT OF SURVEY OF

Lot 1, Block 1, Village of Zenda Subdivision, located in the Southeast ¼ of Section 28, T 1 N, R 17 E, Walworth County, Wisconsin.

N

Scale: 1"=50'

LEGEND

- ϕ — IRON PIPE FOUND
- O — IRON PIPE PLACED
- ● — IRON ROD FOUND
- x — SPIKE
- ( )- AS PLATTED

WISCONSIN HAROLD H. KOLB S-187 LAKE GENEVA, WIS. LAND

I, HAROLD H. KOLB, DO HEREBY CERTIFY THAT I HAVE SURVEYED THE PROPERTY HEREON DESCRIBED ACCORDING TO THE OFFICIAL RECORDS, AND THAT THE PLAT HEREON IS A CORRECT REPRESENTATION OF THE LOT LINES.

Harold H. Kolb

HAROLD H. KOLB
WISCONSIN REGISTERED LAND SURVEYOR, S-187
DATE December 4, 1973

117-411

BRUNING 40-105 10-6-71