AMBIT LAND SURVEYING
8120–312th Avenue
Wheatland, WI. 53105–8934
Licensed Professionals in
both Illinois & Wisconsin


PHONE: 262–537–4874
FAX: 262–537–4221
EMAIL: ambit@tds.net

PLAT OF SURVEY

OF

Lot 22 in LAKE GENEVA HIGHLANDS, a subdivision by Taylor and Powers of the East Third (excepting the east 100 feet thereof) of the North Half of the Southeast Full Quarter of Section 8, Township 1 North, Range 17 East of the 4th Principal Meridian, being in the Town of Linn, Walworth County, Wisconsin.

Parcel Identification Number: ILGH 00021

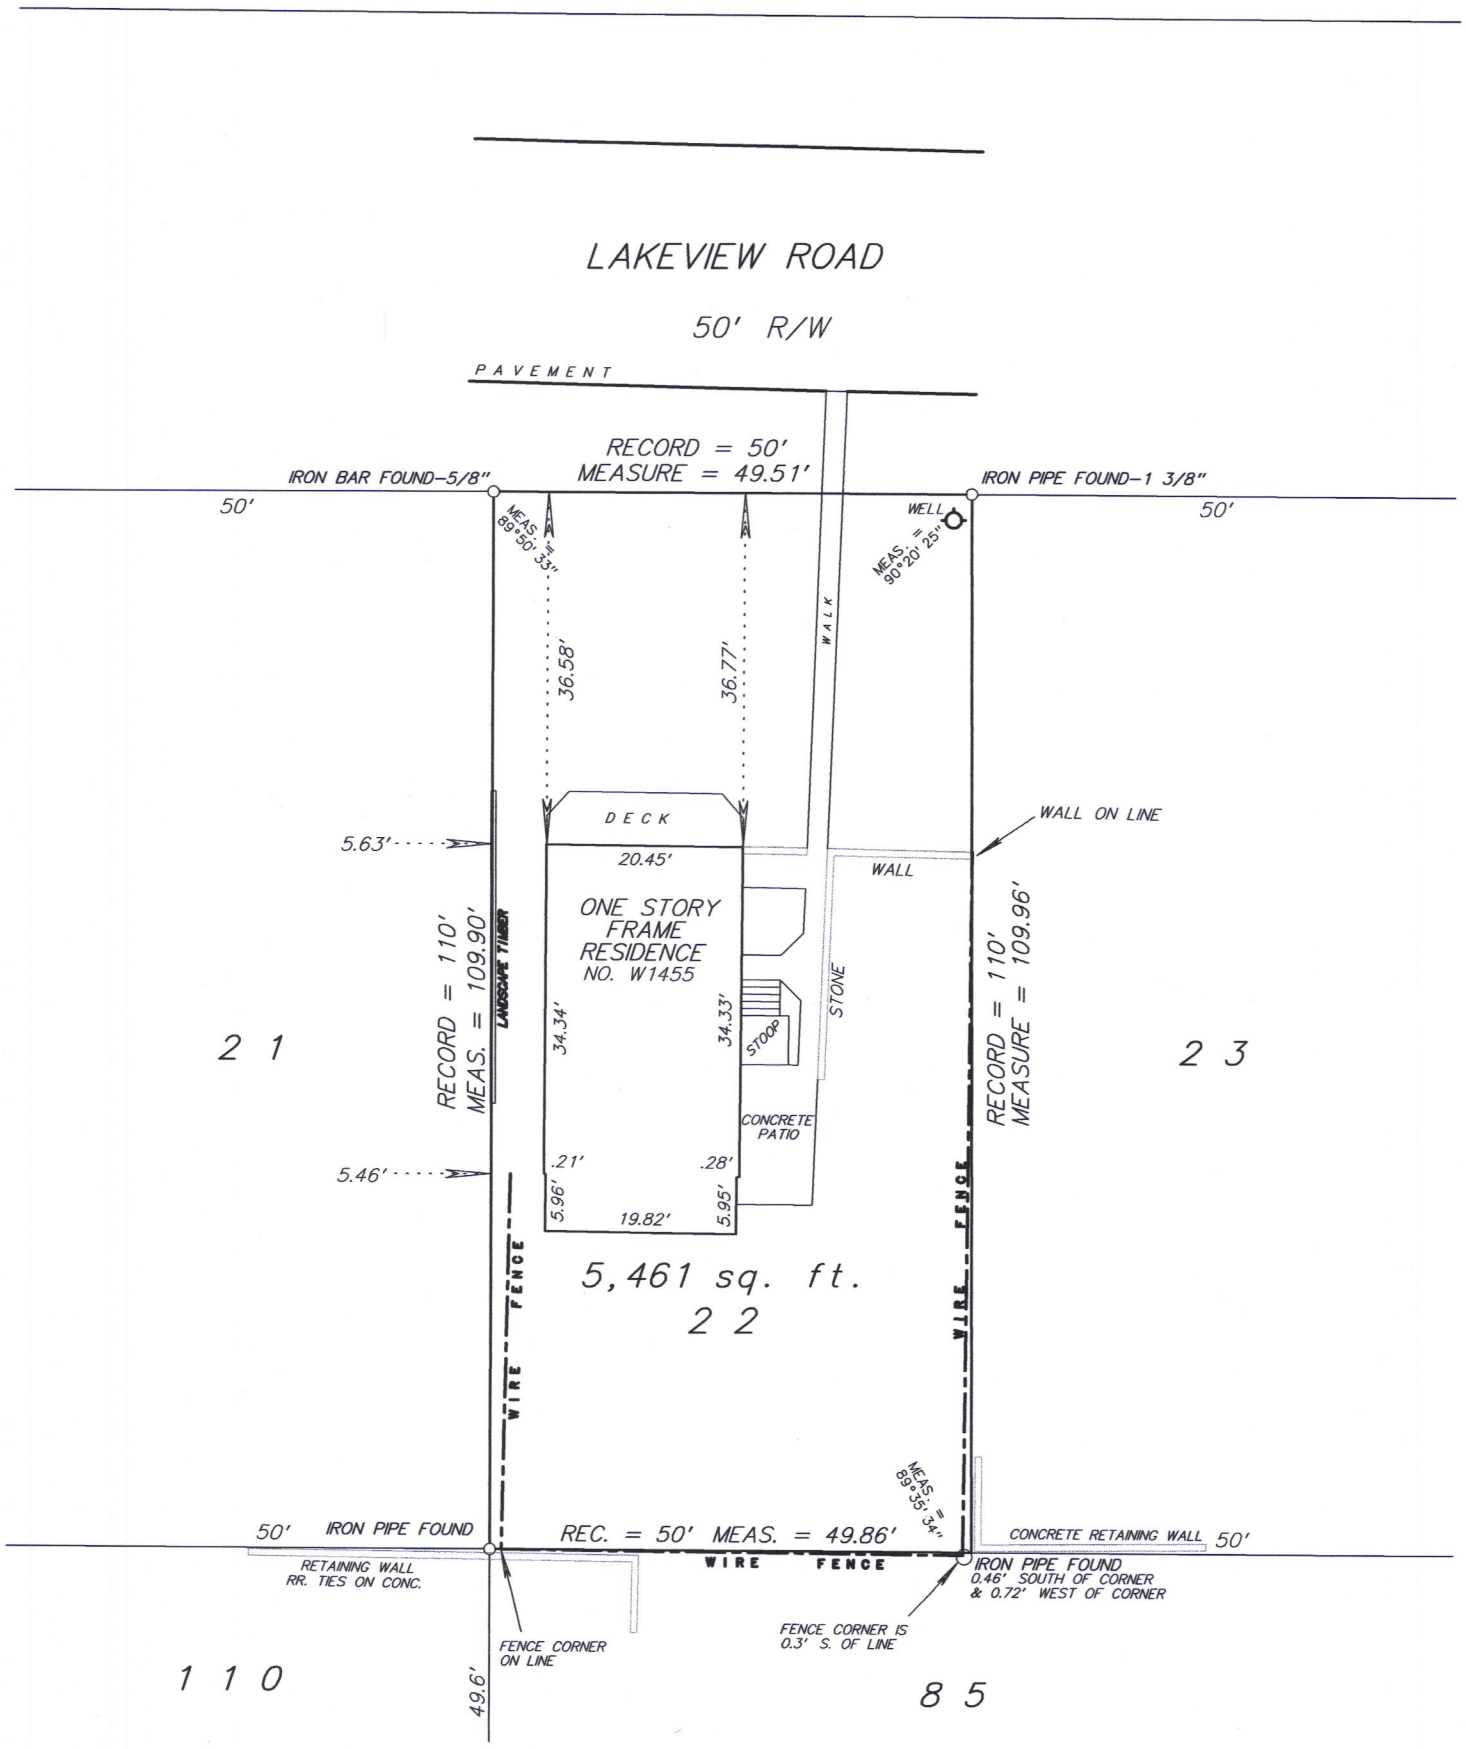

N

SCALE: 1 inch = 20 feet

ORDERED BY: M. Petrovic

JOB NO.: 17205

ILGH-21

RECEIVED
JUN 27 2018
By

Fieldwork completed on and date of certification: September 22, 2017

I hereby certify that I have surveyed the above described property and the above plat is a true representation thereof and shows the size and location of the property, its exterior boundaries, the location and dimensions of all visible structures thereon, boundary fences, apparent easements and roadways and visible encroachments, if any.

This survey is made for the exclusive use of the present owners of the property, and also those who purchase, mortgage or guarantee the title thereto within ONE YEAR from the date hereof.

Dated at Bissett, Wisconsin this _____ day of _____ 2017.

OFFICE COPY

Mark A. Bolender
Wisconsin Professional Land Surveyor – 1784

117-4144