

171083
171083S1.DWG

PLAT OF SURVEY

* REFER TO A CURRENT TITLE REPORT FOR EASEMENTS, RESTRICTIONS OR COVENANTS OF RECORD THAT MAY AFFECT THIS LAND. *

SURVEY PREPARED FOR: LAKE AREA HOMES
37945 91st STREET
TWIN LAKES, WI 53181

LOT 5

LOT 4

OUTLOT 2

OUTLOT 2

MEADOW RIDGE LANE
(66' WIDE)

EDGE OF ASPHALT
DITCH

TOP OF BANK

15' X 26' CULVERT
W/FLARED ENDS

CH = N 30°24'12" W 29.72
ARC = 29.92 R = 75.00

CH = N 39°21'18" W 57.53
ARC = 57.55 R = 666.00

N 56°56'31" E 280.04

S 09°31'26" E 193.25

S 60°33'30" W 186.19

N 41°49'49" W 79.49

28.0

30.0

32.9

29.5

16.0

90.0

90.5

92.3

40.0

54.0

49.7

79.9

22.0

10.0

25.7

26.1

24.9

34.9

4.0

PROPOSED WALK


PROPOSED DRIVE

DWELLING UNDER CONSTRUCTION (FOUNDATION)

GARAGE

PROP. PATIO

A/C PAD

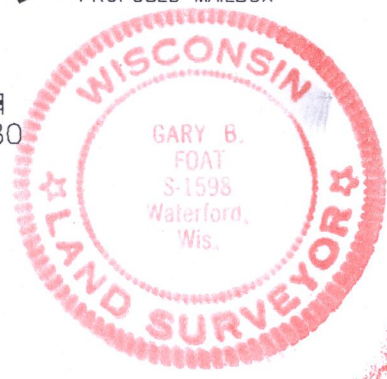

RECEIVED
JUL 10 2018
By Jan

RECERTIFIED MAY 22, 2018

IMEA-4 117-4151