PREPARED FOR
LEHMANN'S BAKERY


ORDERED BY
CHARLES
PALMER-BALL


PLAT OF SURVEY

- OF -

Lots 53 and 55 of Lake Geneva Club, located in Section 18, Township 1 North, Range 17 East of the Fourth Principal Meridian, in the Town of Linn, Walworth County, Wisconsin.

PATHFINDER SURVEYING
(a NMB Company)
P.O BOX 322
LAKE GENEVA, WI. 53147
WWW.PATHFINDERSURVEYING.NET
262-248-8303

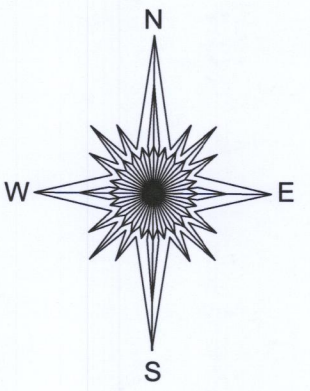


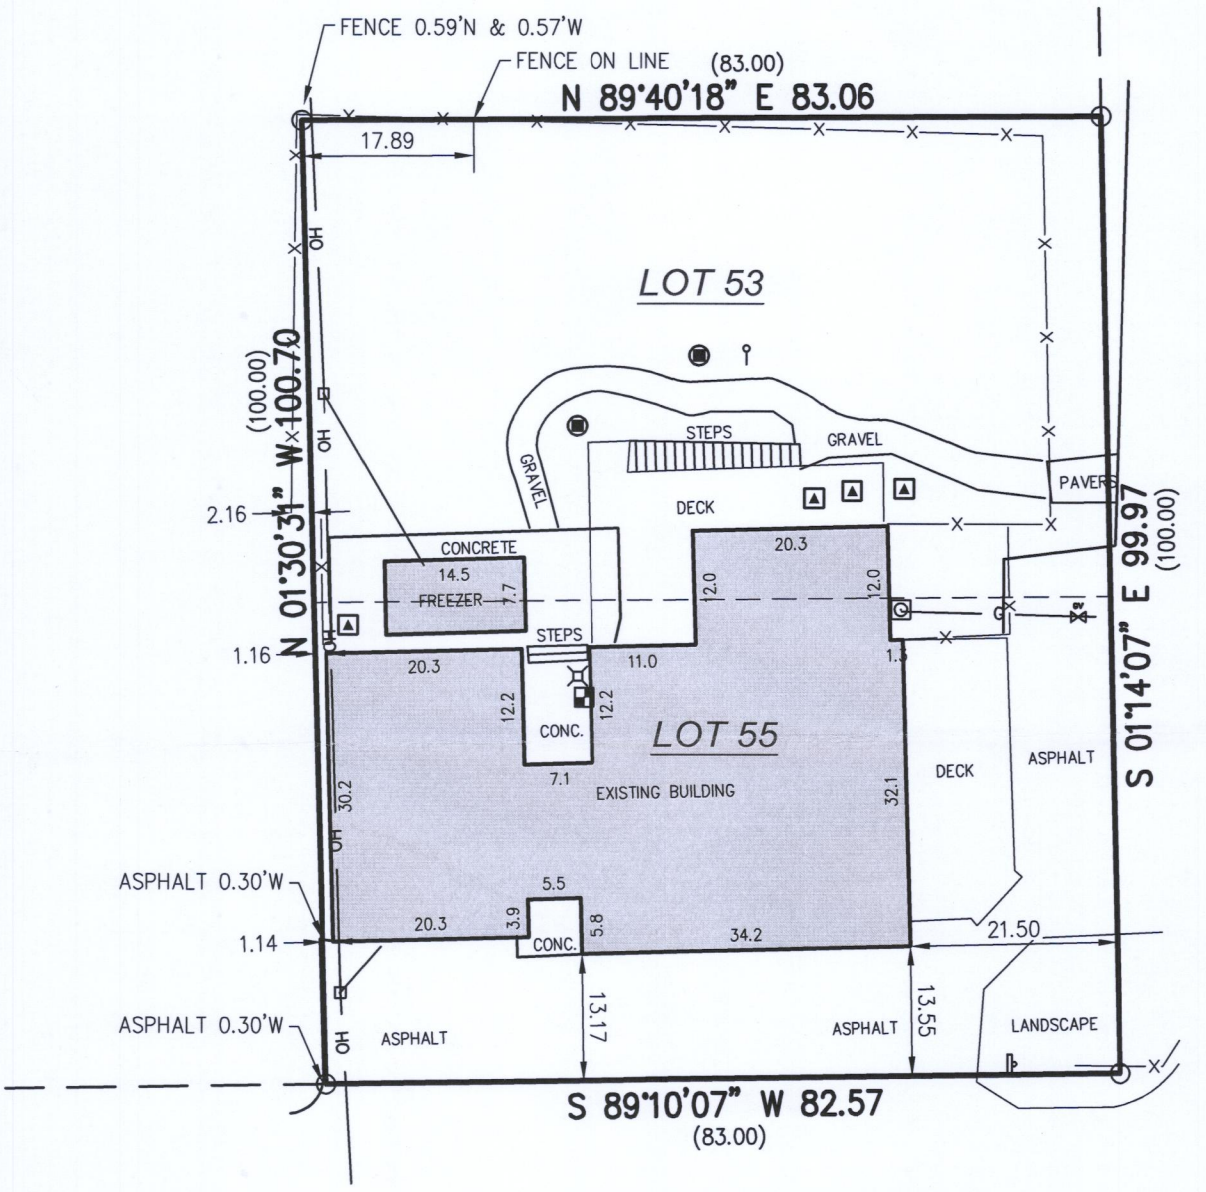

LAKE GENEVA CLUB LANE
(12.5' WIDE)

S. LAKESHORE DRIVE
(49.5' WIDE)

( ) = recorded as
= power pole
= found iron pipe
— OH — = overhead wires
= cleanout
= sign
= gas meter
GV = gas valve
= electric pedestal
— G — = gas line
— X — = fence
= electric meter
= hvac
= concrete lid

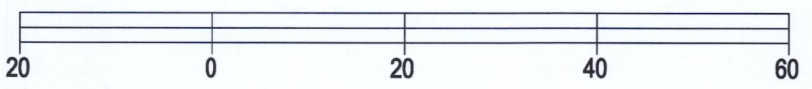

SCALE 1" = 20'

JOB # 2018.0314.01

TAX ID # ILGC 00044

BASIS OF BEARING OF THIS PLAT: THE US STATE PLANE COORDINATE SYSTEM SOUTH ZONE, NAD 83. WISCORS.

I hereby certify that I have surveyed the above- described property and the above map is a is a true representation thereof and shows the size and location of the property, its exterior boundaries, the location and dimensions of all structures thereon, fences, apparent easements and roadways and visible encroachments if any to the best of my knowledge and belief.

This survey is made for the present owners of the property, and those who purchase, mortgage, or guarantee the title thereto, within one year from the date hereof.

DATED THIS 9TH DAY OF OCTOBER, 2018.

RECEIVED
NOV 28 2018
By Jan

WISCONSIN
MARK R. MADSEN
S-2271
RACINE, WI
LAND SURVEYOR

MARK R. MADSEN S - 2271
Wisconsin Professional Land Surveyor

ILGC-44 117-4193