Plat of Survey

of


Lots 10 & 11 and Lots 35 thru 38 in Block 5 of Maple Hills Subdivision A,

located in the Southwest 1/4 of the Southeast 1/4 and the Southeast 1/4 of the Southwest 1/4 of Section 18, Town 1 North, Range 17 East, Town of Linn, Walworth County, Wisconsin.

Surveyed for: **Keefe Real Estate, Inc.**
P.O. Box 460
Lake Geneva, Wisconsin. 53147



Bearings referenced to the East line of Bird Lane, recorded as N1°20'00"E on the plat of Maple Hills Subdivision A.

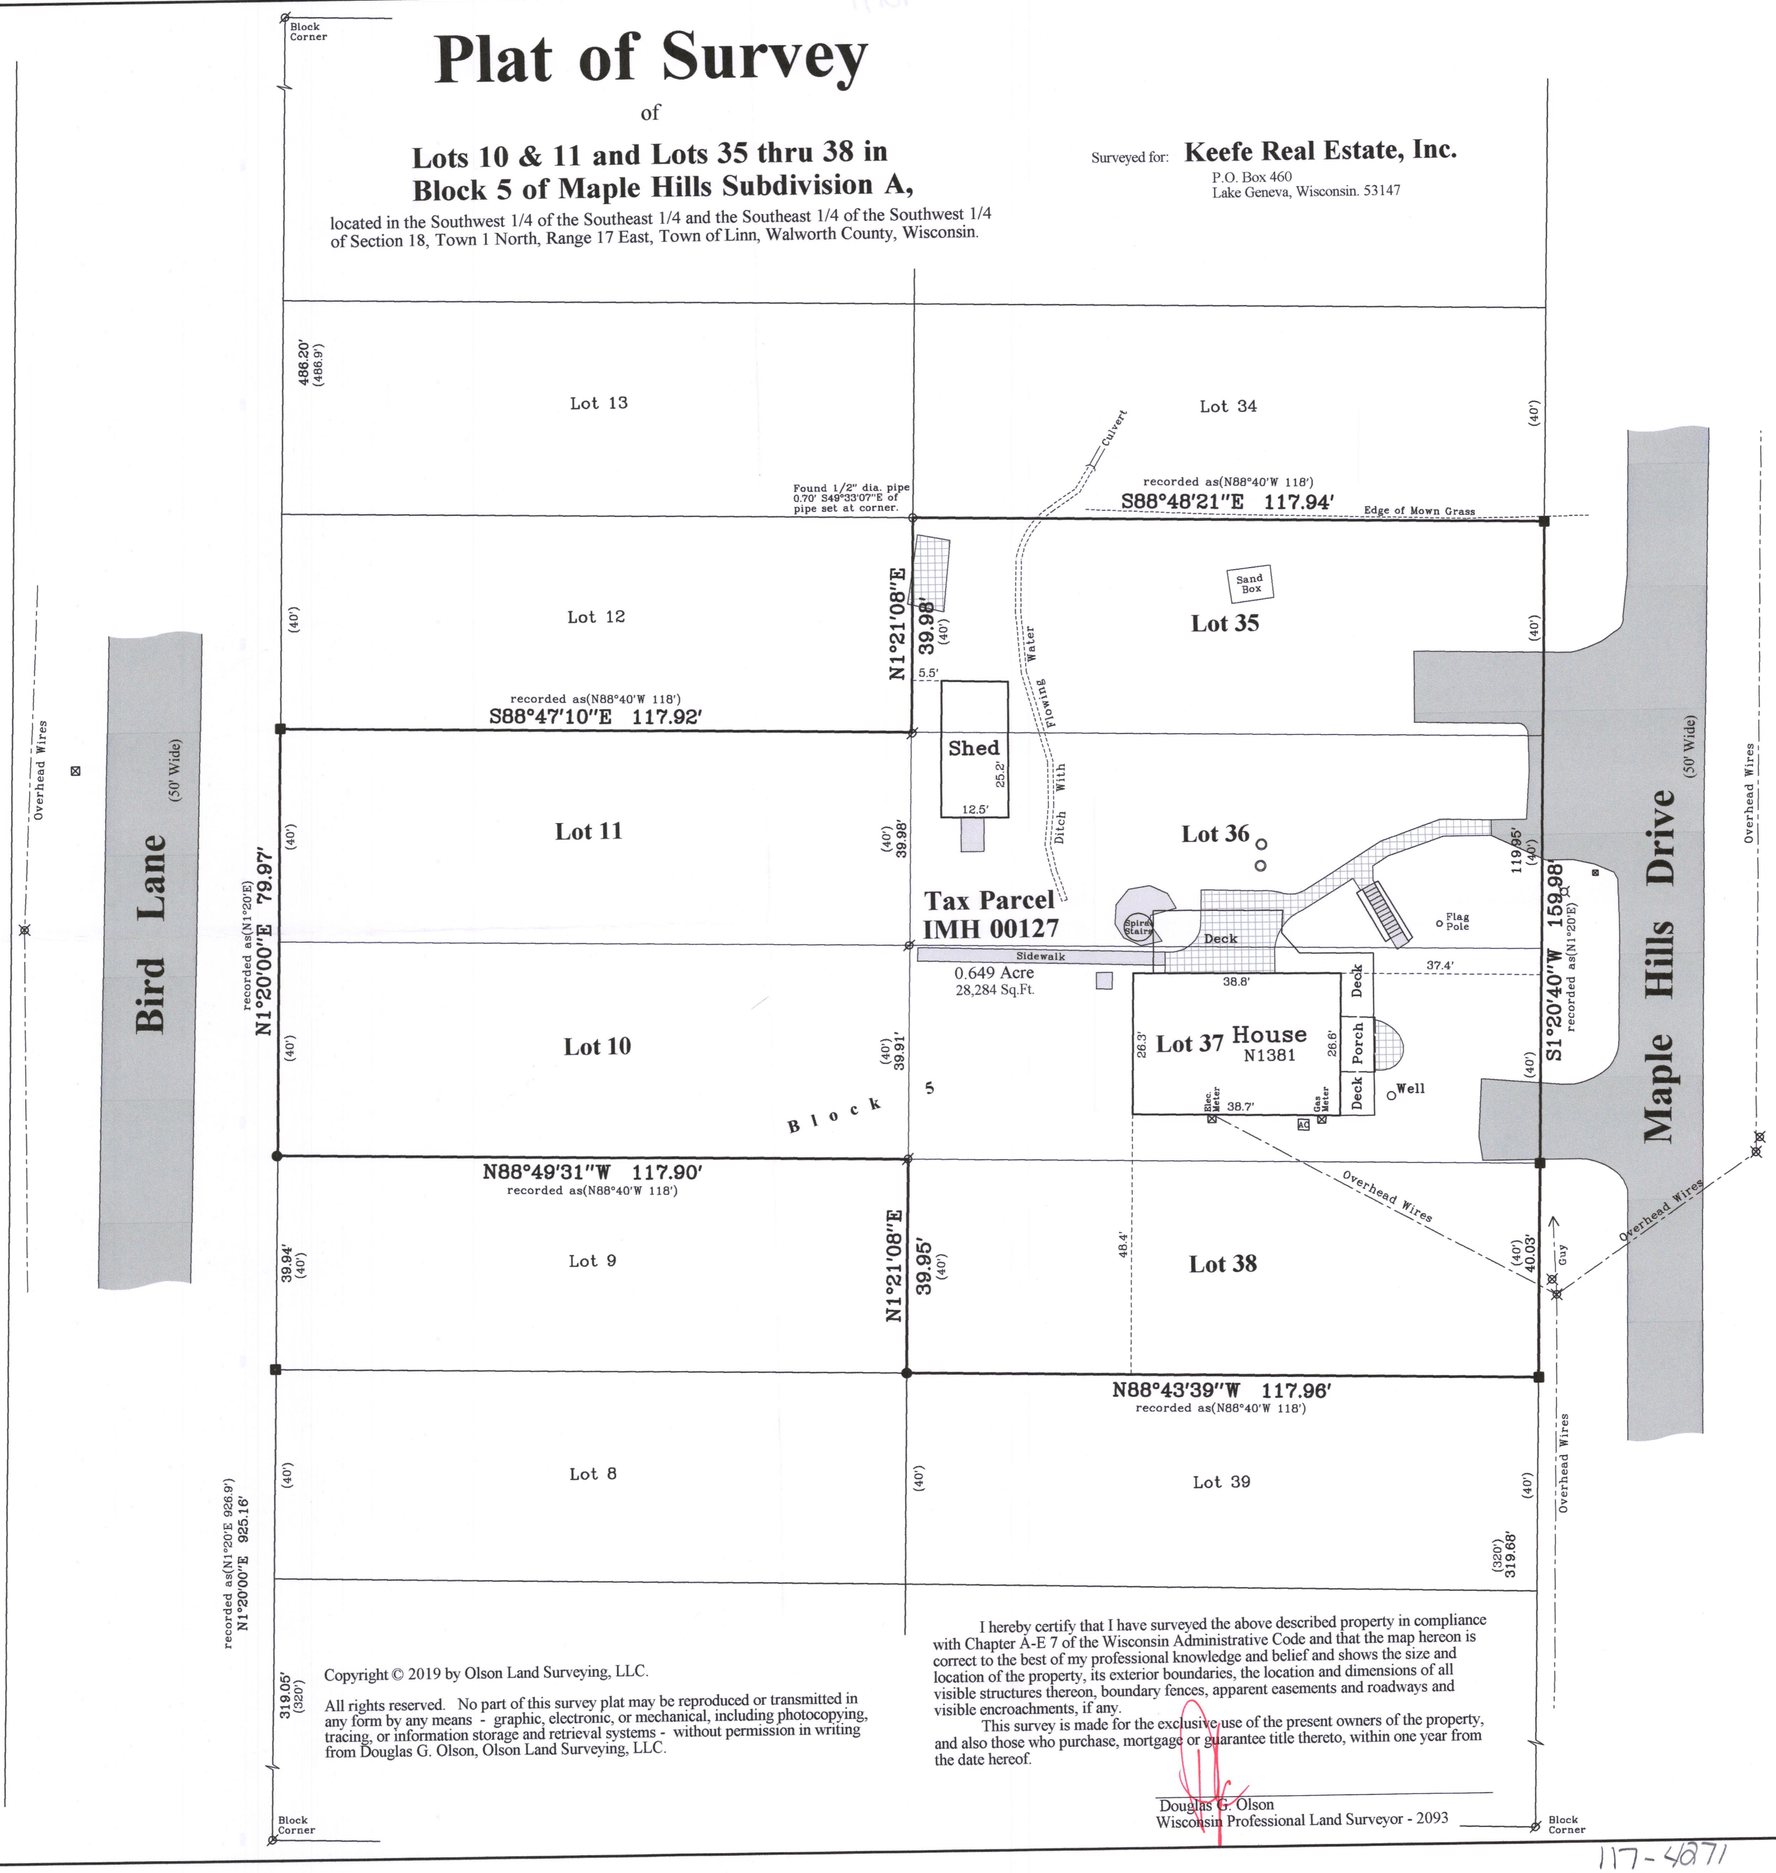

RECEIVED
AUG 7 2019
By

WISCONSIN
DOUGLAS OLSON
S-2093
ELKHORN, WI
LAND SURVEYOR
Not Certified Unless Stamped in Red.

Notes:

1) This Plat of Survey is not certified unless signed and sealed in red ink.
2) This survey is subject to Wisconsin lien laws. This Plat of Survey is the notice of intent to file lien. Lien waiver required.
3) The Survey Date shown on this Plat of Survey is the completion date of the field work.

Copyright © 2019 by Olson Land Surveying, LLC.

All rights reserved. No part of this survey plat may be reproduced or transmitted in any form by any means - graphic, electronic, or mechanical, including photocopying, tracing, or information storage and retrieval systems - without permission in writing from Douglas G. Olson, Olson Land Surveying, LLC.

I hereby certify that I have surveyed the above described property in compliance with Chapter A-E 7 of the Wisconsin Administrative Code and that the map hereon is correct to the best of my professional knowledge and belief and shows the size and location of the property, its exterior boundaries, the location and dimensions of all visible structures thereon, boundary fences, apparent easements and roadways and visible encroachments, if any.

This survey is made for the exclusive use of the present owners of the property, and also those who purchase, mortgage or guarantee title thereto, within one year from the date hereof.

Douglas G. Olson
Wisconsin Professional Land Surveyor - 2093

Survey Date: May 21, 2019.
Revisions:

Scale in Feet
1" = 20'
0' 10' 20' 40' 60'

OLSON
LAND SURVEYING, LLC
Rural | Residential | Commercial
45 South Wisconsin Street | P.O. Box 322
Elkhorn, Wisconsin. 53121
Telephone: (262) 723-3434
Facsimile: (262) 723-8044
Email: doug@olsonsurveying.com
Website: www.olsonsurveying.com

Legend of Symbols & Abbreviations

Found Iron Pipe
Found Iron Rod Square
Found Iron Rod, Rod Replaced, Tube
Recorded Information
Utility Pedestal
Concrete Cover
Asphalt Surface
Concrete Surface
Utility Pole
Light Pole
Brick Pavers

N North
S South
E East
W West
In Bearings
Degrees
' Minutes
" Seconds
In Distances
Feet
" Inches

Sheet 1 of 1 Sheets

Drawing Name:

Job Reference Number
2019.057

2019.057

117-4071