LAND-MARK SURVEYING
Mark L. Miritz
Wisconsin Professional Land Surveyor S-2582


N9330 Knuteson Drive
Whitewater, WI 53190
Phone:(262)495-3284
MARKMIRITZ@
LAND-MARKSURVEYING.COM


ORDERED BY:
HUMMEL CONSTRUCTION
N1958 COUNTY ROAD "O"
DELAVAN, WI 53115

PLAT OF SURVEY

LOTS 12, 13, 14 AND 15, BLOCK 7, MAPLE HILLS "A", LOCATED IN THE SOUTHWEST 1/4 OF SECTION 18, TOWN 1 NORTH, RANGE 17 EAST, TOWN OF LINN, WALWORTH COUNTY, WISCONSIN.

19,731 TOTAL SQ. FT.

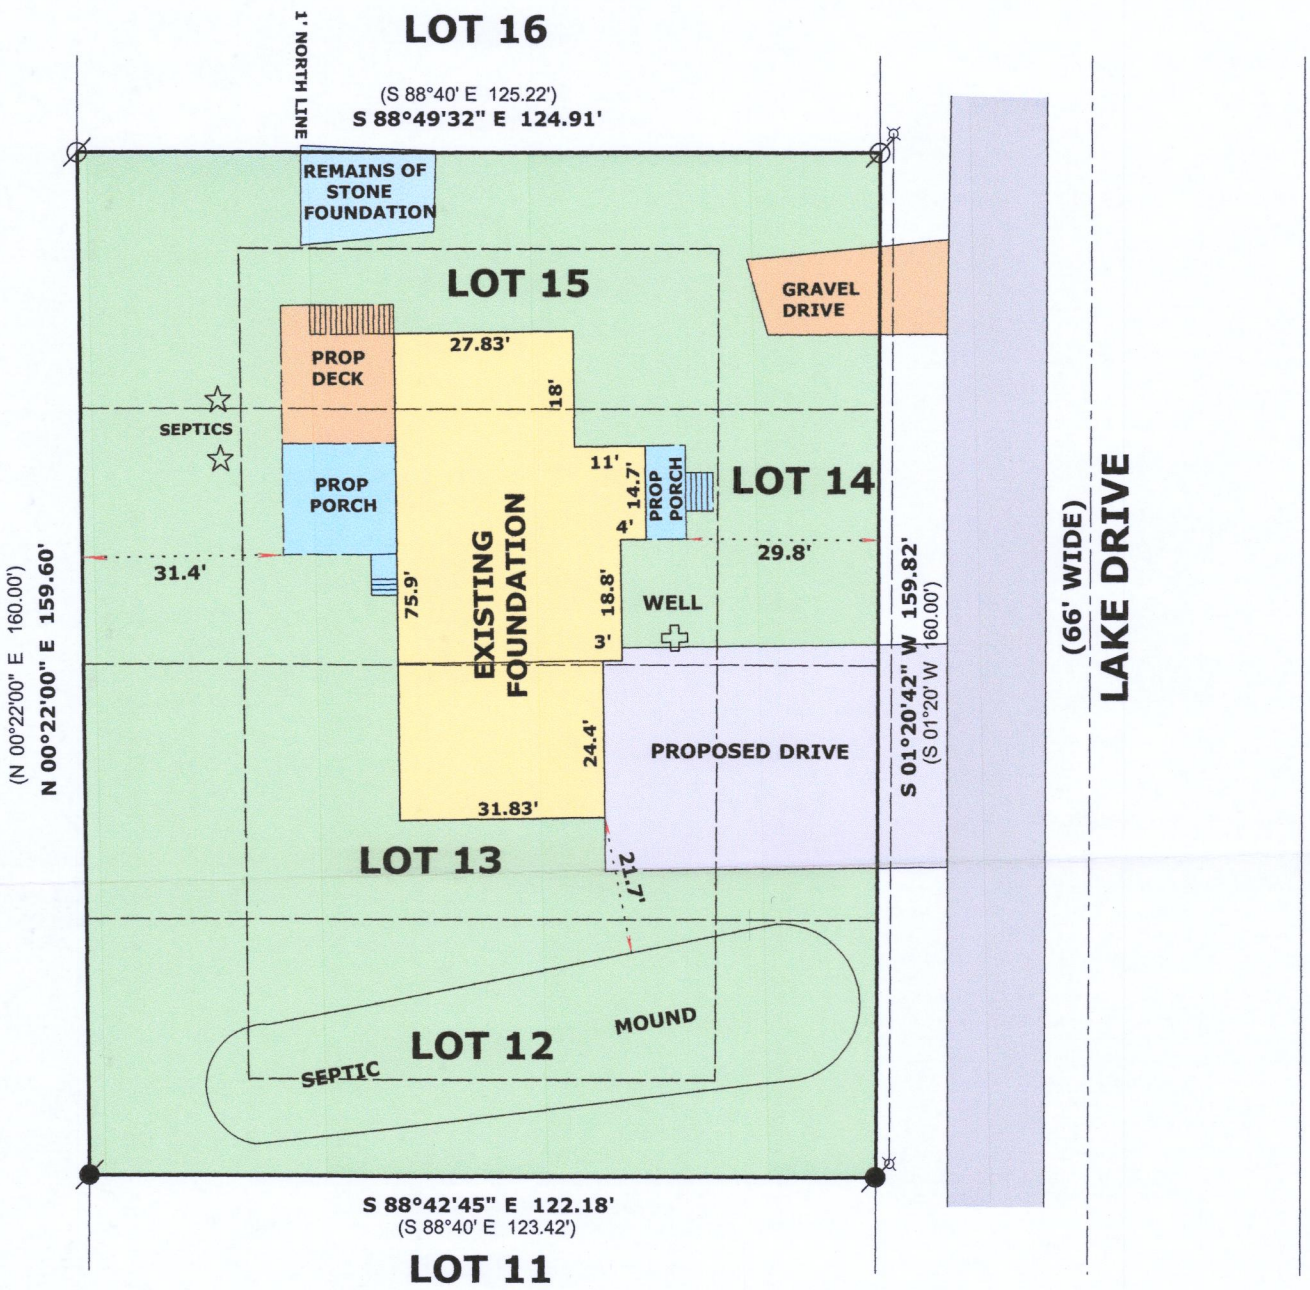

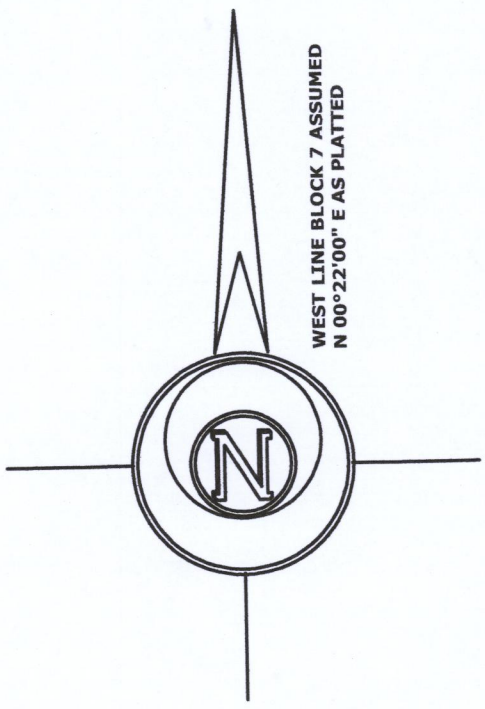

LEGEND

∅	FOUND IRON PIPE 1 1/4"
●	FOUND IRON ROD 3/4"
☼	UTILITY POLE
(xx)	RECORDED AS DIMENSION

RECEIVED
SEP 23 2019
By

WISCONSIN
MARK L. MIRITZ
S-2582
WHITEWATER, WI
LAND SURVEYOR

SCALE: 1 INCH = 30 FEET

"I hereby certify that the above described property has been surveyed by me or under my direction and that the above map is a true representation thereof and shows the size and location of the property, its exterior boundaries, the location of all visible structures and dimensions of all principal buildings thereon, boundary fences, apparent easements, roadways and visible encroachments, if any."
"This survey is made for the use of the present owners of the property, and also those who purchase, mortgage, or guarantee the title thereto within one year from date hereof."

Mark L. Miritz

MARK L. MIRITZ
WISCONSIN PROFESSIONAL LAND SURVEYOR S-2582

REVISESD JULY 31, 2019 TO SHOW NEW SEPTIC AND FOUNDATION AS BUILT

DATE: NOV. 3, 2018 **JOB NO.** 18.1102

IMH-185

117-4288