
PLAT OF SURVEY

A PARCEL OF LAND LOCATED IN THE NORTHWEST 1/4 OF THE NORTHEAST 1/4 OF SECTION 5 IN TOWNSHIP 1 NORTH, RANGE 17 EAST, IN THE TOWN OF LINN, WALWORTH COUNTY, WISCONSIN.

LEGEND

- FOUND 1" IRON PIPE
- (S) SEPTIC LID
- (XX) RECORDED AS
- EXISTING CONCRETE
- EXISTING ASPHALT DRIVE
- EXISTING BUILDING
- EXISTING STONE

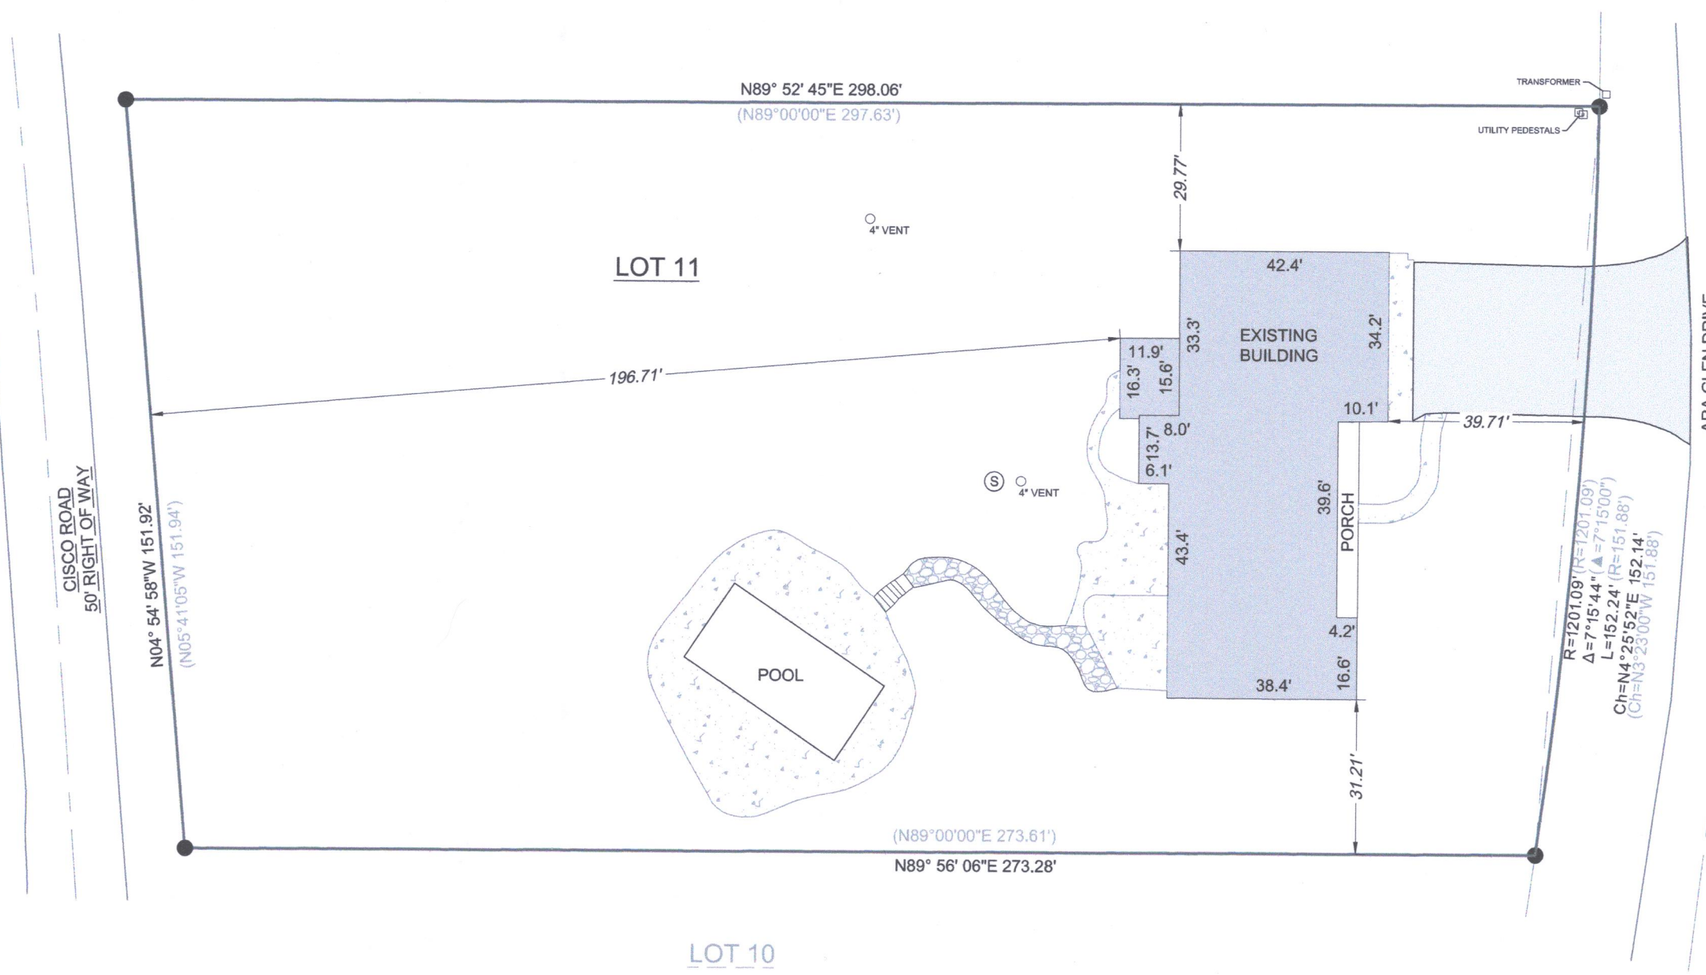

N

0 30 60 Feet

SCALE: 1'=30'

NOTE:
1. BASIS OF BEARING: THE WISCONSIN STATE PLANE COORDINATE SYSTEM, NAD-27, SOUTH ZONE.
2. FIELD WORK COMPLETED SEPTEMBER 20TH, 2019
3. BUILDING SURVEYED TO THE EXTERIOR OF SIDING.

LEGAL DESCRIPTION:

A PARCEL OF LAND LOCATED IN THE NORTHWEST 1/4 OF THE NORTHEAST 1/4 OF SECTION 5 IN TOWNSHIP 1 NORTH, RANGE 17 EAST, IN THE TOWN OF LINN, WALWORTH COUNTY, WISCONSIN, MORE PARTICULARLY DESCRIBED AS:

LOT 11 OF THE ARA GLEN ESTATES SUBDIVISION AS RECORDED IN DOCUMENT #27133 FOUND IN THE WALWORTH COUNTY REGISTER OF DEEDS.

RECEIVED
DEC 16 2019
By

SURVEY ORDERED BY:

KEEFE REALTY

PROPERTY ADDRESS:

N2425 ARA GLENDRIVE
LAKE GENEVA, WI 53147

SURVEYOR:

PAUL H. VAN HENKELUM,PLS
CARDINAL ENGINEERING LLC

WISCONSIN PAUL H. VAN HENKELUM S-1931 LAKE GENEVA, WI LAND SURVEYOR 9/30/19

"I HEREBY CERTIFY THAT I HAVE SURVEYED THE ABOVE DESCRIBED PROPERTY AND THE MAP IS A TRUE AND CORRECT REPRESENTATION OF ITS EXTERIOR BOUNDARIES AND SHOWS THE SIZE AND LOCATION OF ALL VISIBLE STRUCTURES, APPARENT EASEMENTS AND ENCROACHMENTS, IF ANY.

PAUL H VAN HENKELUM, PLS #1931 — DATE 9/30/19

CARDINAL ENGINEERING LLC
DESIGNING IN TRUE DIRECTIONS

201 BROAD STREET, STE. B
LAKE GENEVA, WI 53147
262-757-8776
CARDINALENGINEERINGWI.COM

DATE: 9-30-2019 JOB No. 1901390
SHEET 1 0F 1

IAW-11 117-4321