
PREPARED FOR
SUNRISE HOMES,
INC.

AS-BUILT DRAWING

Lot 34 Meadow View Estates, a Subdivision, in the Southwest 1/4 of the Southeast 1/4 of Section 17, Township 1 North, Range 17 East of the Fourth Principal Meridian, in the Town of Linn, Walworth County, Wisconsin.

PATHFINDER SURVEYING
(a NMB Company)
1458 HORIZON BLVD. STE. 200
RACINE, WI. 53406
WWW.PATHFINDERSURVEYING.NET
262-248-8303

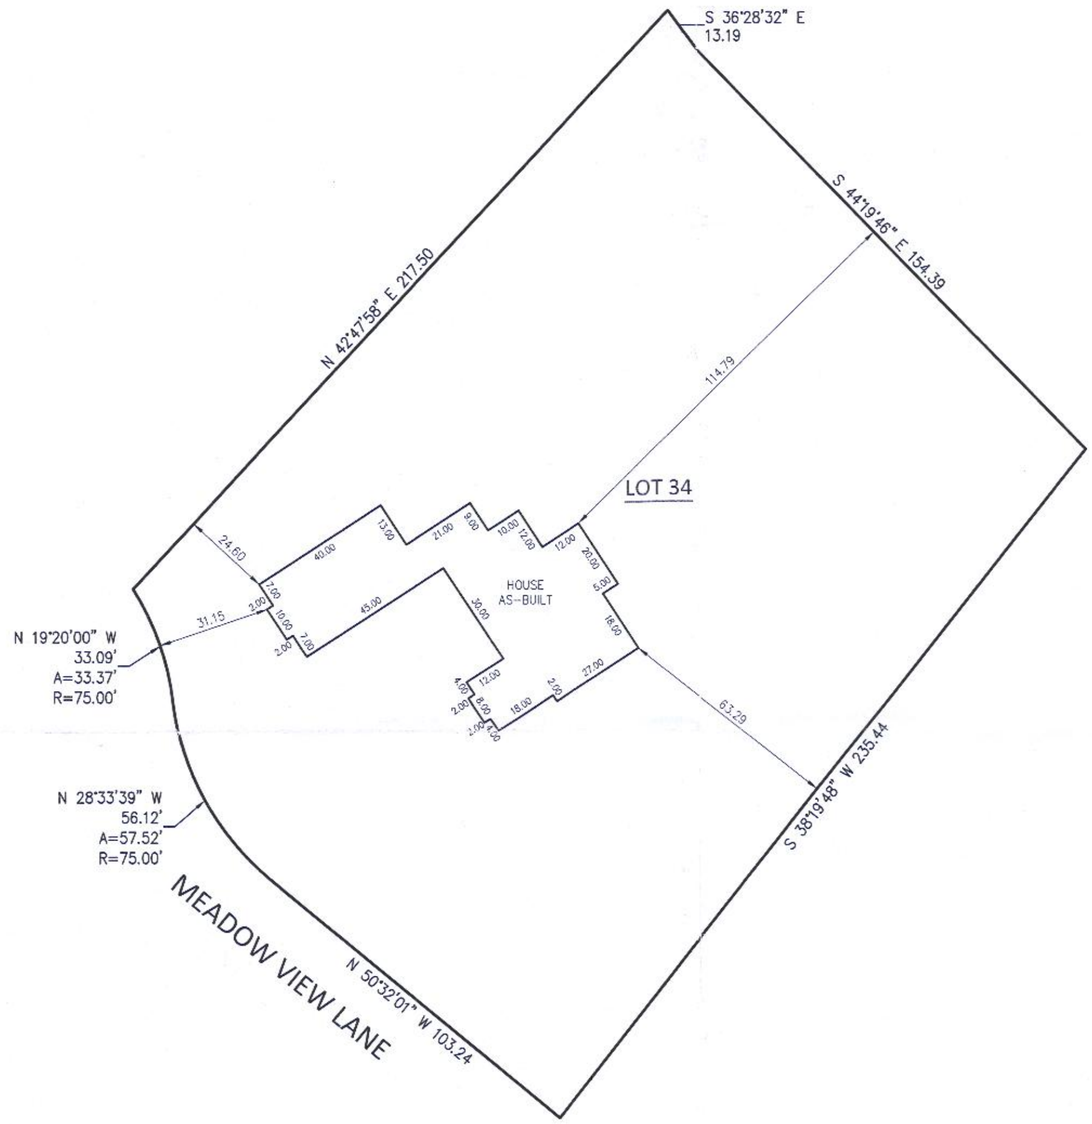

30 0 30 60 90

Basis of Bearing of this plat: The US State Plane Coordinate System South Zone, NAD 83. WISCORS.

FOUNDATION CERTIFICATION
The foundation of the residence depicted hereon has been constructed as located. Top of Foundation = 1055.94.

August 22, 2019

PROPERTY ADDRESS: W4292 Meadow View Lane

WISCONSIN
MARK R. MADSEN
S-2271
RACINE, WI
LAND SURVEYOR

RECEIVED
APR 27 2020
By

SCALE 1" = 30'

JOB # 2019.0145.01

TAX ID # IMEA 00034

117-4356