


PLAT OF SURVEY & TOPOGRAPHIC MAPPING
LOT 1 OF CERTIFIED SURVEY MAP NO. 1803

LOCATED IN PART OF THE SE 1/4 OF THE NE 1/4
OF SECTION 18, TOWN 1 NORTH, RANGE 17 EAST,
TOWN OF LINN, WALWORTH COUNTY, WISCONSIN

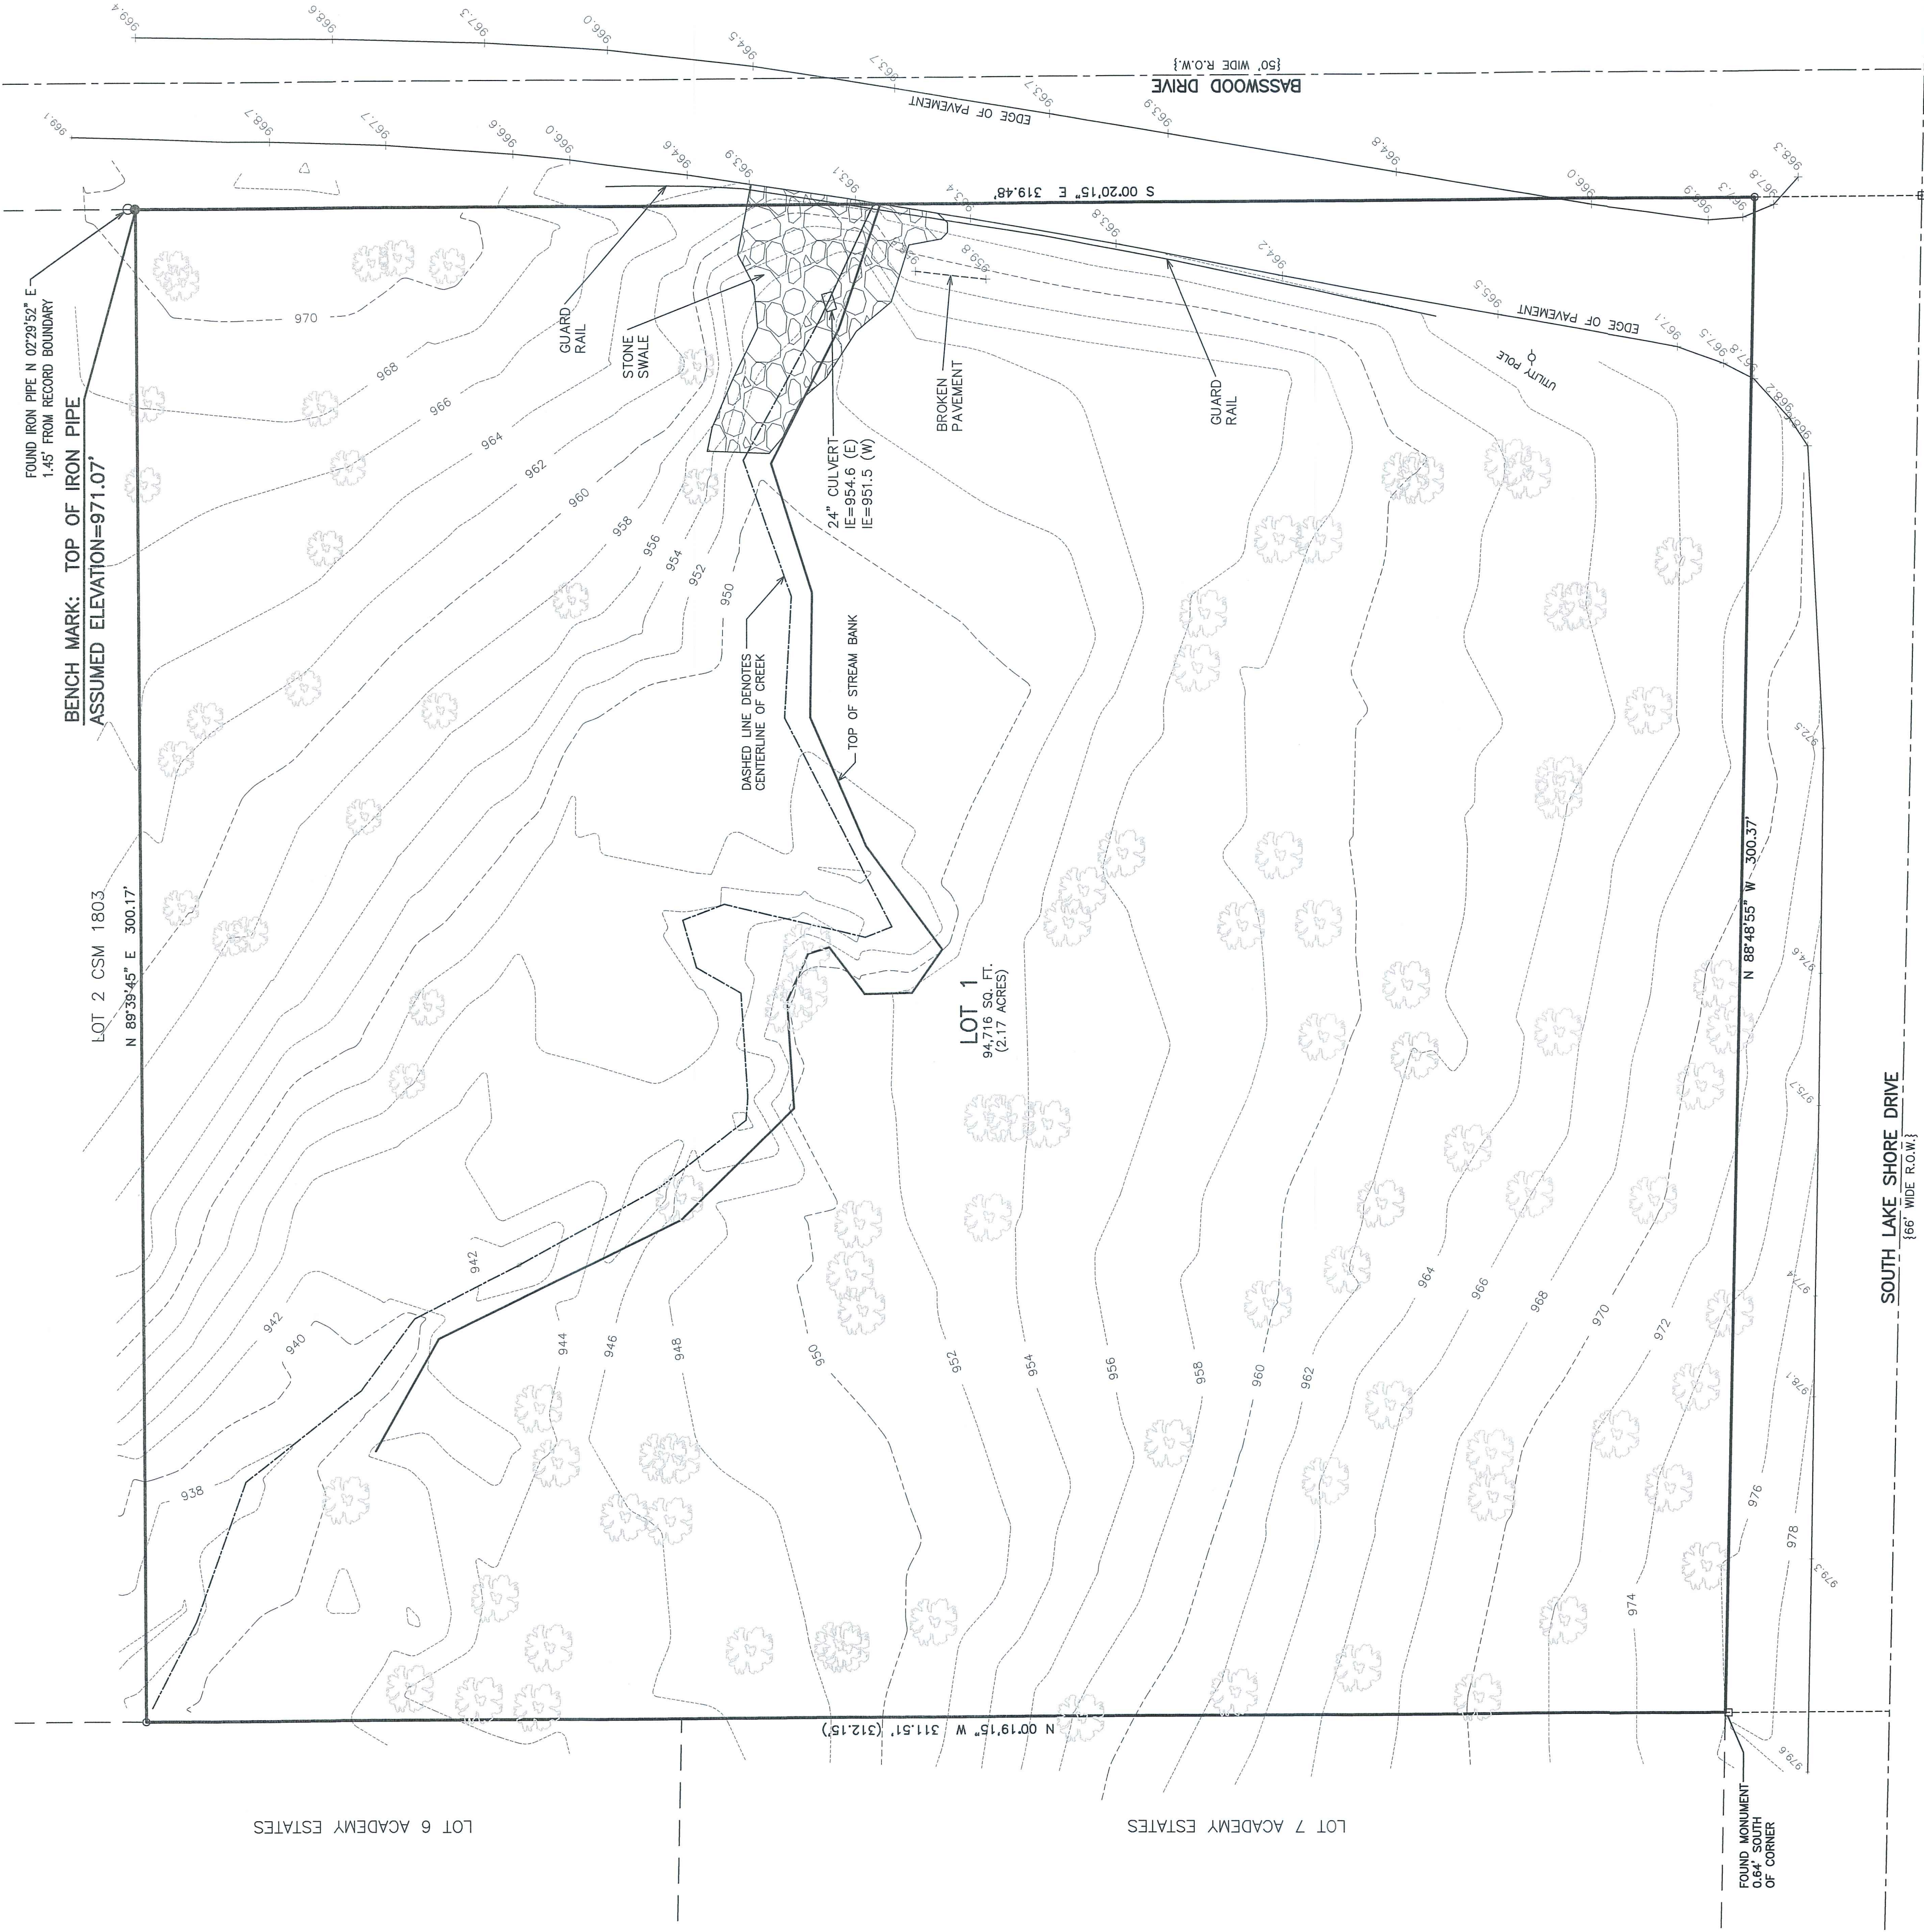

LEGEND
○ = FOUND IRON PIPE STAKE
□ = FOUND GRANITE MONUMENT
{xxx} = RECORDED AS



NOTE: RECORDED GSM IS 0.84' OUT OF CLOSURE
WEST LINE LOT 1 RECORDED AS 312.51'
SHOULD BE 311.51'

NOTE: COPIES OF THIS MAP TO WHICH THE FOLLOWING CERTIFICATE WILL APPLY SHOW
THE SURVEYOR'S ORIGINAL SEAL AND SIGNATURE IN RED INK. COPIES BY ANY OTHER
MEANS MAY HAVE ALTERATIONS WHICH DO NOT REPRESENT THE SURVEYOR'S WORK
PRODUCT.

I HEREBY CERTIFY THAT THE ABOVE DESCRIBED PROPERTY HAS BEEN SURVEYED
UNDER MY DIRECTION AND THAT THE ABOVE MAP IS A TRUE REPRESENTATION
THEREOF AND SHOWS THE SIZE AND LOCATION OF THE PROPERTY AND ITS EXTERIOR
BOUNDARIES. THIS SURVEY IS MADE FOR THE USE OF THE PRESENT OWNERS OF THE
PROPERTY, AND ALSO THOSE WHO PURCHASE, MORTGAGE, OR GUARANTEE THE TITLE
THERE TO WITHIN ONE YEAR FROM THE DATE HEREOF.

DATED: 11/19/2020

Brian M. Carlson
BRIAN M. CARLSON P.L.S. 2039

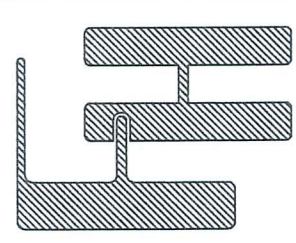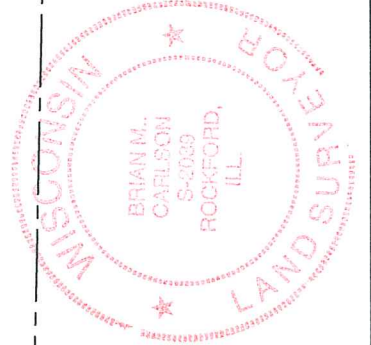

TOPOGRAPHIC SURVEY
PARCEL SOUTH OF W4534 BASSWOOD DRIVE
LAKE GENEVA, WI 53147

- WORK ORDERED BY -
BRUCE WILKINSON
1775 TALLGRASS LANE
LAKE FOREST, IL 60045

FARRIS, HANSEN & ASSOCIATES, INC.
ENGINEERING - ARCHITECTURE - SURVEYING
7 RIDGWAY COURT
ELKHORN, WISCONSIN 53121
P.O. BOX 437
OFFICE: (262) 723-2098 FAX: (262) 723-5886

REVISIONS
11/19/2020 - LB
UPDATE PAVEMENT &
ADD DRAINAGE AREA

PROJECT NO.
7513.08
DATE
05/08/2008
SHEET NO.
1 OF 1