

HAROLD H. KOLB

REGISTERED PROFESSIONAL LAND SURVEYOR
LAKE GENEVA, WISCONSIN

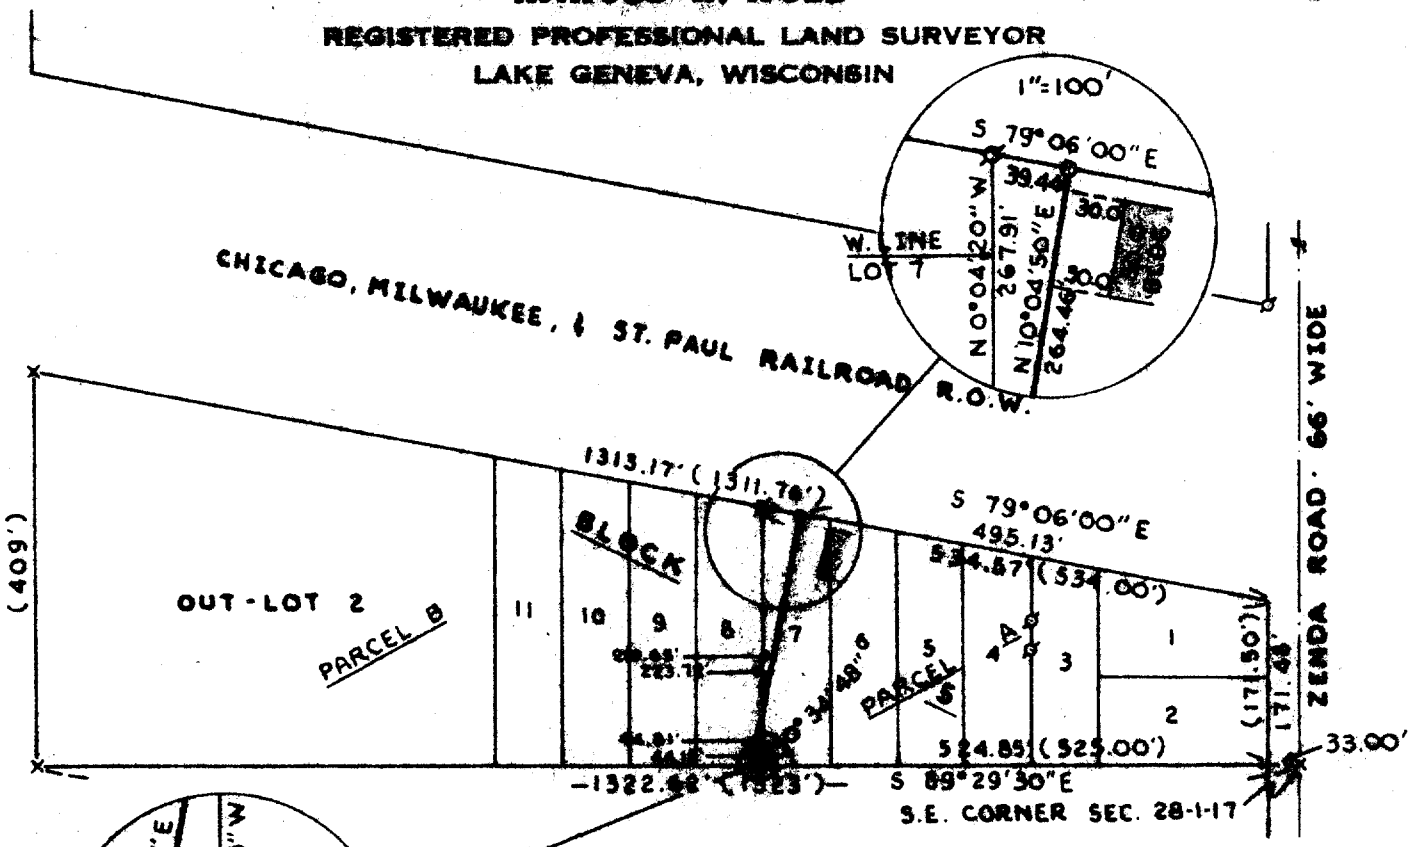

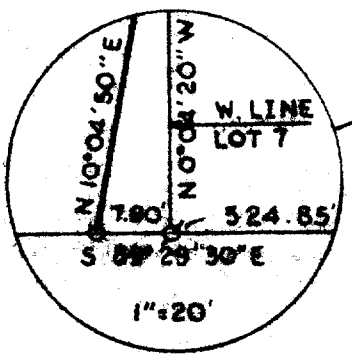

N

SCALE: 1"=200'

PLAT OF SURVEY OF

A property line adjustment between Lots 7 and 8, Block 5, Zenda Subdivision, Section 28, T 1 N, R 17 E, Walworth County, Wisconsin.

NOTE: Bearings are assumed as shown on existing survey records.

LEGEND

- ϕ — IRON PIPE FOUND
- O — IRON PIPE PLACED
- ● — CONCRETE MONUMENT
- X — SPIKE
- ( ) — AS PLATTED

WISCONSIN
HAROLD H KOLB
S-187
LAKE GENEVA
WIS.
LAND SURVEYOR

I, HAROLD H. KOLB, DO HEREBY CERTIFY THAT I HAVE SURVEYED THE PROPERTY HEREON DESCRIBED ACCORDING TO THE OFFICIAL RECORDS, AND THAT THE PLAT HEREON IS A CORRECT REPRESENTATION OF THE LOT LINES.

Harold H. Kolb

HAROLD H. KOLB
WISCONSIN REGISTERED LAND SURVEYOR, S-187
DATE June 11, 1974

IZ-29 & 29A

117-445