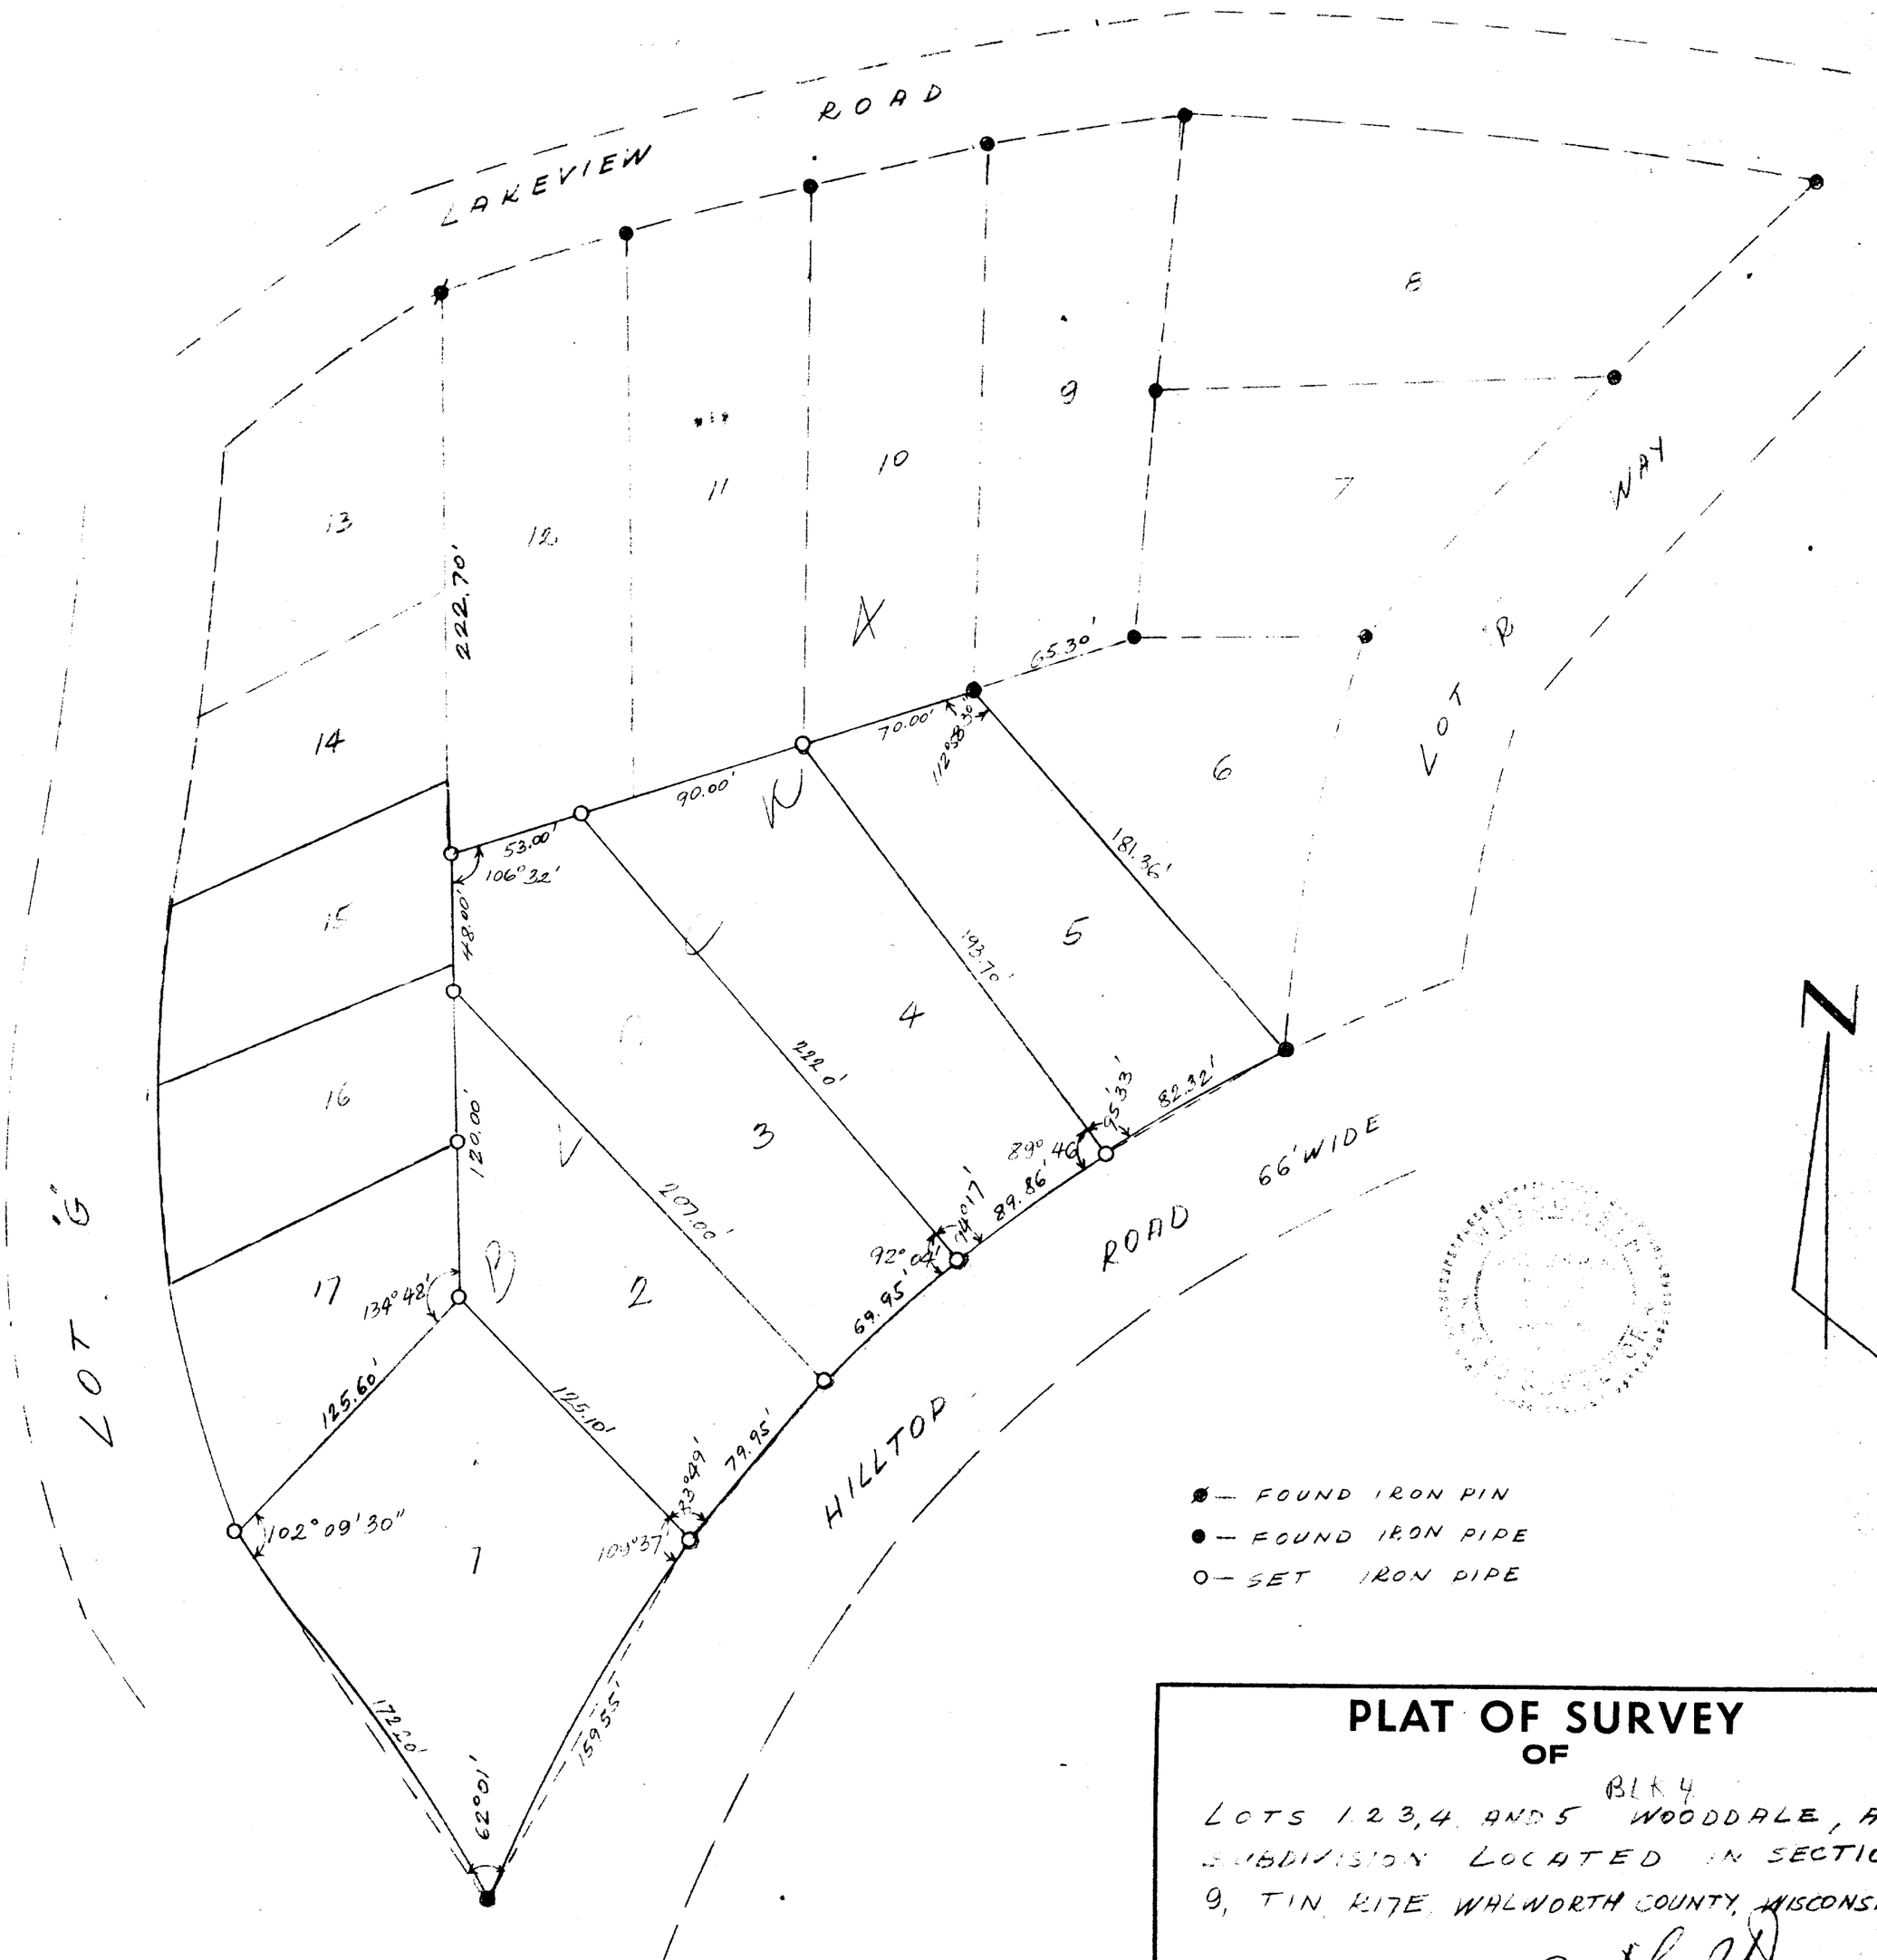

PLAT OF SURVEY
OF

LOTS 1, 2, 3, 4, AND 5 BLK 4 WOODDALE, A SUBDIVISION LOCATED IN SECTION 9, T1N, R17E, WALWORTH COUNTY, WISCONSIN

SURVEYOR

SCALE 1" = 50'

DATE NOV 7-1974

IW - 43A
" 44
" 45 A + 45 (part of)

NO. 175H 300 9-68

117-453