
PLAT OF SURVEY

A PARCEL OF LAND LOCATED IN THE SOUTHWEST 1/4 OF THE NORTHEAST 1/4 OF SECTION 5 IN TOWNSHIP 1 NORTH, RANGE 17 EAST, IN THE TOWN OF LINN, WALWORTH COUNTY, WISCONSIN.

MORE PARTICULARLY DESCRIBED AS:
LOT 1 AND THE S. 40' OF LOT 2 OF SYLVAN TRAIL ESTATES AS RECORDED IN DOCUMENT NO. P260874 IN THE WALWORTH COUNTY REGISTER OF DEEDS.

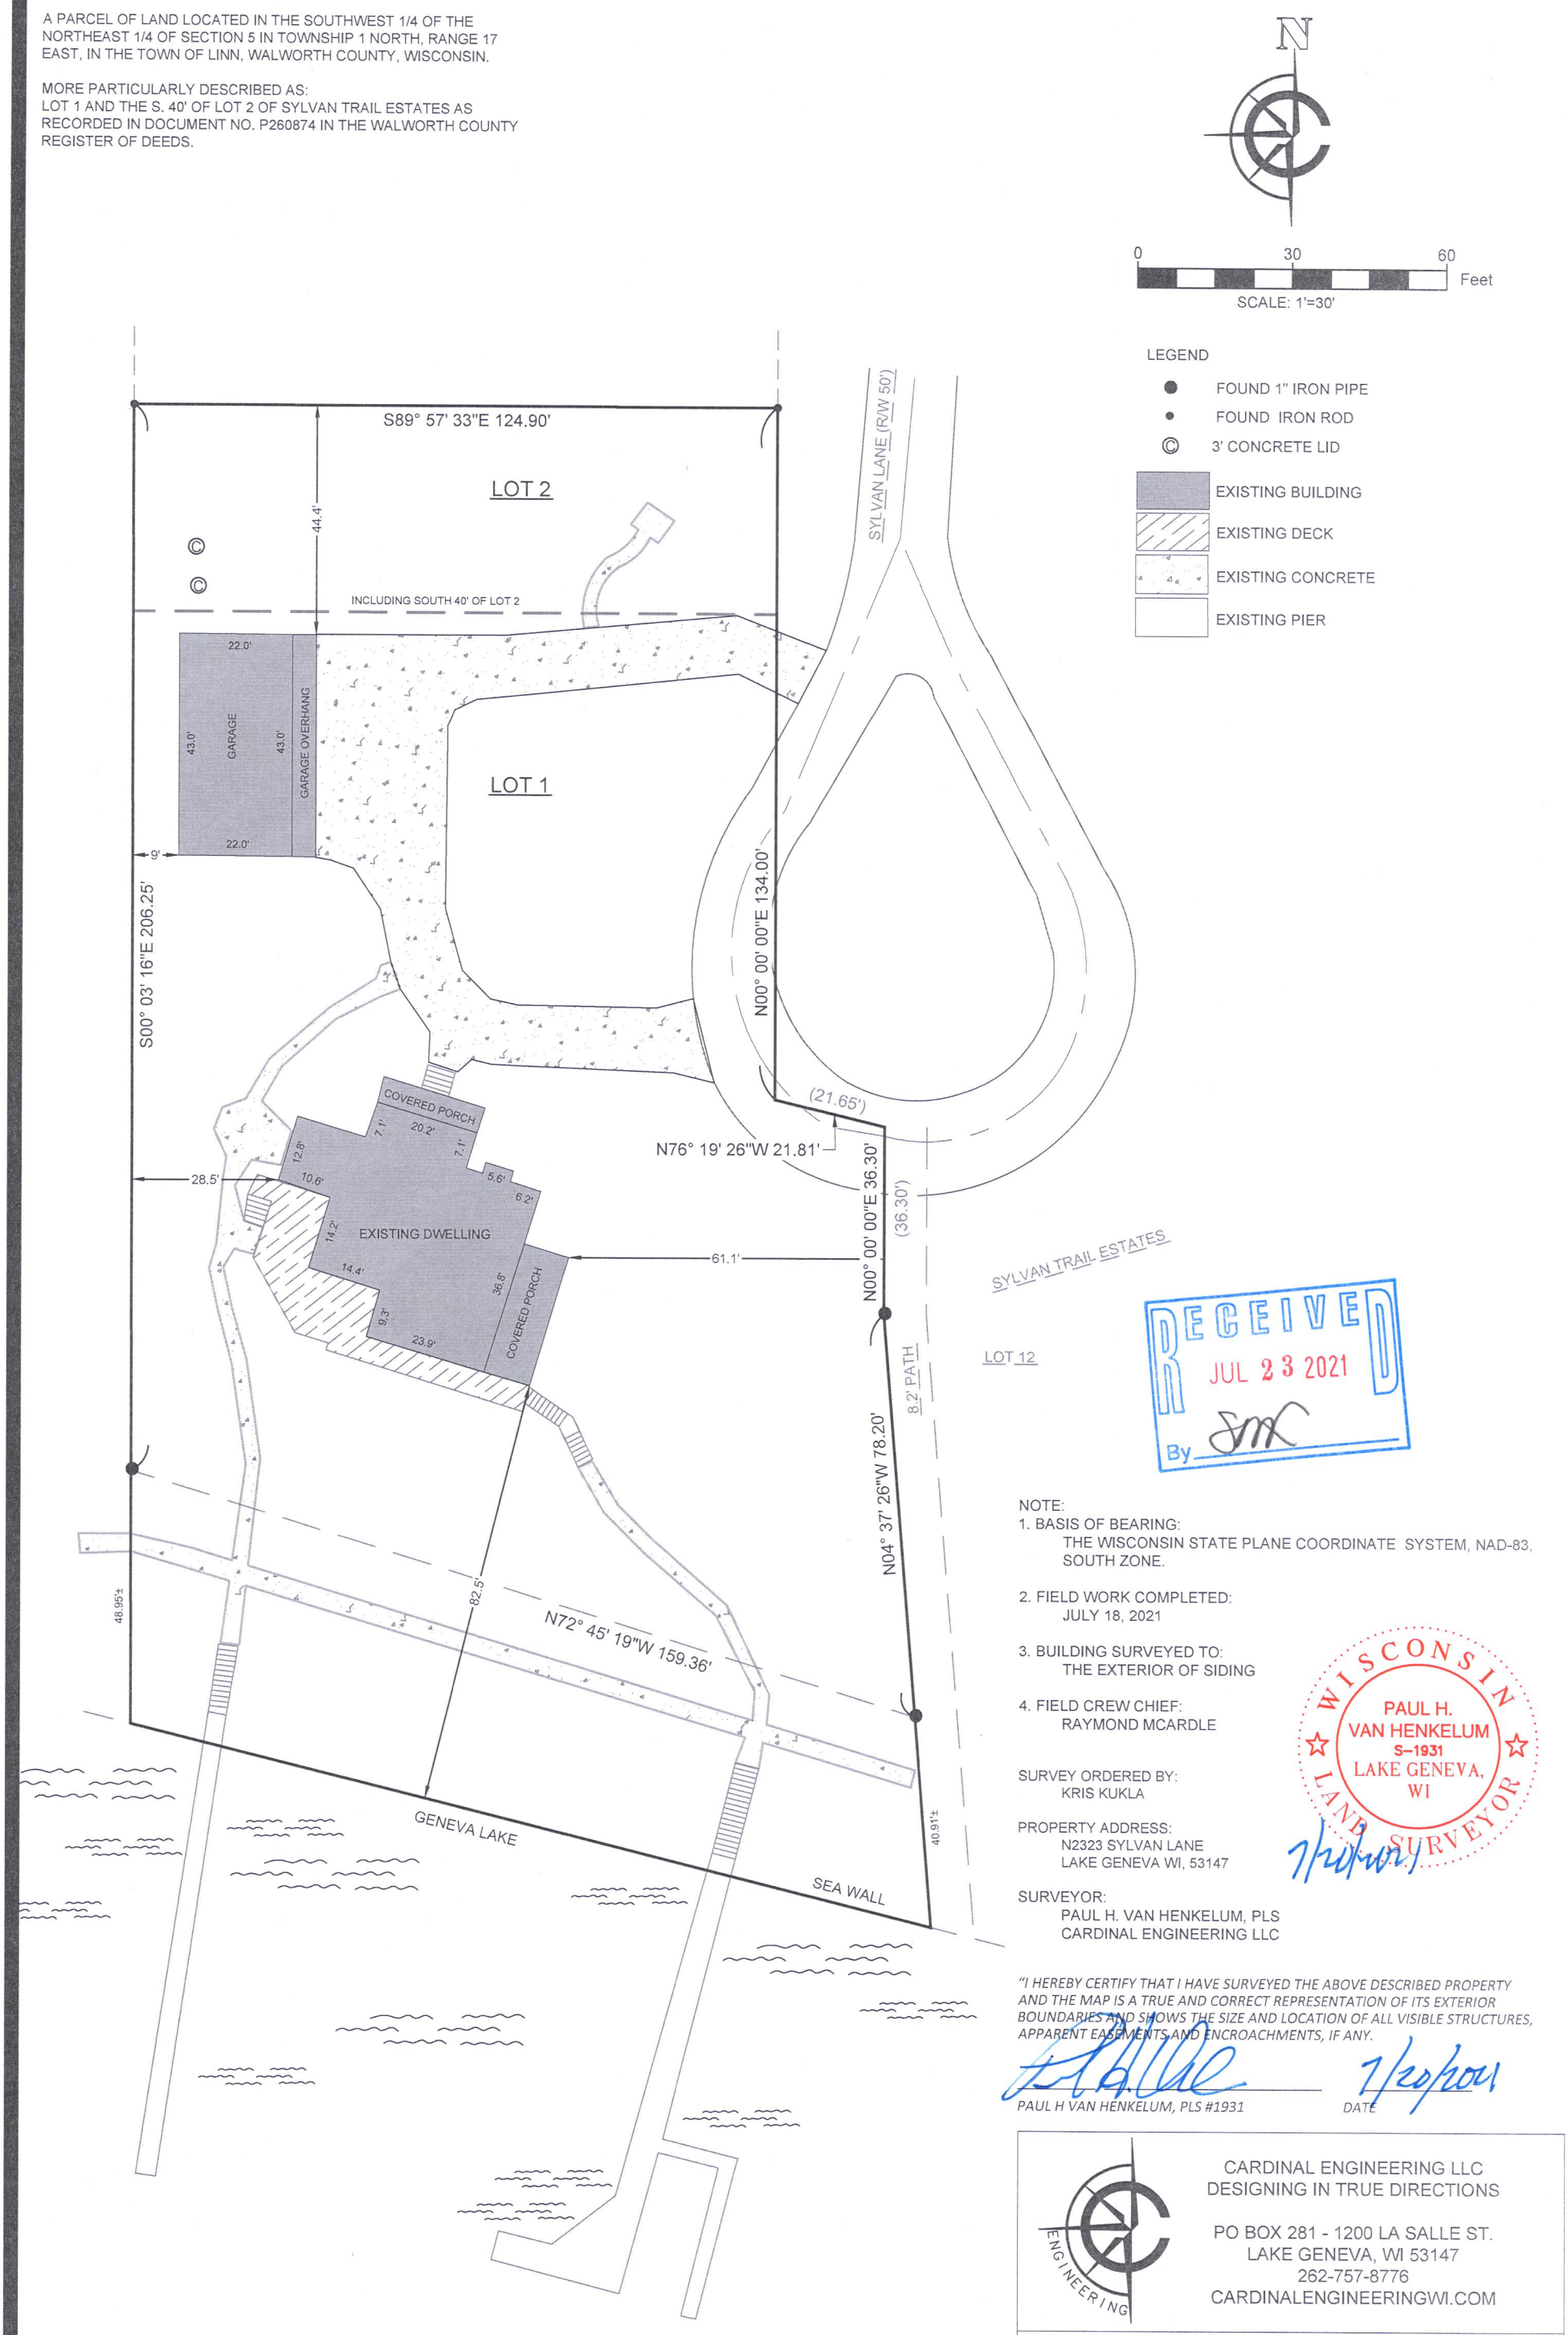

RECEIVED
JUL 23 2021
By

NOTE:
1. BASIS OF BEARING:
THE WISCONSIN STATE PLANE COORDINATE SYSTEM, NAD-83, SOUTH ZONE.

2. FIELD WORK COMPLETED:
JULY 18, 2021

3. BUILDING SURVEYED TO:
THE EXTERIOR OF SIDING

4. FIELD CREW CHIEF:
RAYMOND MCARDLE

SURVEY ORDERED BY:
KRIS KUKLA

PROPERTY ADDRESS:
N2323 SYLVAN LANE
LAKE GENEVA WI, 53147

SURVEYOR:
PAUL H. VAN HENKELUM, PLS
CARDINAL ENGINEERING LLC

WISCONSIN
PAUL H. VAN HENKELUM
S-1931
LAKE GENEVA, WI
LAND SURVEYOR
7/20/21

"I HEREBY CERTIFY THAT I HAVE SURVEYED THE ABOVE DESCRIBED PROPERTY AND THE MAP IS A TRUE AND CORRECT REPRESENTATION OF ITS EXTERIOR BOUNDARIES AND SHOWS THE SIZE AND LOCATION OF ALL VISIBLE STRUCTURES, APPARENT EASEMENTS AND ENCROACHMENTS, IF ANY.

PAUL H VAN HENKELUM, PLS #1931 *DATE* 7/20/2021

CARDINAL ENGINEERING LLC
DESIGNING IN TRUE DIRECTIONS

PO BOX 281 - 1200 LA SALLE ST.
LAKE GENEVA, WI 53147
262-757-8776
CARDINALENGINEERINGWI.COM

DATE: 07/16/2021 JOB No 21448
SHEET 1 0F 1 LWG

1ST - 1

117-4546