# PLAT OF SURVEY

A PARCEL OF LAND LOCATED IN THE NORTHEAST 1/4 OF THE SOUTHWEST 1/4 AND THE NORTHWEST 1/4 OF THE SOUTHEAST 1/4 OF SECTION 16 IN TOWNSHIP 1 NORTH, RANGE 17 EAST, IN THE TOWN OF LINN, WALWORTH COUNTY, WISCONSIN.


MORE PARTICULARLY DESCRIBED AS:
LOT 37 OF THE WOODSTONE SUBDIVISION RECORDED IN DOCUMENT NO. 620174 PER THE WALWORTH COUNTY REGISTER OF DEEDS.

RECEIVED
SEP - 7 2021
By

N

0 40 80 Feet

SCALE: 1'=40'

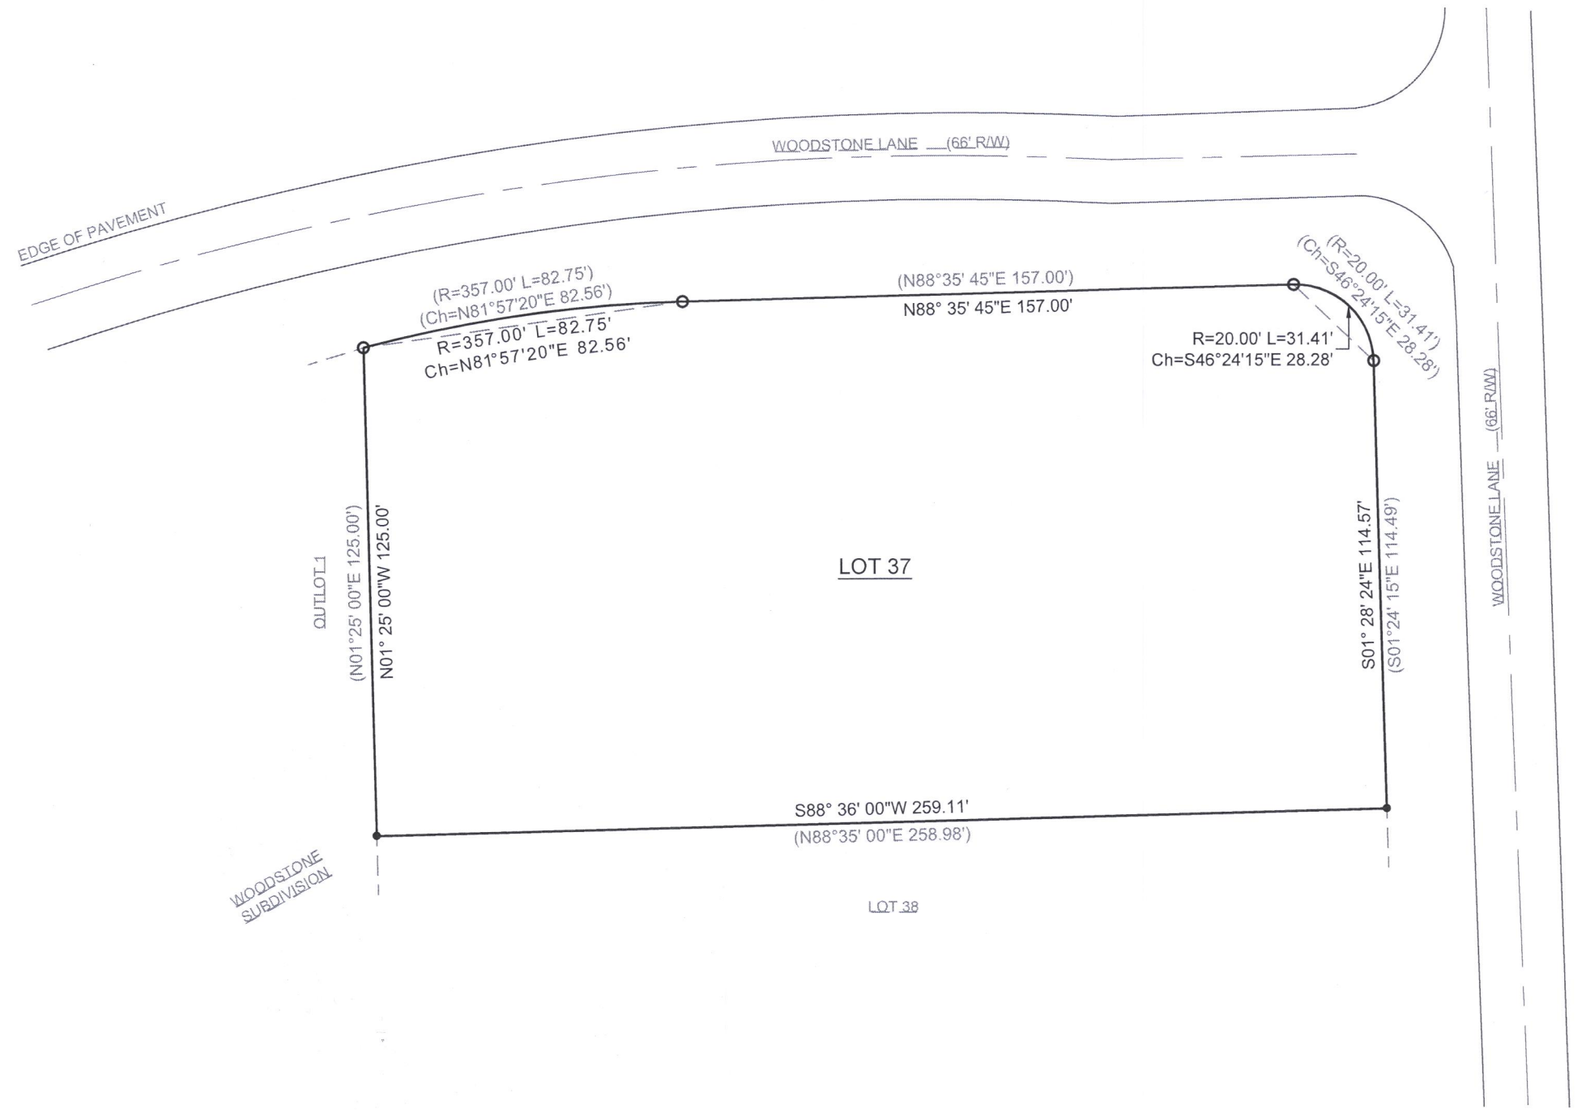


LEGEND

- ● FOUND IRON ROD
- ○ SET 1" IRON PIPE
- ( XX ) RECORDED AS

NOTE:
1. BASIS OF BEARING:
THE WISCONSIN STATE PLANE COORDINATE SYSTEM, NAD-83, SOUTH ZONE.

2. FIELD WORK COMPLETED ON:
AUGUST 19, 2021

3. BUILDING SURVEYED TO:
THE EXTERIOR OF SIDING.

4. FIELD CREW CHIEF
RAYMOND MCARDLE

SURVEY ORDERED BY:
MARGARET CANFIELD

PROPERTY ADDRESS:
LOT 37
WOODSTONE SUBDIVISION
TOWN OF LINN

SURVEYOR:
PAUL H. VAN HENKELUM, PLS
CARDINAL ENGINEERING LLC

WISCONSIN
PAUL H. VAN HENKELUM
S-1931
LAKE GENEVA, WI
LAND SURVEYOR
9/2/2021

*"I HEREBY CERTIFY THAT I HAVE SURVEYED THE ABOVE DESCRIBED PROPERTY AND THE MAP IS A TRUE AND CORRECT REPRESENTATION OF ITS EXTERIOR BOUNDARIES AND SHOWS THE SIZE AND LOCATION OF ALL VISIBLE STRUCTURES, APPARENT EASEMENTS AND ENCROACHMENTS, IF ANY."*

*PAUL H VAN HENKELUM, PLS #1931* *DATE* 9/2/2021

CARDINAL ENGINEERING LLC
DESIGNING IN TRUE DIRECTIONS

PO BOX 281 - 1200 LA SALLE ST.
LAKE GENEVA, WI 53147
262-757-8776
CARDINALENGINEERINGWI.COM

DATE: 09 / 02 / 2021
SHEET 1 OF 1

JOB No. 21473
LWG

IWO-37

117-4557