PLAT OF SURVEY

LEGAL DESCRIPTION:
A PARCEL OF LAND LOCATED IN THE SOUTHWEST 1/4 OF THE NORTHWEST 1/4 OF SECTION 14 IN TOWNSHIP 1 NORTH, RANGE 17 EAST, IN THE TOWN OF LINN, WALWORTH COUNTY, WISCONSIN.


MORE PARTICULARLY DESCRIBED AS:
LOTS 23 AND 24 BLOCK 6; LOTS 27 AND 28 BLOCK 6; LOTS 31 AND 32 BLOCK 6 OF ROBINSON HILLSIDE DESCRIBED IN DOCUMENT NO. P263699 PER THE WALWORTH COUNTY REGISTER OF DEEDS.

N

0 30 60 Feet

SCALE: 1" = 30'

LEGEND
- EXISTING BUILDING
- EXISTING DECK
- EXISTING CONCRETE
- EXISTING GRAVEL
- EXISTING DECK
- XB EXISTING WIRE FENCE
- FOUND 1" IRON PIPE
- (W) EXISTING WELL
- U UTILITY PEDESTAL
- (V) EXISTING 3" VENT
- EXISTING UTILITY POLE

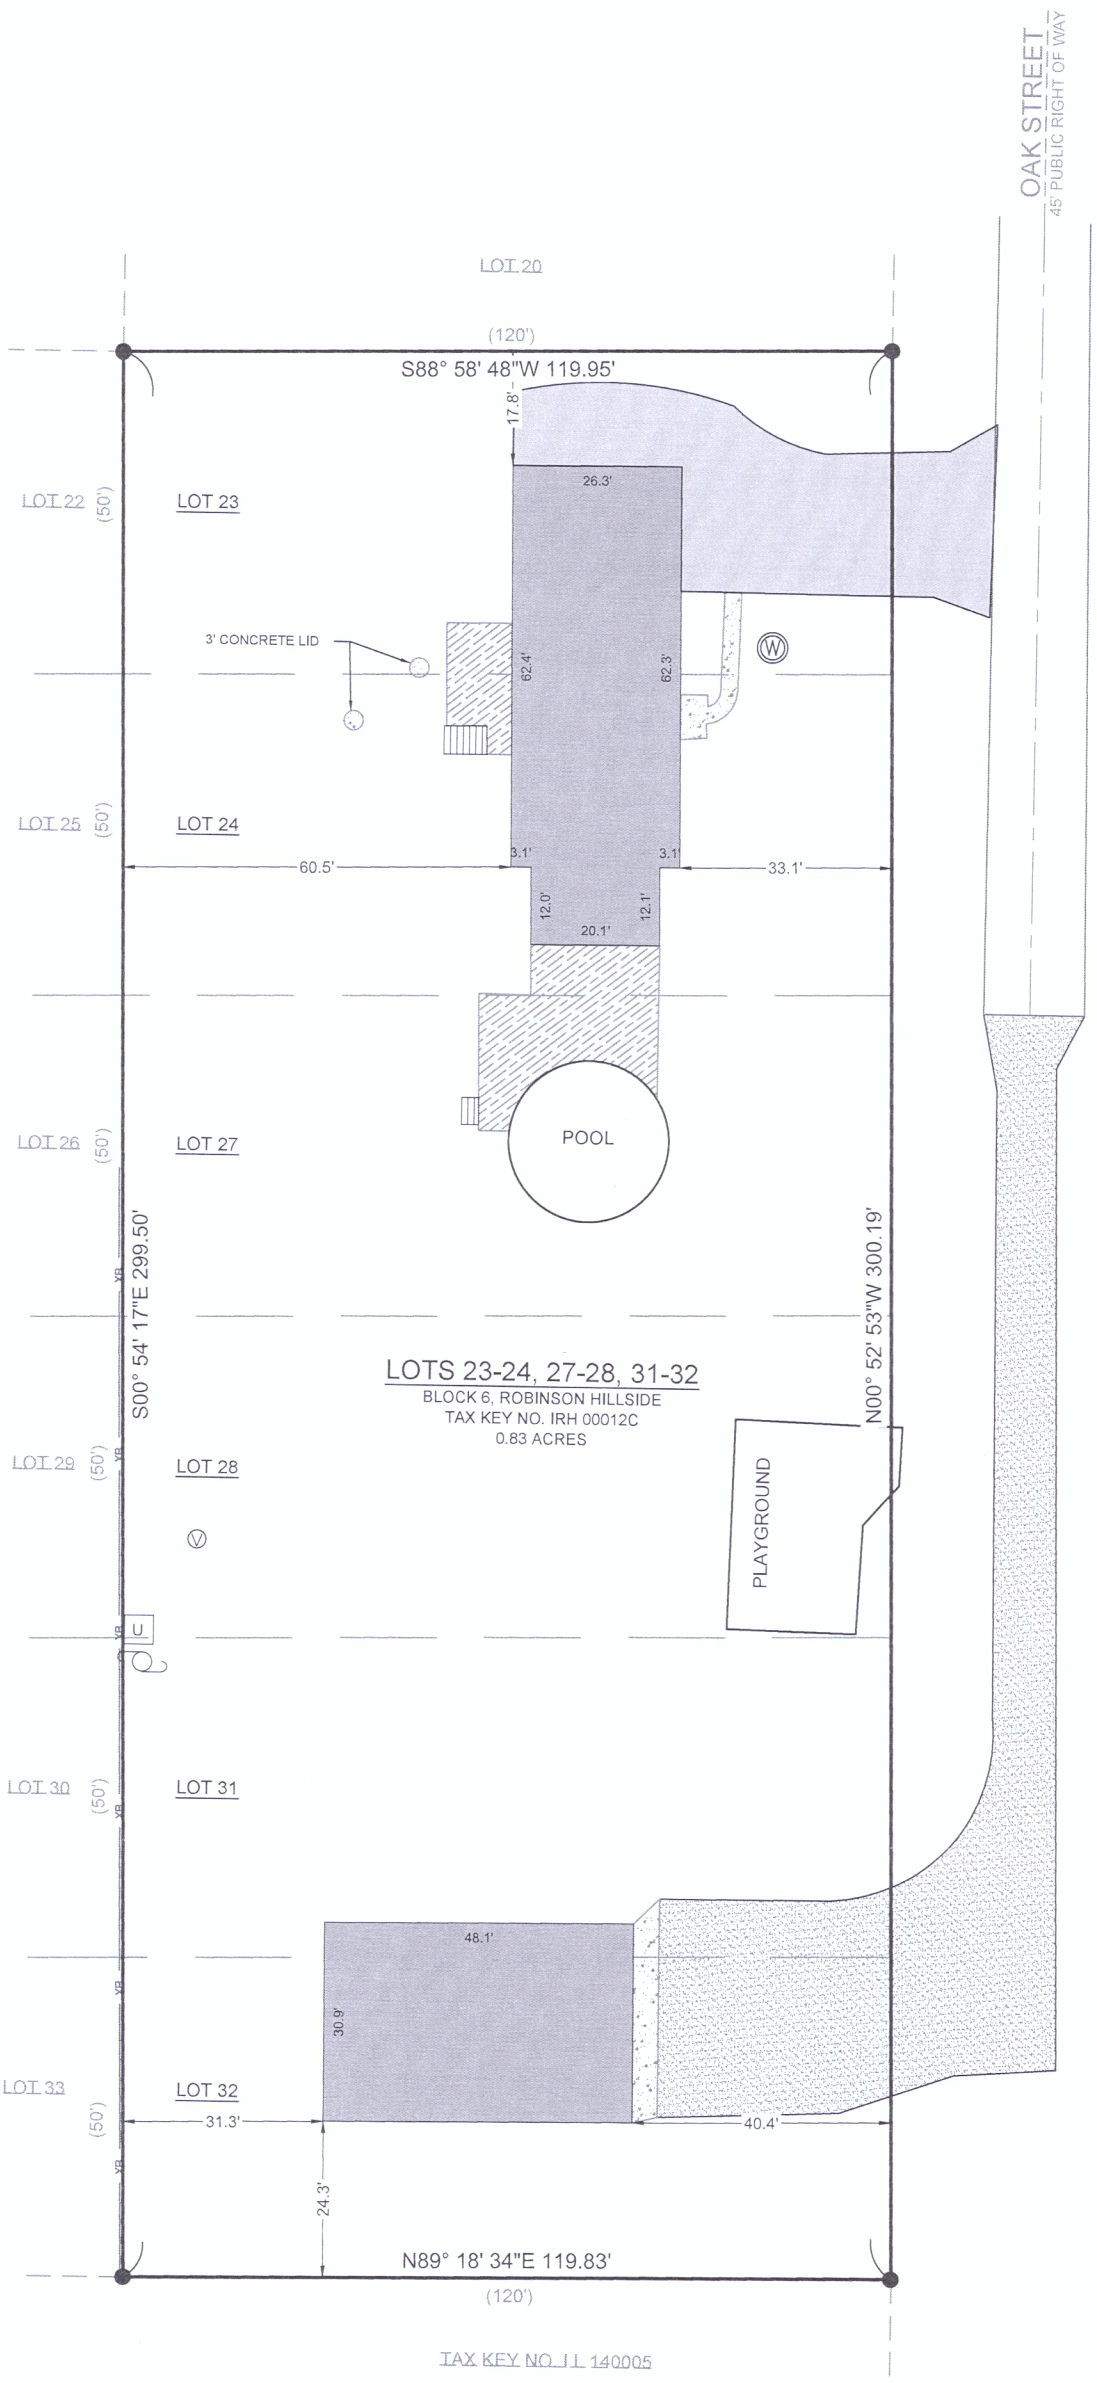

LOTS 23-24, 27-28, 31-32
BLOCK 6, ROBINSON HILLSIDE
TAX KEY NO. IRH 00012C
0.83 ACRES

RECEIVED
OCT 20 2021
By SMF

NOTE:
1. BASIS OF BEARING:
THE WISCONSIN STATE PLANE COORDINATE SYSTEM, NAD-83, SOUTH ZONE.

2. FIELD WORK COMPLETED ON:
OCTOBER 04, 2021

3. BUILDING SURVEYED TO:
THE EXTERIOR OF SIDING.

4. FIELD CREW CHIEF:
RAYMOND MCARDLE

SURVEY ORDERED BY:
PATTI ROHERTY

PROPERTY ADDRESS:
N1531 OAK STREET
LAKE GENEVA WI, 53147

SURVEYOR:
PAUL H. VAN HENKELUM, PLS
CARDINAL ENGINEERING LLC

WISCONSIN
PAUL H. VAN HENKELUM
S-1931
LAKE GENEVA, WI
LAND SURVEYOR

"I HEREBY CERTIFY THAT I HAVE SURVEYED THE ABOVE DESCRIBED PROPERTY AND THE MAP IS A TRUE AND CORRECT REPRESENTATION OF ITS EXTERIOR BOUNDARIES AND SHOWS THE SIZE AND LOCATION OF ALL VISIBLE STRUCTURES, APPARENT EASEMENTS AND ENCROACHMENTS, IF ANY.

PAUL H VAN HENKELUM, PLS #1931 *DATE* 10/15/2021

CARDINAL ENGINEERING LLC
DESIGNING IN TRUE DIRECTIONS
PO BOX 281 - 1200 LA SALLE ST.
LAKE GENEVA, WI 53147
262-757-8776
CARDINALENGINEERINGWI.COM

DATE: 10 / 15 / 2021 JOB No. 21513
SHEET 1 0F 1 LWG

PLOTTED: 10/15/2021 8:59:12 AM

IRH-12C

117-4567