
FARRIS, HANSEN & ASSOCIATES, INC.

ENGINEERING – ARCHITECTURE – SURVEYING
7 RIDGWAY COURT – P.O. BOX 437 – ELKHORN, WISCONSIN 53121
PHONE: (262) 723-2098 FAX: (262) 723-5886

PLAT OF SURVEY

LOT 4 OF BLOCK 1 OF FOREST REST, A SUBDIVISION
LOCATED IN THE NE 1/4 OF THE NW 1/4
OF SECTION 2, TOWN 1 NORTH, RANGE 17 EAST,
TOWN OF LINN, WALWORTH COUNTY, WISCONSIN

– WORK ORDERED BY –
PATTY PETERSEN
N2431 FOREST REST LANE
LAKE GENEVA, WI 53147

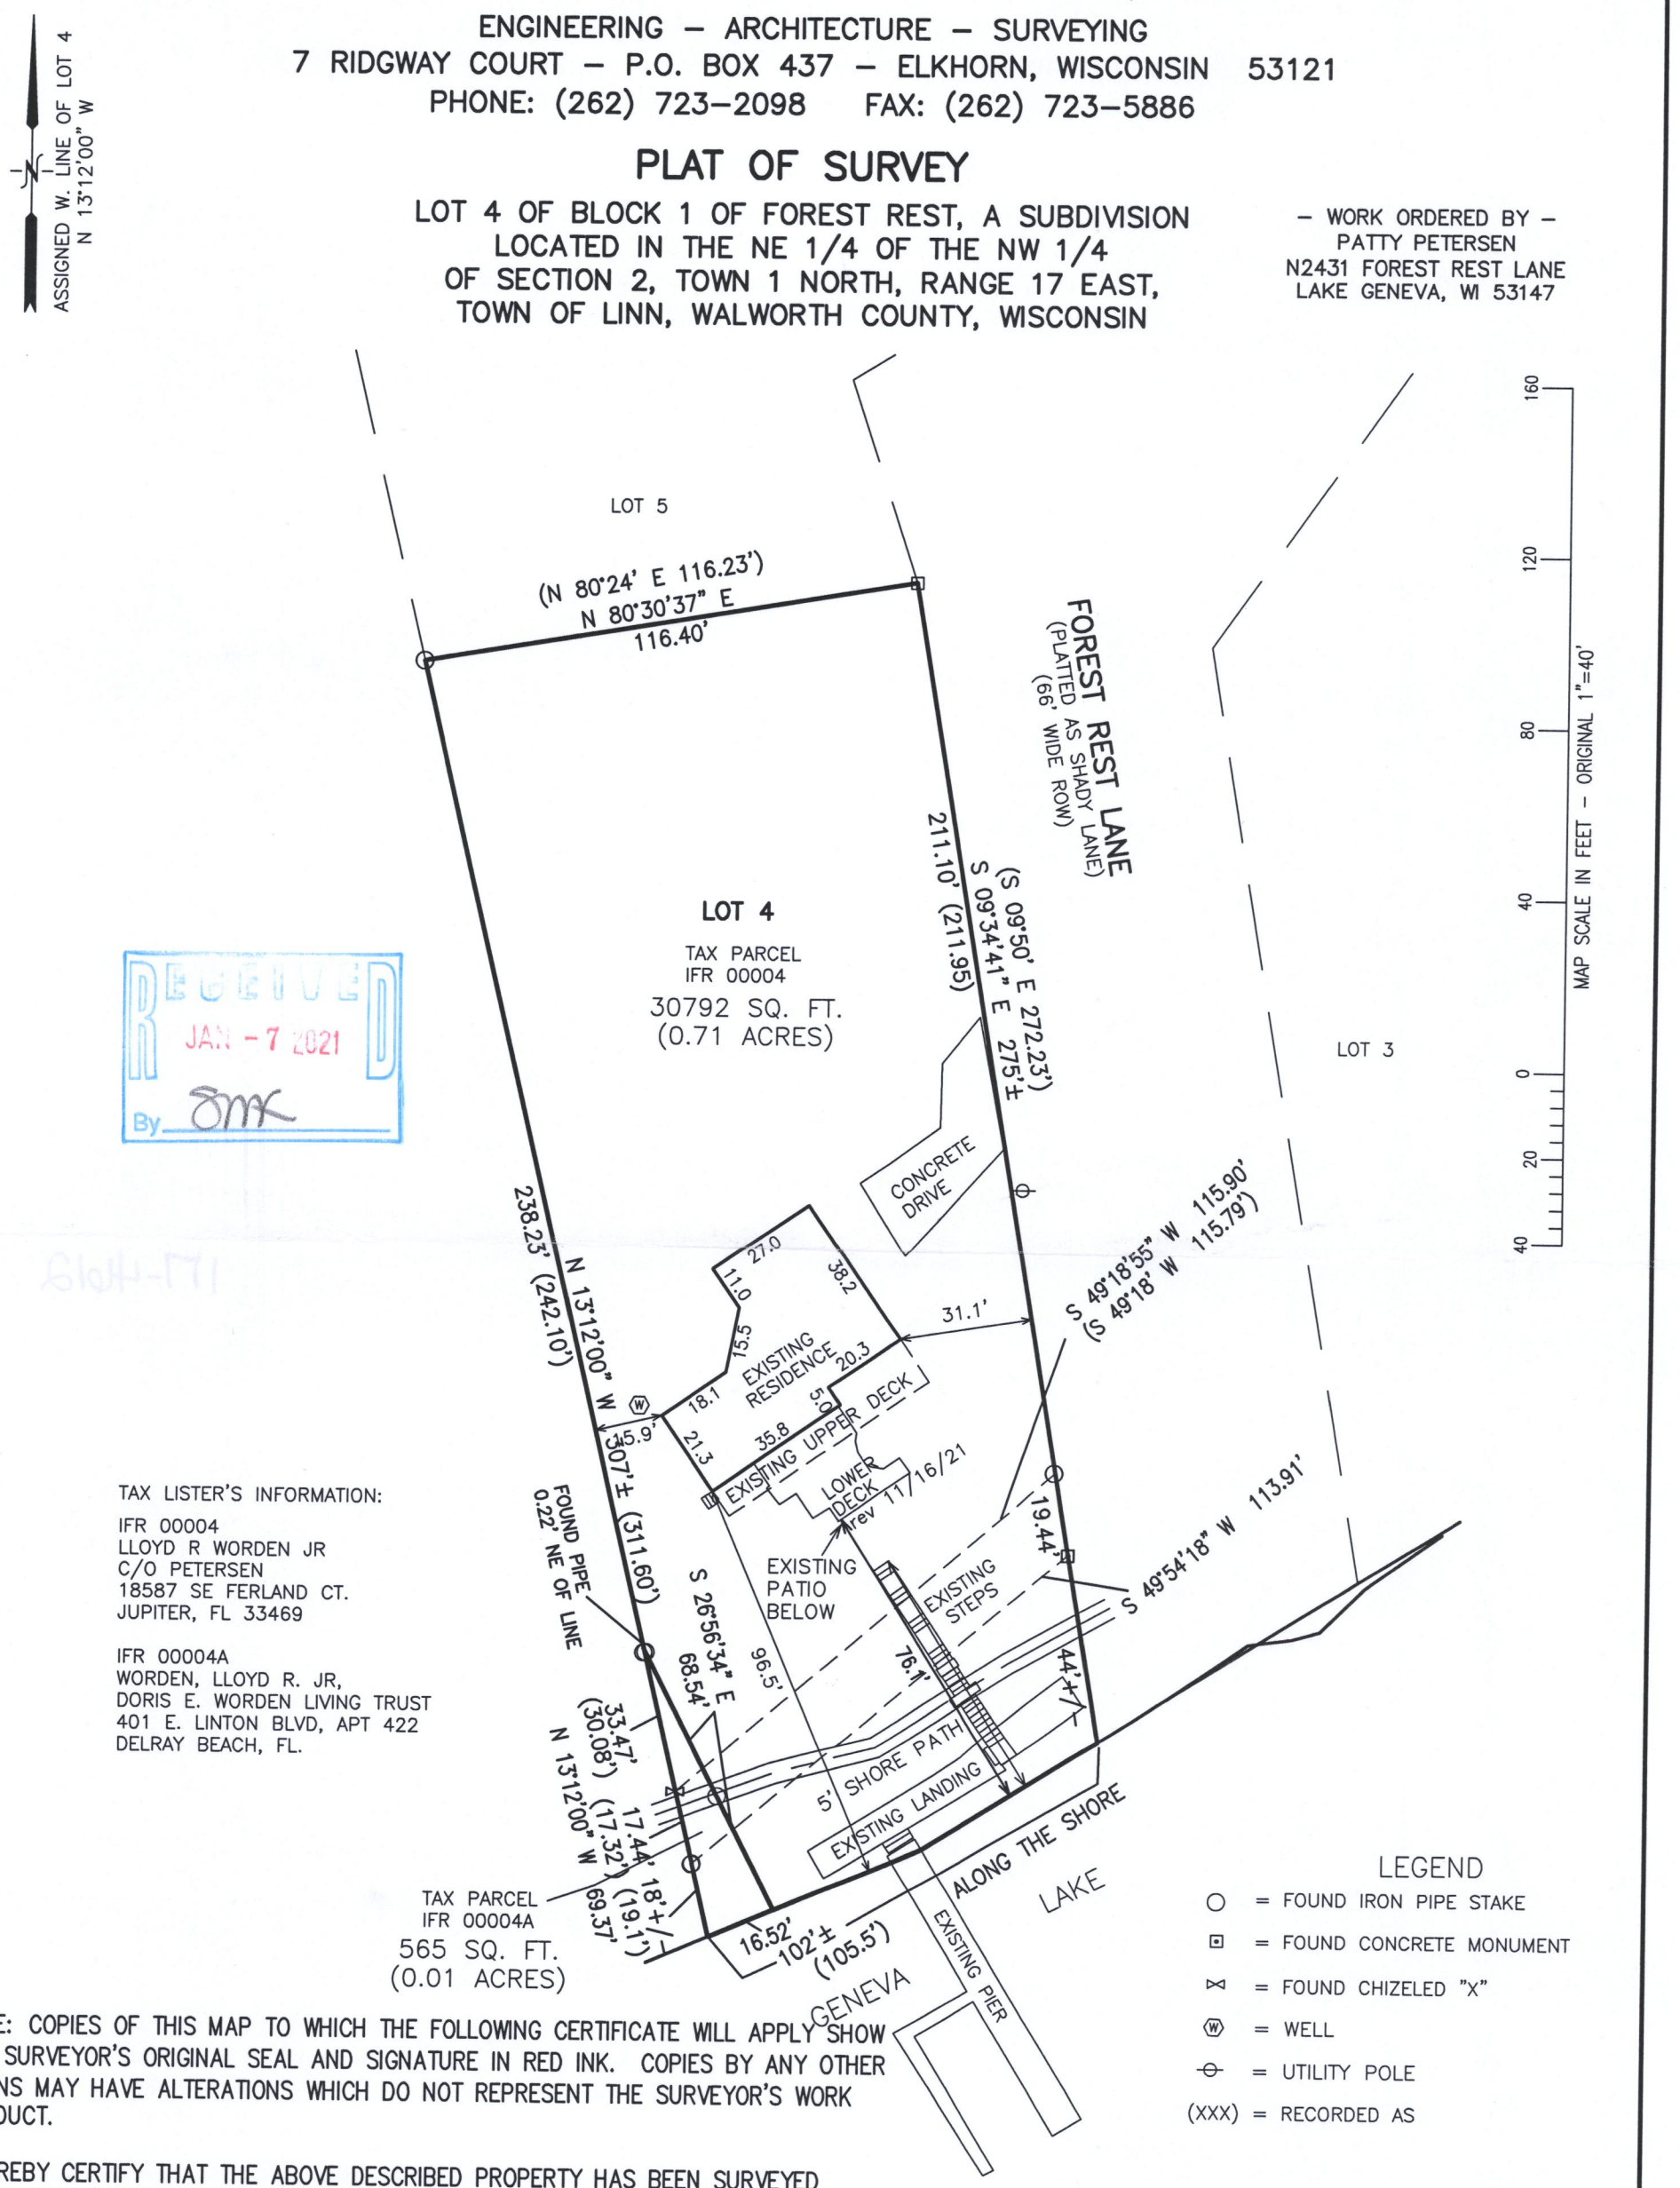

RECEIVED
JAN - 7 2021
By

TAX LISTER'S INFORMATION:

IFR 00004
LLOYD R WORDEN JR
C/O PETERSEN
18587 SE FERLAND CT.
JUPITER, FL 33469

IFR 00004A
WORDEN, LLOYD R. JR,
DORIS E. WORDEN LIVING TRUST
401 E. LINTON BLVD, APT 422
DELRAY BEACH, FL.

LEGEND

- ○ = FOUND IRON PIPE STAKE
- ⊡ = FOUND CONCRETE MONUMENT
- ⋈ = FOUND CHIZELED "X"
- Ⓦ = WELL
- ⊖ = UTILITY POLE
- (XXX) = RECORDED AS

NOTE: COPIES OF THIS MAP TO WHICH THE FOLLOWING CERTIFICATE WILL APPLY SHOW THE SURVEYOR'S ORIGINAL SEAL AND SIGNATURE IN RED INK. COPIES BY ANY OTHER MEANS MAY HAVE ALTERATIONS WHICH DO NOT REPRESENT THE SURVEYOR'S WORK PRODUCT.

I HEREBY CERTIFY THAT THE ABOVE DESCRIBED PROPERTY HAS BEEN SURVEYED UNDER MY DIRECTION AND THAT THE ABOVE MAP IS A TRUE REPRESENTATION THEREOF AND SHOWS THE SIZE AND LOCATION OF THE PROPERTY AND ITS EXTERIOR BOUNDARIES. THIS SURVEY IS MADE FOR THE USE OF THE PRESENT OWNERS OF THE PROPERTY, AND ALSO THOSE WHO PURCHASE, MORTGAGE, OR GUARANTEE THE TITLE THERETO WITHIN ONE YEAR FROM THE DATE HEREOF.

DATED: 10/12/2017

CHRISTOPHER A. HODGES P.L.S. 2760

REVISED 06/27/2018 TO CLARIFY EXISTING VERSUS NEW IMPROVEMENTS BETWEEN 10/10/2014 AND 10/12/2017 SURVEY.
REVISED 11/16/21 FOR REVISED DECK.

WISCONSIN
CHRISTOPHER A HODGES
2760
PALMYRA
WIS.
LAND SURVEYOR

PROJECT: 9156.17
DATE: 10/10/2014
SHEET 1 OF 1

X:\PROJECTS\9156\9156_17\ACAD\9156_17.DWG

IFR-4 IFR-4A

117-4612