
# PLAT OF SURVEY
## LOT 1 OF CERTIFIED SURVEY MAP NO. 2013

LOCATED IN PART OF THE SE 1/4 OF THE SE 1/4 OF SECTION 31, TOWN 1 NORTH, RANGE 17 EAST,
TOWN OF LINN, WALWORTH COUNTY, WISCONSIN

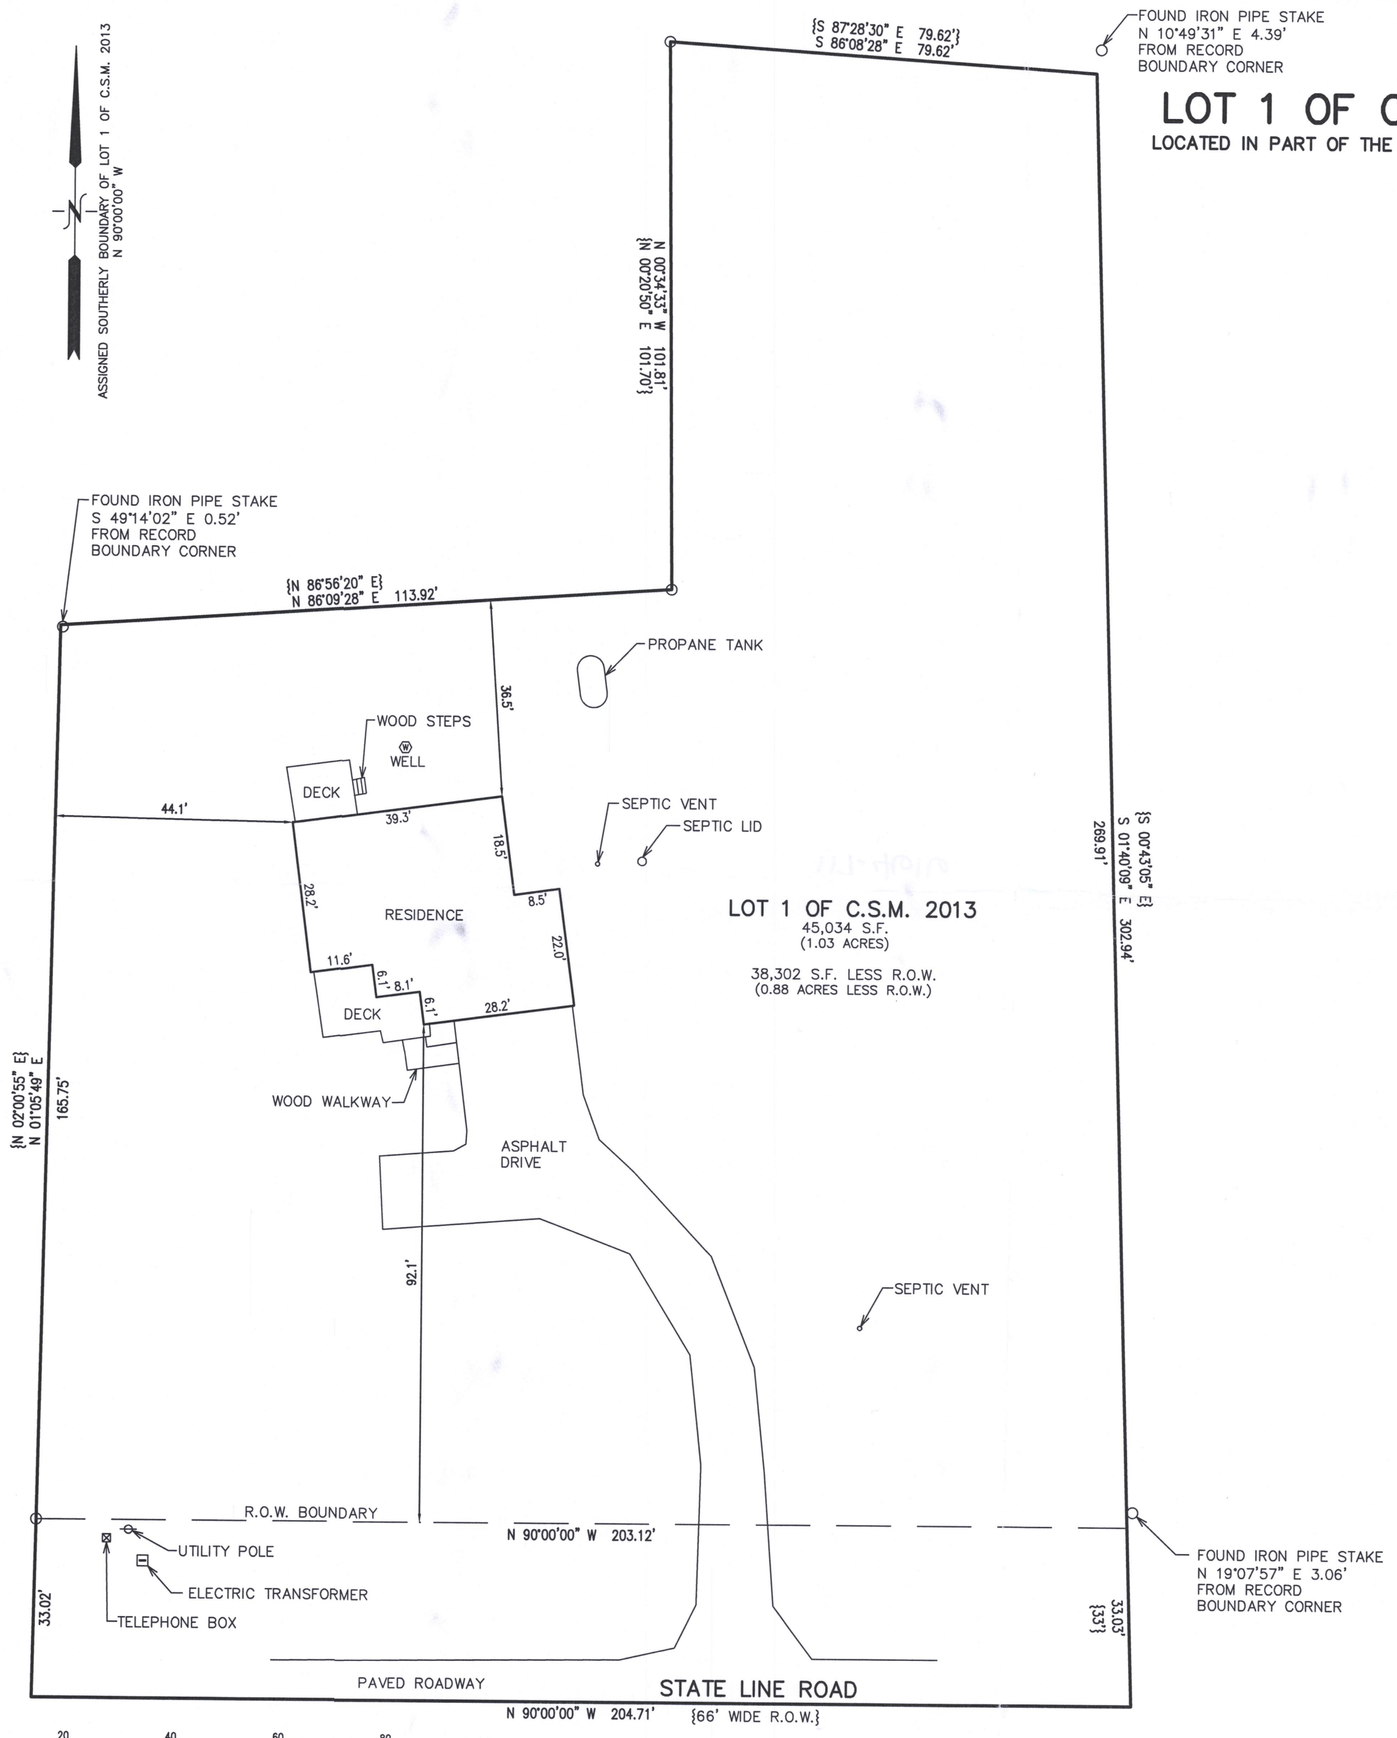


RECEIVED
JAN 13 2022
By SMK

WISCONSIN
CHRISTOPHER A HODGES
2760
PALMYRA
WIS.
LAND SURVEYOR

NOTE: COPIES OF THIS MAP TO WHICH THE FOLLOWING CERTIFICATE WILL APPLY SHOW THE SURVEYOR'S ORIGINAL SEAL AND SIGNATURE IN RED INK. COPIES BY ANY OTHER MEANS MAY HAVE ALTERATIONS WHICH DO NOT REPRESENT THE SURVEYOR'S WORK PRODUCT.

I HEREBY CERTIFY THAT THE ABOVE DESCRIBED PROPERTY HAS BEEN SURVEYED UNDER MY DIRECTION AND THAT THE ABOVE MAP IS A TRUE REPRESENTATION THEREOF AND SHOWS THE SIZE AND LOCATION OF THE PROPERTY AND ITS EXTERIOR BOUNDARIES. THIS SURVEY IS MADE FOR THE USE OF THE PRESENT OWNERS OF THE PROPERTY, AND ALSO THOSE WHO PURCHASE, MORTGAGE, OR GUARANTEE THE TITLE THERETO WITHIN ONE YEAR FROM THE DATE HEREOF.

DATED: 01/03/2022

CHRISTOPHER A. HODGES P.L.S. 2760

PLAT OF SURVEY
W4560 STATE LINE ROAD
WALWORTH, WISCONSIN 53184

– WORK ORDERED BY –
LINDA LEYDEN
301 WILLOW LANE
GENEVA, ILLINOIS 60134


FARRIS, HANSEN & ASSOCIATES, INC.
ENGINEERING – ARCHITECTURE – SURVEYING
7 RIDGWAY COURT P.O. BOX 437
ELKHORN, WISCONSIN 53121
OFFICE: (262) 723-2098 FAX: (262) 723-5886


REVISIONS

PROJECT NO. 10493
DATE: 01/03/2022
SHEET NO. 1 OF 1

X:\Projects\10493\ACAD\10493.dwg

JA2013-1

117.4616