
PLAT OF SURVEY
LOT 5 OF HIGHFIELD GLEN CONSERVANCY
PART OF THE NW 1/4 OF THE SW 1/4 OF SECTION 31, TOWN 1 NORTH, RANGE 17 EAST
TOWN OF LINN, WALWORTH COUNTY, WISCONSIN

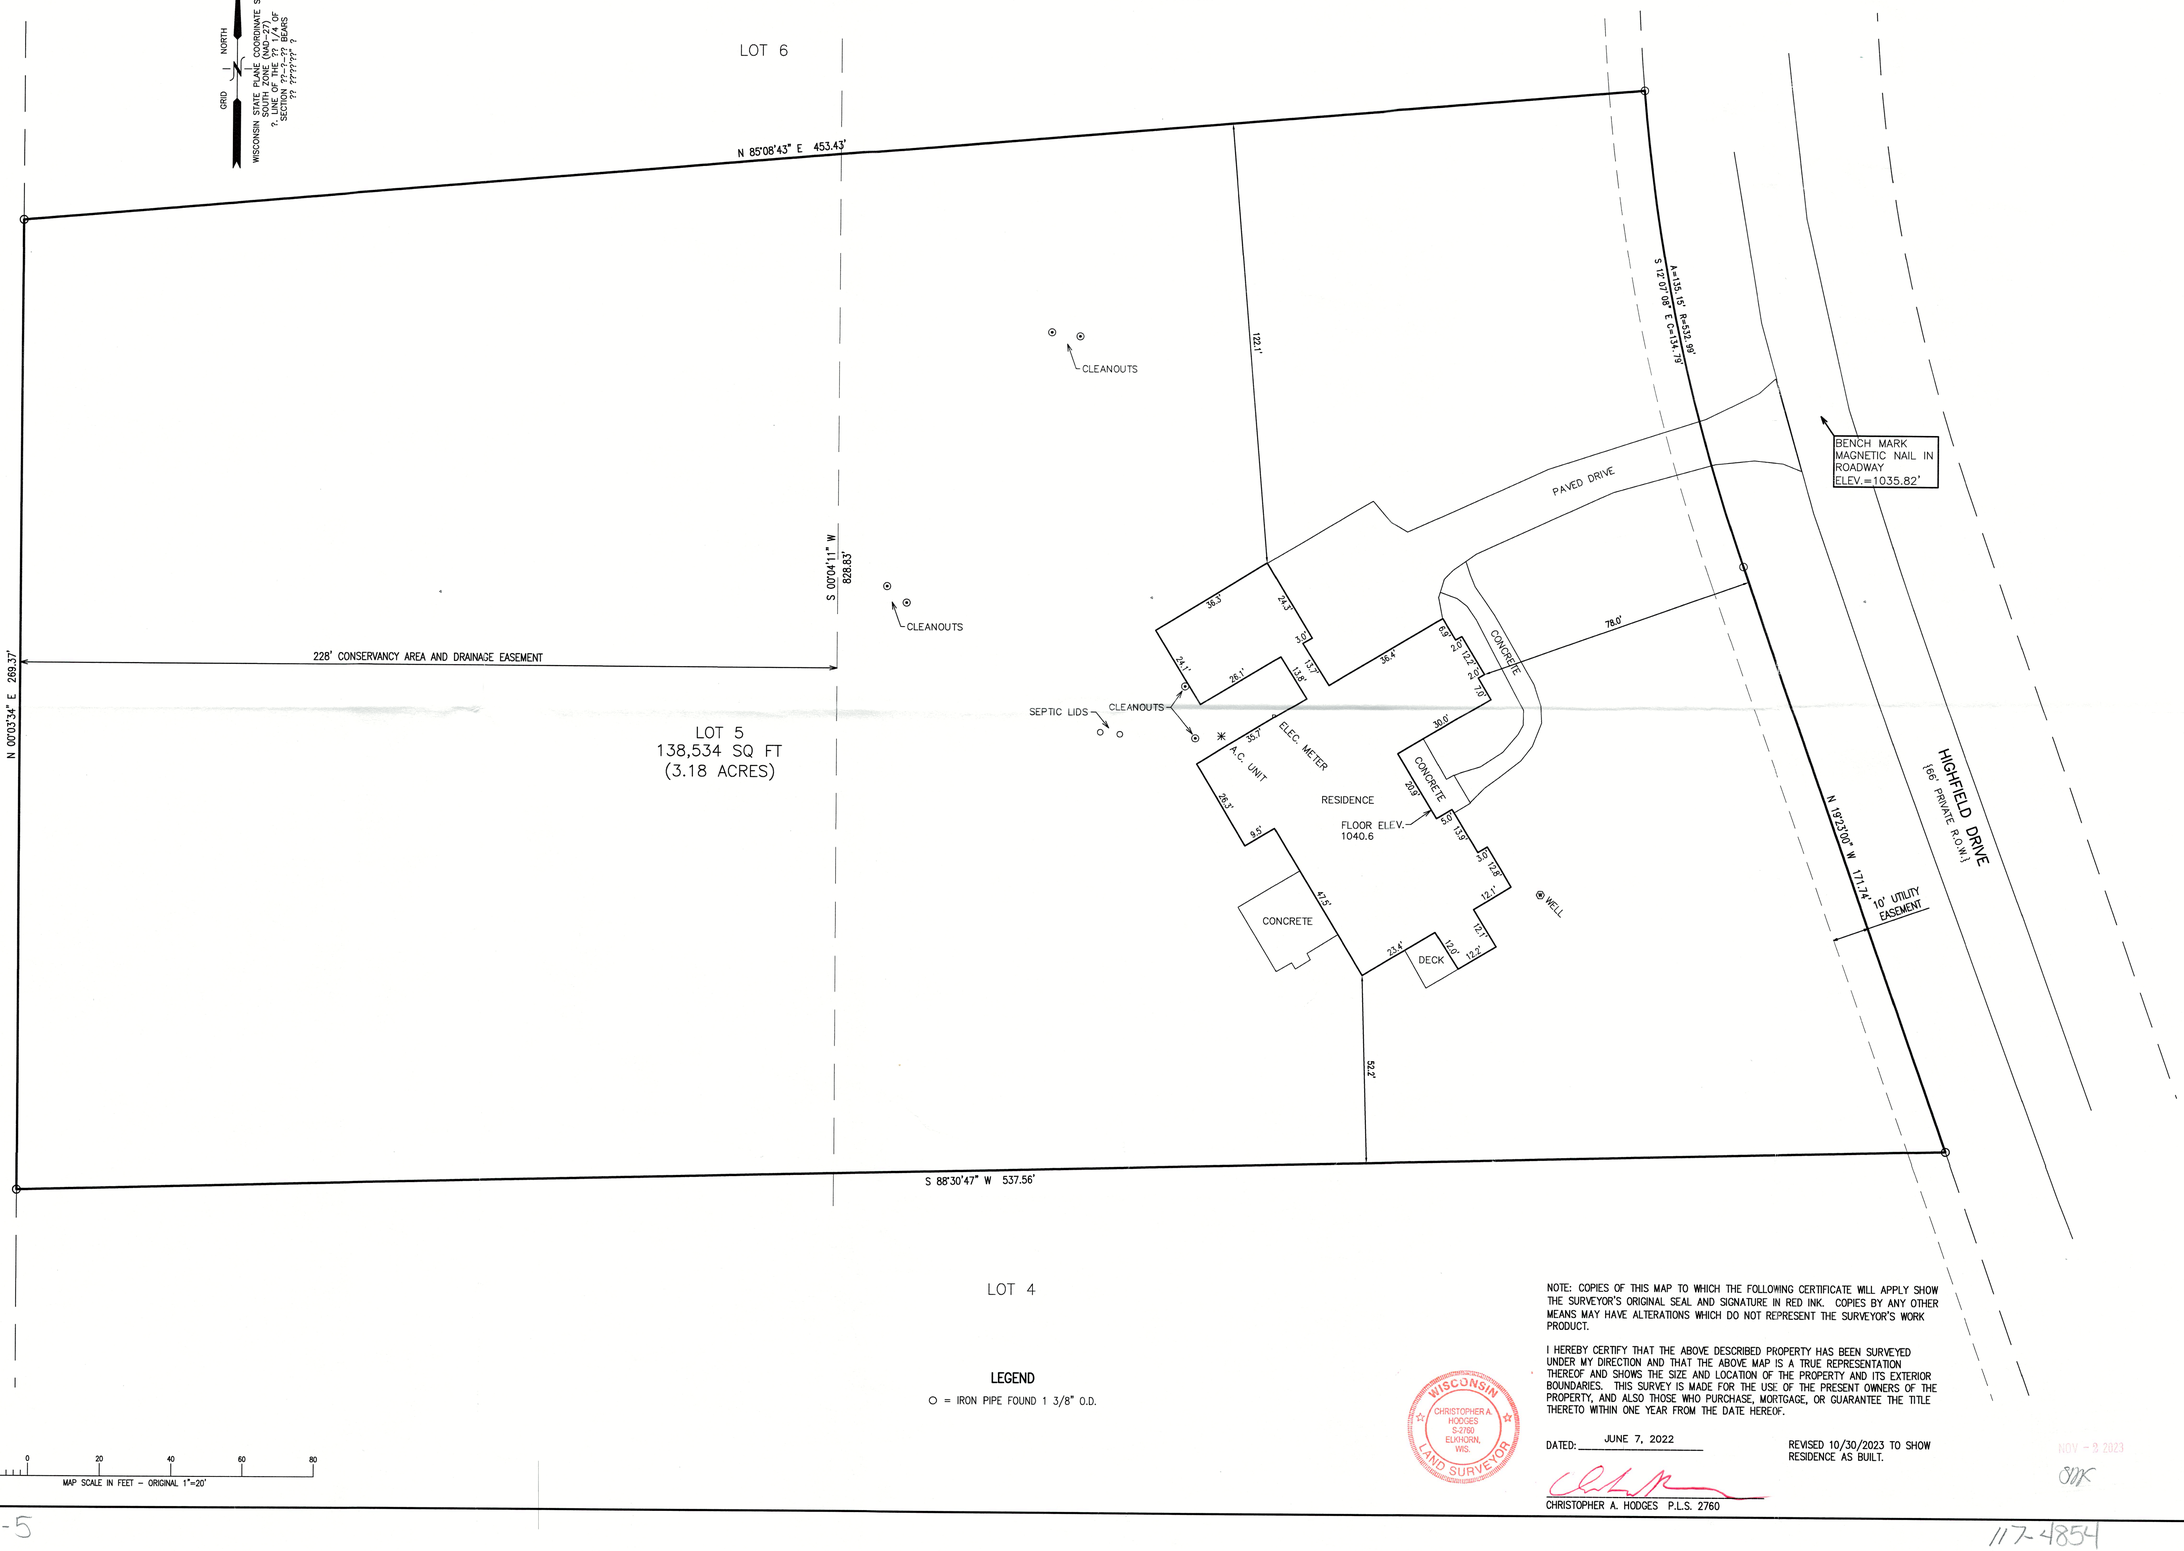

LEGEND

○ = IRON PIPE FOUND 1 3/8" O.D.

NOTE: COPIES OF THIS MAP TO WHICH THE FOLLOWING CERTIFICATE WILL APPLY SHOW THE SURVEYOR'S ORIGINAL SEAL AND SIGNATURE IN RED INK. COPIES BY ANY OTHER MEANS MAY HAVE ALTERATIONS WHICH DO NOT REPRESENT THE SURVEYOR'S WORK PRODUCT.

I HEREBY CERTIFY THAT THE ABOVE DESCRIBED PROPERTY HAS BEEN SURVEYED UNDER MY DIRECTION AND THAT THE ABOVE MAP IS A TRUE REPRESENTATION THEREOF AND SHOWS THE SIZE AND LOCATION OF THE PROPERTY AND ITS EXTERIOR BOUNDARIES. THIS SURVEY IS MADE FOR THE USE OF THE PRESENT OWNERS OF THE PROPERTY, AND ALSO THOSE WHO PURCHASE, MORTGAGE, OR GUARANTEE THE TITLE THERETO WITHIN ONE YEAR FROM THE DATE HEREOF.

WISCONSIN CHRISTOPHER A. HODGES S-2760 ELKHORN, WIS. LAND SURVEYOR

DATED: JUNE 7, 2022

REVISED 10/30/2023 TO SHOW RESIDENCE AS BUILT.

NOV – 9 2023

CHRISTOPHER A. HODGES P.L.S. 2760

PARCEL# IHGC 00005

PLAT OF SURVEY

LOT 5 HIGHFIELD GLEN CONSERVANCY
HIGHFIELD DRIVE, TOWN OF LINN

– WORK ORDERED BY –
LOWELL CUSTOM HOMES
401 GENEVA NATIONAL AVENUE SOUTH
LAKE GENEVA, WI 53147

FARRIS, HANSEN & ASSOCIATES, INC.
ENGINEERING – ARCHITECTURE – SURVEYING
7 RIDGWAY COURT P.O. BOX 437
ELKHORN, WISCONSIN 53121
OFFICE: (262) 723-2098 FAX: (262) 723-5886

REVISIONS

PROJECT NO.
5708.05.22

DATE
10/30/2023

SHEET NO.
1 OF 1

X:\Projects\5708\NDIV_LOTS\Lot_5\5708_05_22\ACAD\5708_05_22 As Built.dwg

IHEC-5

117-4854