
Plat of Survey

of

Lot 19 of Camp Sybil,

a subdivision recorded July 31, 1915 in Vol. 6 of Plats of Walworth County on Page 149 as Document Number 205249 and located in Government Lot 2 in the Northeast 1/4 of Section 18, Town 1 North, Range 17 East, Town of Linn, Walworth County, Wisconsin.

Surveyed for: **Randy Lathrop**
P.O. Box 288
Fontana, Wisconsin. 53125

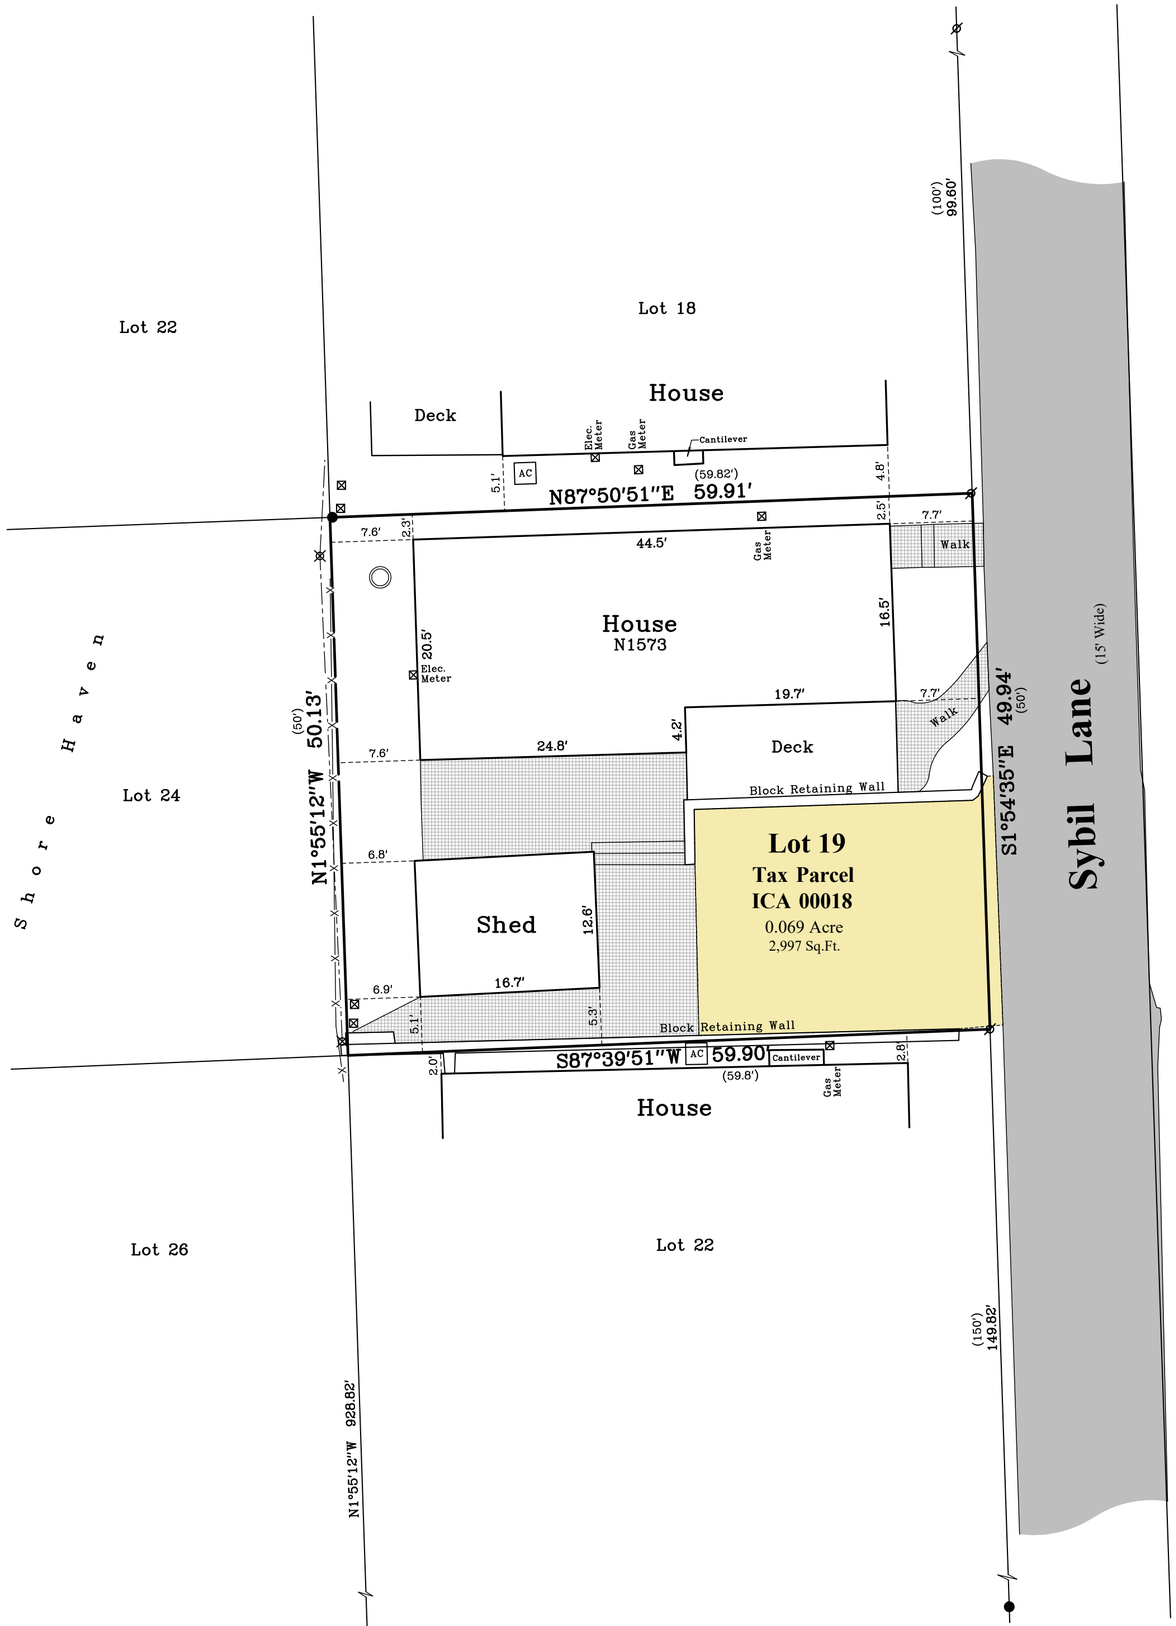

Bearings referenced to the straight line between the Center 1/4 corner and the East 1/4 corner of Section 18-1-17, recorded as N89°30'42"E in the Wisconsin State Plane Coordinate System, South Zone, (NAD-27).

Coordinates are referenced to the Wisconsin State Plane Coordinate System, South Zone, (NAD-27).

WISCONSIN
DOUGLAS OLSON
S-2093
ELKHORN, WI
LAND SURVEYOR
Not Certified Unless Stamped in Red.

Notes:

1) This Plat of Survey is not certified unless signed and sealed in red ink.
2) This survey is subject to Wisconsin lien laws. This Plat of Survey is the notice of intent to file lien. Lien waiver required.
3) The Survey Date shown on this Plat of Survey is the completion date of the field work.

Copyright © 2024 by Olson Land Surveying, LLC.

All rights reserved. No part of this survey plat may be reproduced or transmitted in any form by any means - graphic, electronic, or mechanical, including photocopying, tracing, or information storage and retrieval systems - without permission in writing from Douglas G. Olson, Olson Land Surveying, LLC.

I hereby certify that I have surveyed the above described property in compliance with Chapter A-E 7 of the Wisconsin Administrative Code and that the map hereon is correct to the best of my professional knowledge and belief and shows the size and location of the property, its exterior boundaries, the location and dimensions of all visible structures thereon, boundary fences, apparent easements and roadways and visible encroachments, if any.

This survey is made for the exclusive use of the present owners of the property, and also those who purchase, mortgage or guarantee title thereto, within one year from the date hereof.

Douglas G. Olson
Wisconsin Professional Land Surveyor - 2093

Center 1/4 Corner
Section 18-1-17.
N. 202,327.01
E. 2,395,820.88

N89°22'51"E 668.96' | N89°22'51"E 1316.39' | 647.43'

South 1/8 Corner of the Northeast 1/4 of Section 18-1-17.

East 1/4 Corner
Section 18-1-17.
N. 202,349.48
E. 2,398,457.54

N89°30'42"E 2636.84'
recorded as(N89°30'42"E 2636.76')State Plane

Survey Date: October 25, 2024.
Revisions:

Scale in Feet
1" = 10'
0' 5' 10' 20' 30'

OLSON LAND SURVEYING, LLC
Rural | Residential | Commercial
45 South Wisconsin Street | P.O. Box 322
Elkhorn, Wisconsin. 53121
Telephone: (262) 723-3434
Facsimile: (262) 723-8044
Email: doug@olsonsurveying.com
Website: www.olsonsurveying.com

Legend of Symbols & Abbreviations

Found County Section Corner
Found Iron Pipe
Found Iron Rod
Set Iron Pipe, 1" dia.
Recorded Information
Utility Pole
Concrete Cover
Asphalt Surface
Gravel Surface
Brick Pavers

N North
S South
E East
W West
In Bearings
° Degrees
' Minutes
" Seconds
In Distances
' Feet
" Inches

Sheet 1 of 1 Sheets

Drawing Name:

Job Reference Number
2024.106

2024.106