
Lots 9&10 #1465-68

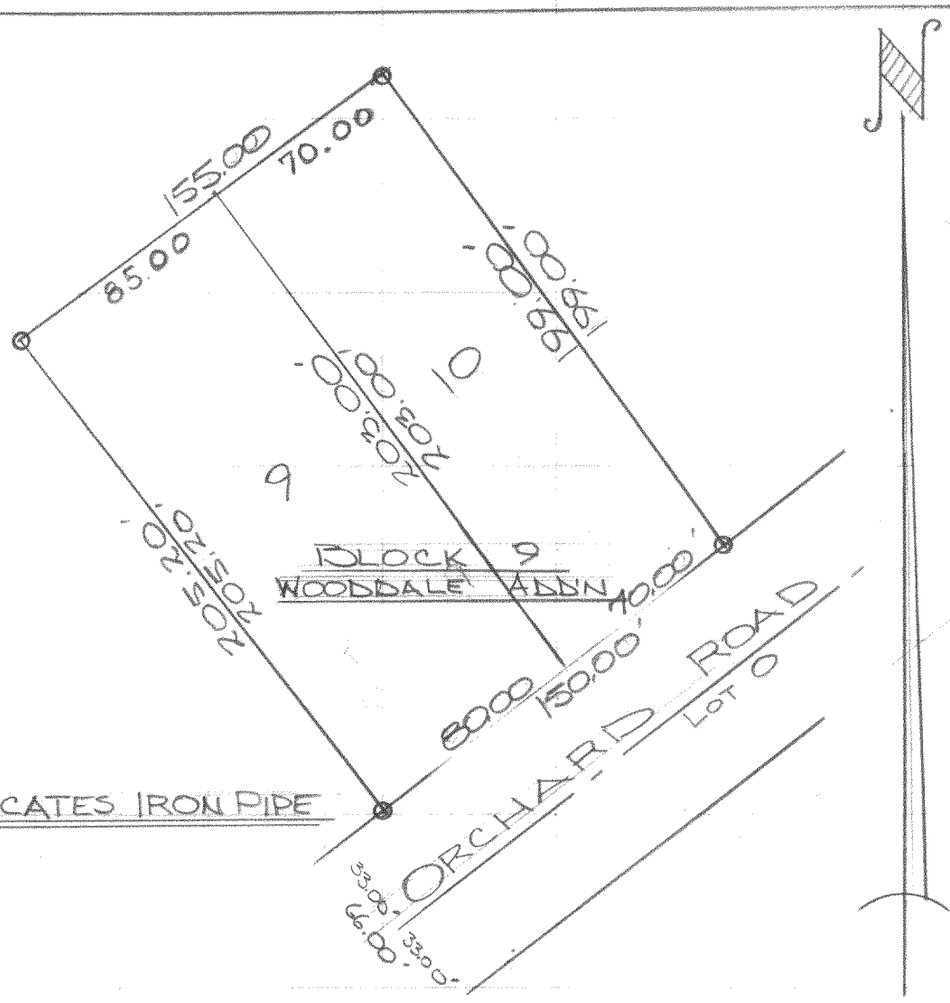

O - INDICATES IRON PIPE

DESCRIPTION: Lots 9 and 10 of Block 9 of Wooddale Addition located in Section 9 of T. 1 N., R. 17 E. Walworth County, Wisconsin.

CERTIFICATE: I, James F. Biagi, surveyor, do hereby certify that I have surveyed the property hereon described.

October 22, 1968.

James F. Biagi

James F. Biagi, R.L.S. 272

WISCONSIN
JAMES F. BIAGI
MILWAUKEE, WIS.
REGISTERED LAND SURVEYOR

IW-58G

117-4B