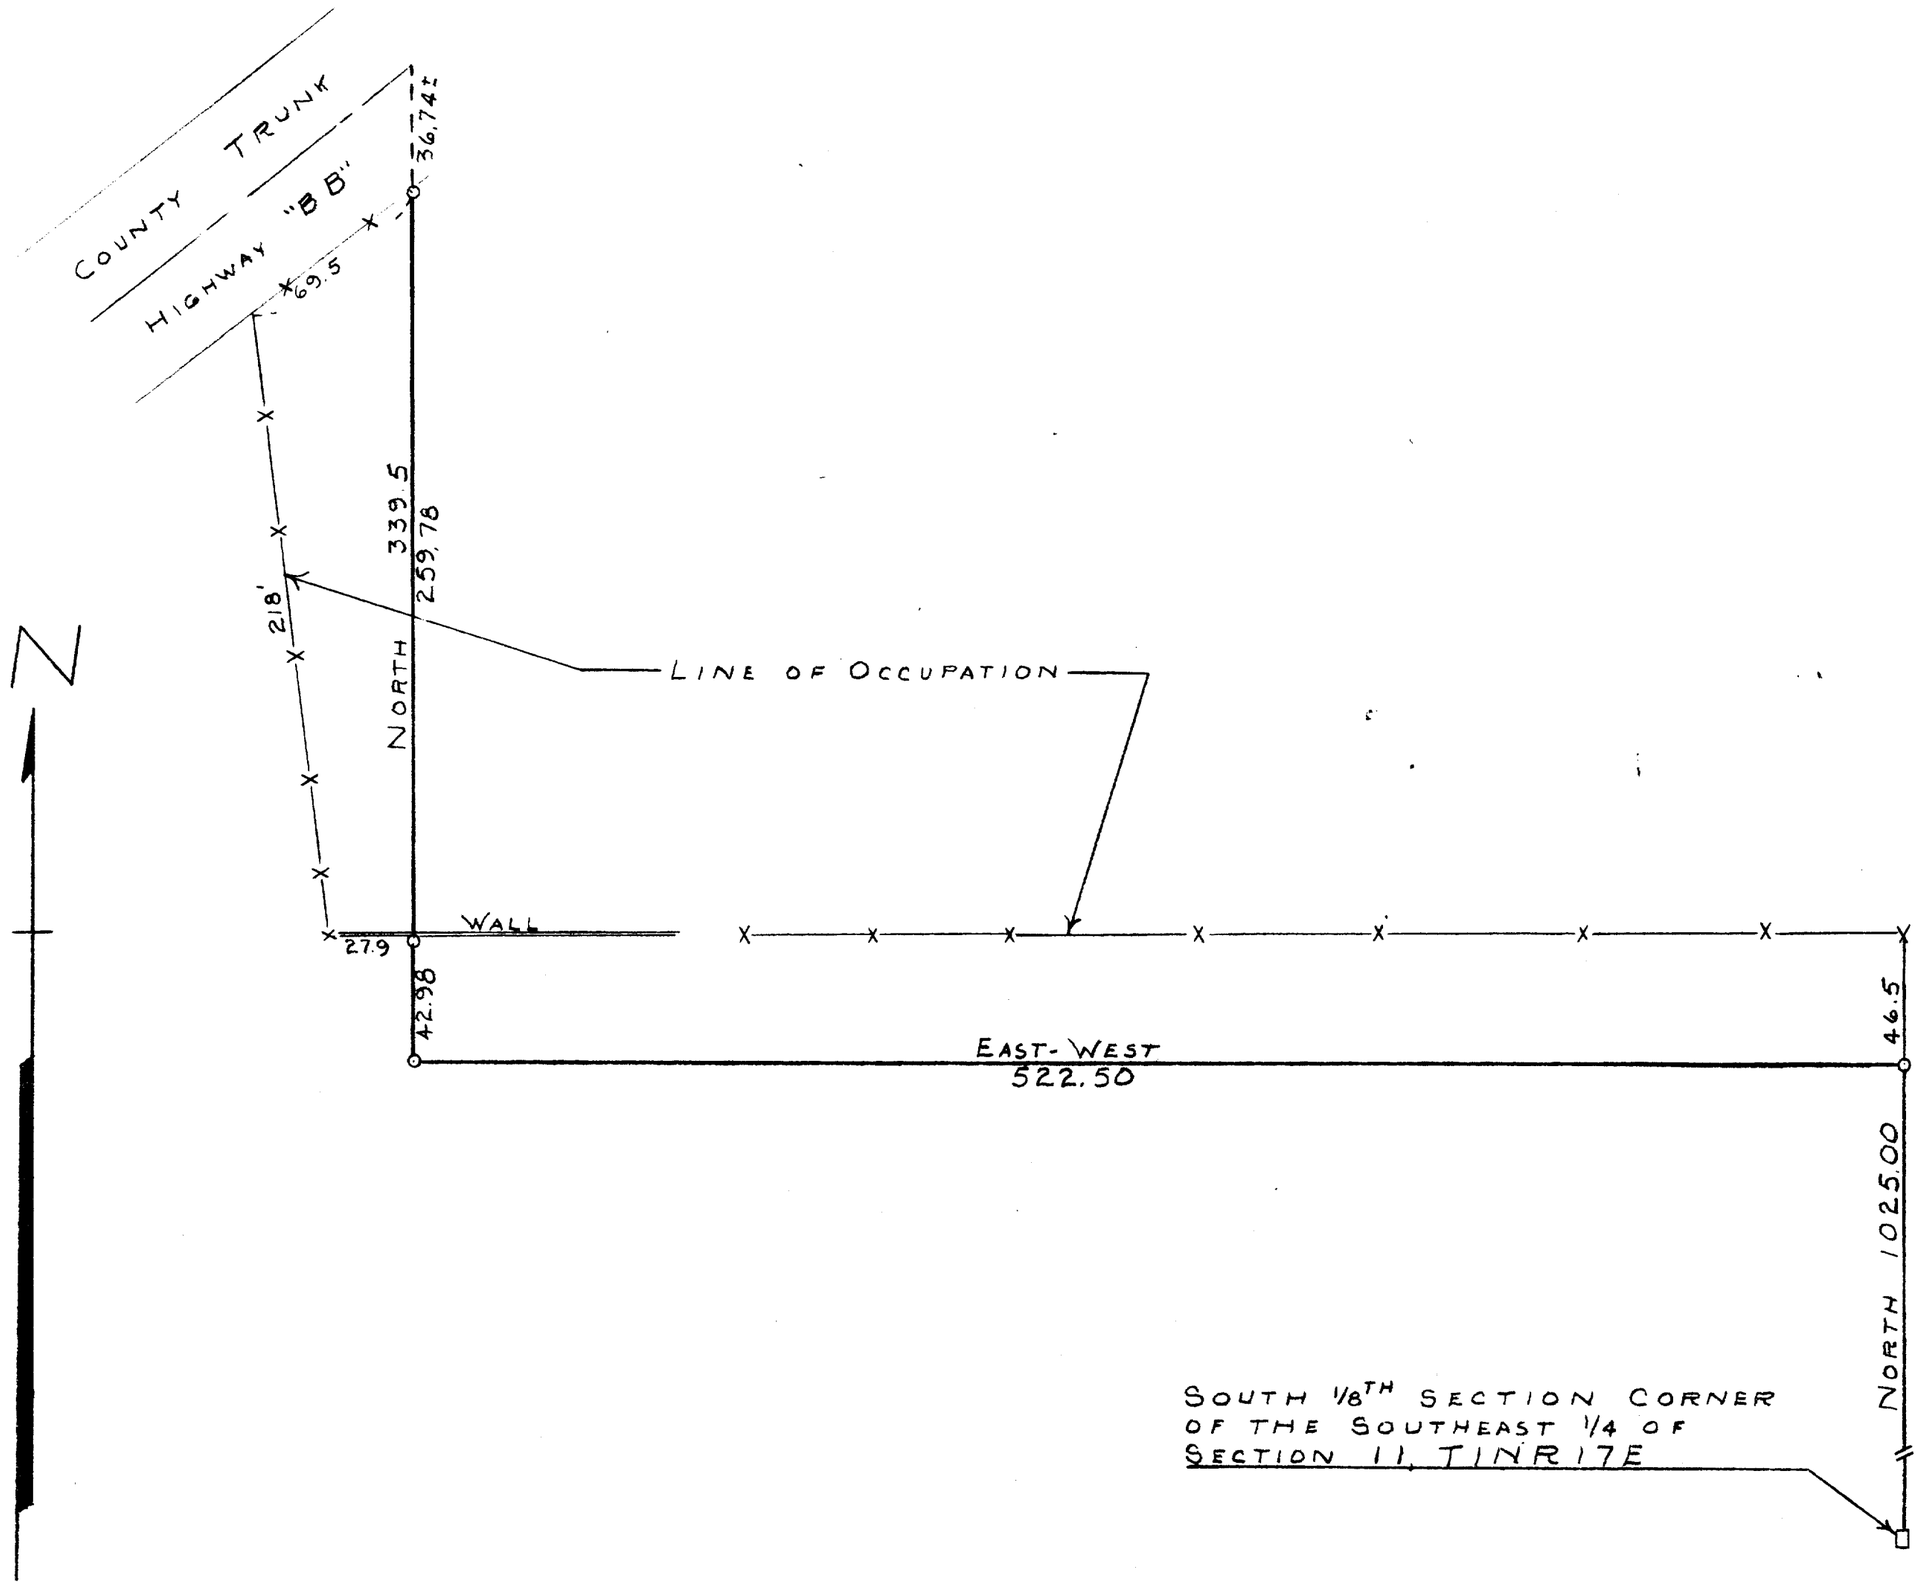


SCALE~ 1"= 50'
O=IRON PIPE
□=STONE MONU
——X=FENCE LINE

PLAT OF SURVEY OF LAND LOCATED IN THE EAST 1/2 OF FRACTIONAL SECTION 11, T1NR17E OF WALWORTH COUNTY, WISCONSIN
OCT. 21, 1954

George T. Dunham
GEORGE T. DUNHAM, SURVEYOR
DELAVAN, WISCONSIN

I.L. 11-12, 11-13A

117-4D